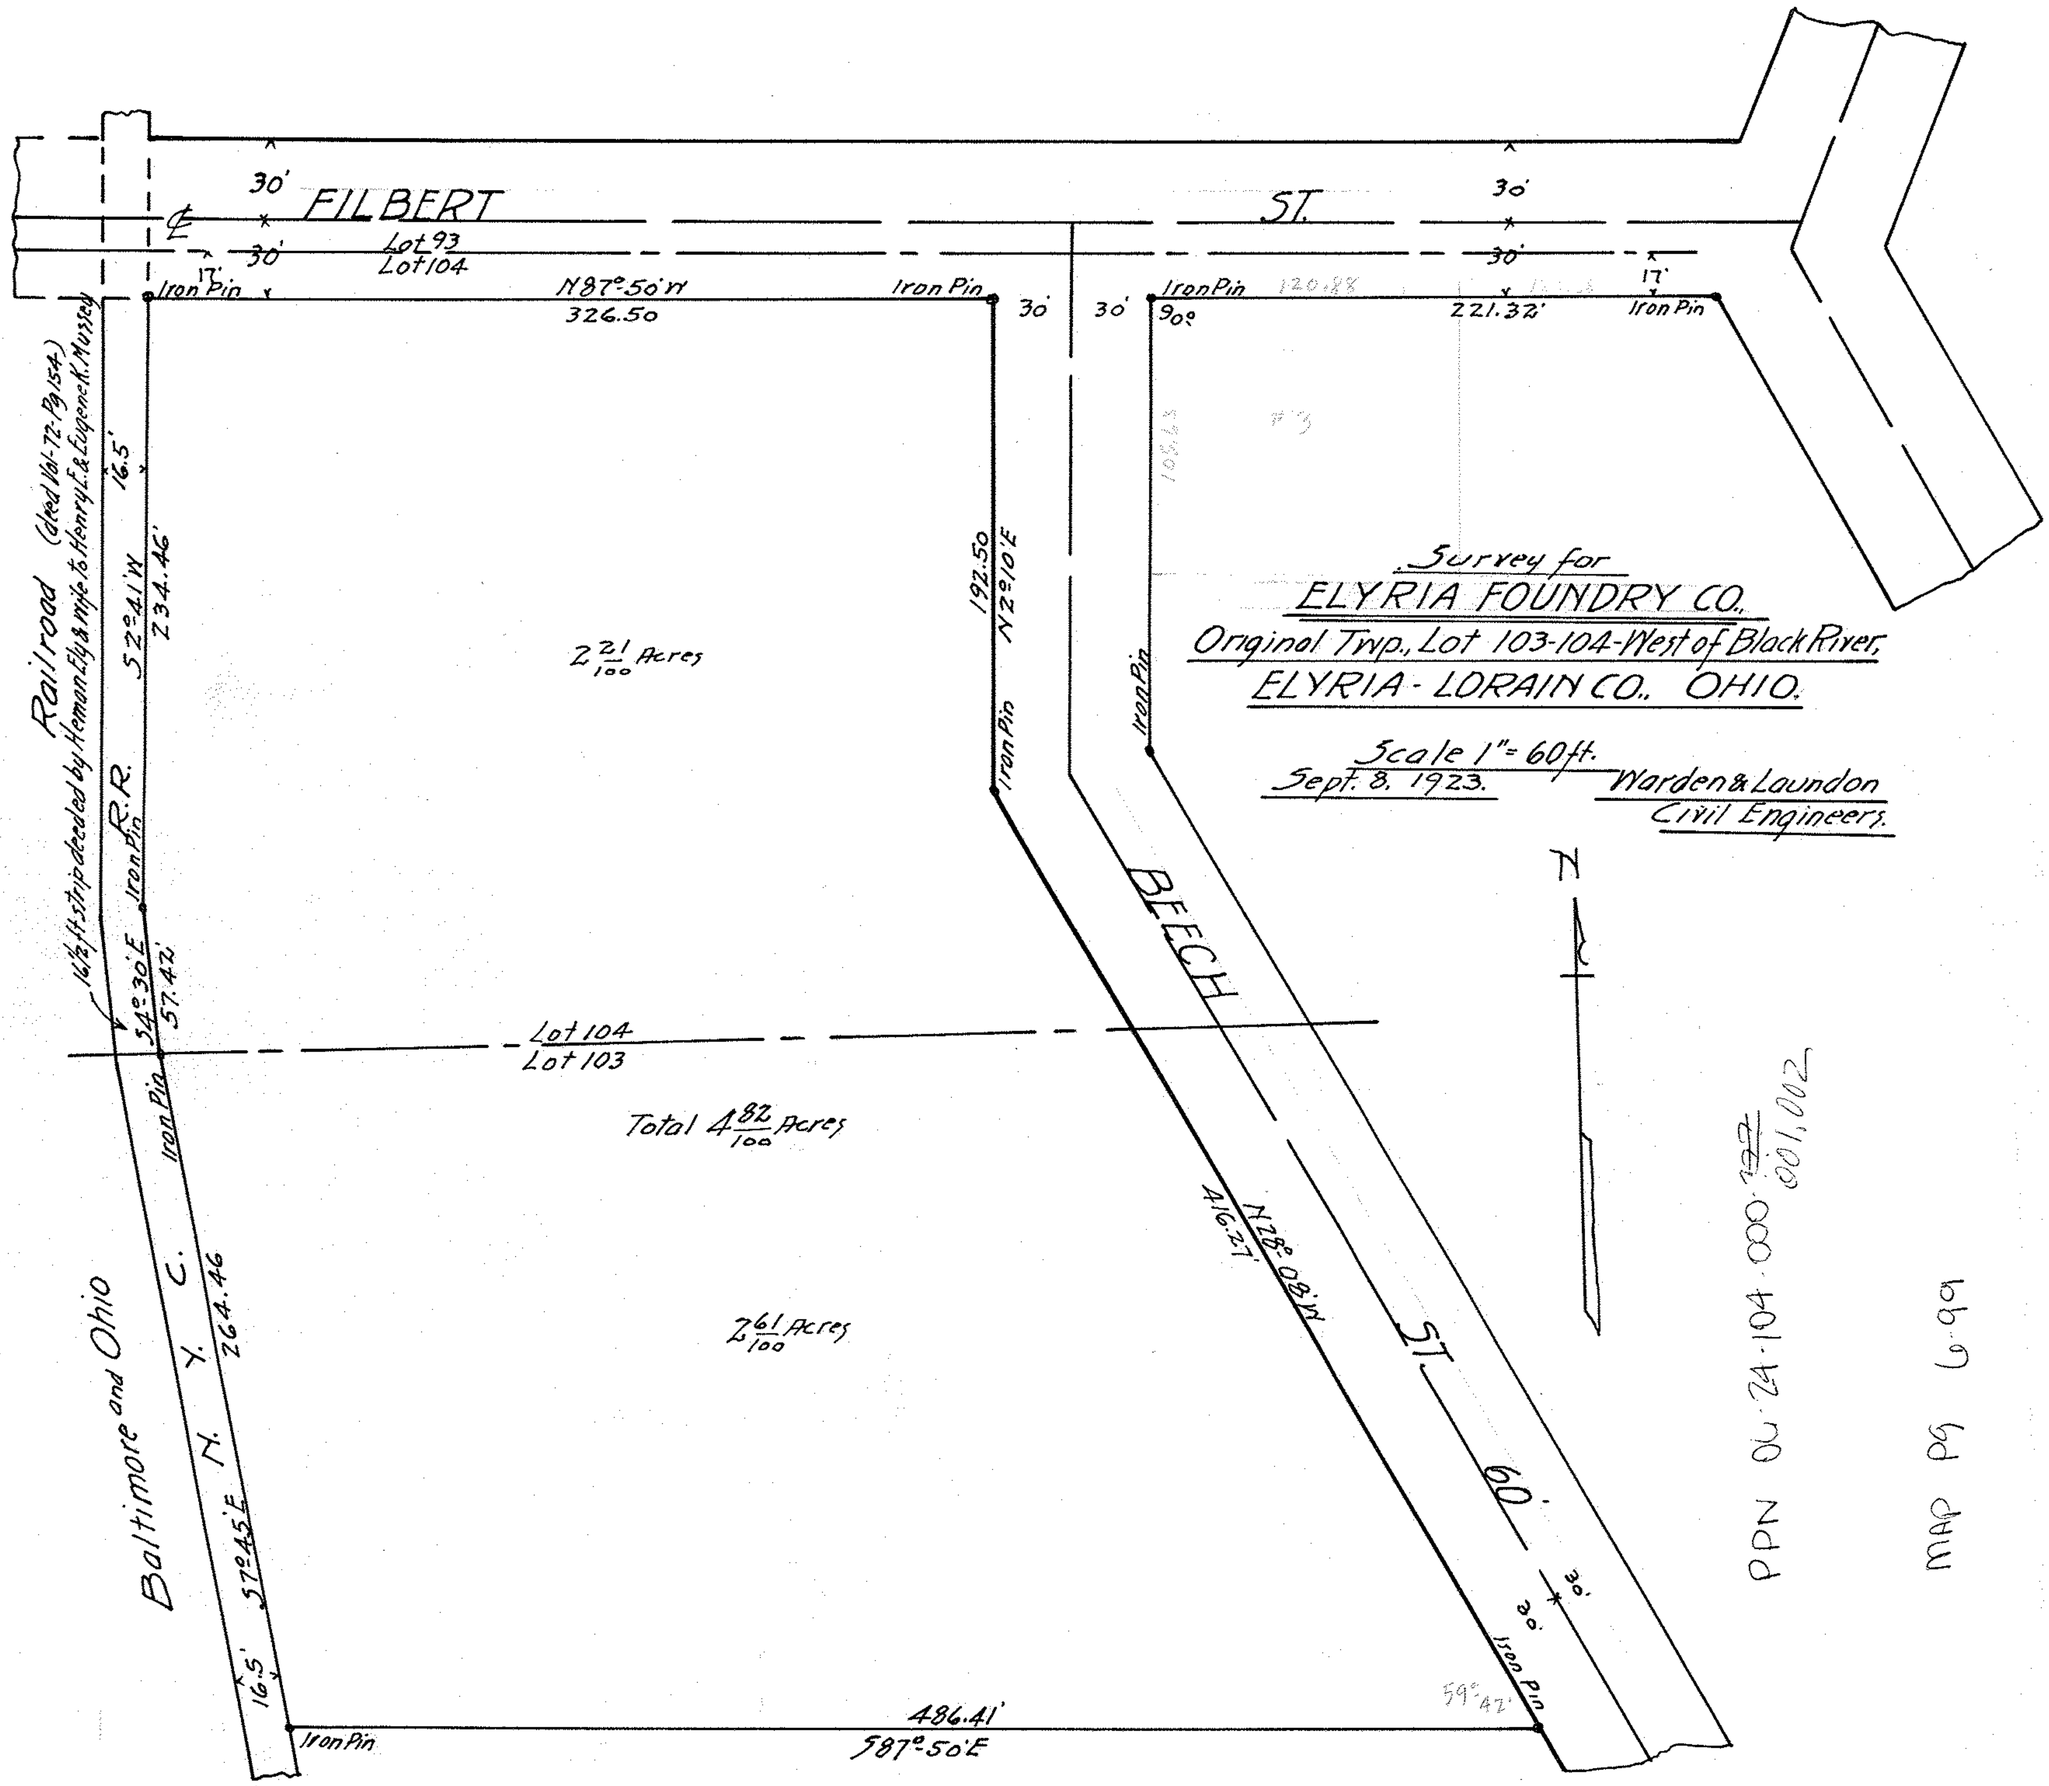
FILBERT ST.
30'
30'
Lot 93
Lot 104
17'
Iron Pin
N87°50'W
326.50
Iron Pin
30'
30'
Iron Pin
90°
221.32'
17'
Iron Pin
Railroad (deed Vol 72 Pg 154)
conveyed by Heman Lily & wife to Henry L. & Eugene K. Mussey
16.5'
S2°41'W
234.46'
R.R.
Iron Pin
16½ ft stripdeeded
S4°30'E
57.42'
Iron Pin
2 21/100 Acres
192.50
N2°10'E
Iron Pin
Iron Pin
BEECH
Lot 104
Lot 103
Total 4 82/100 Acres
2 61/100 Acres
Baltimore and Ohio R. R. Co.
16.5'
S7°45'E
264.46
N28° 08' W
416.27'
ST.
60'
30'
30'
Iron Pin
59°42'
Iron Pin
486.41'
S87°50'E
Survey for
ELYRIA FOUNDRY CO.
Original Twp., Lot 103-104-West of Black River,
ELYRIA - LORAIN CO., OHIO.
Scale 1" = 60 ft.
Sept. 8, 1923.
Warden & Laundon
Civil Engineers.
N
PPN 04-24-104-000 137 001,002
MAP PG 6-99