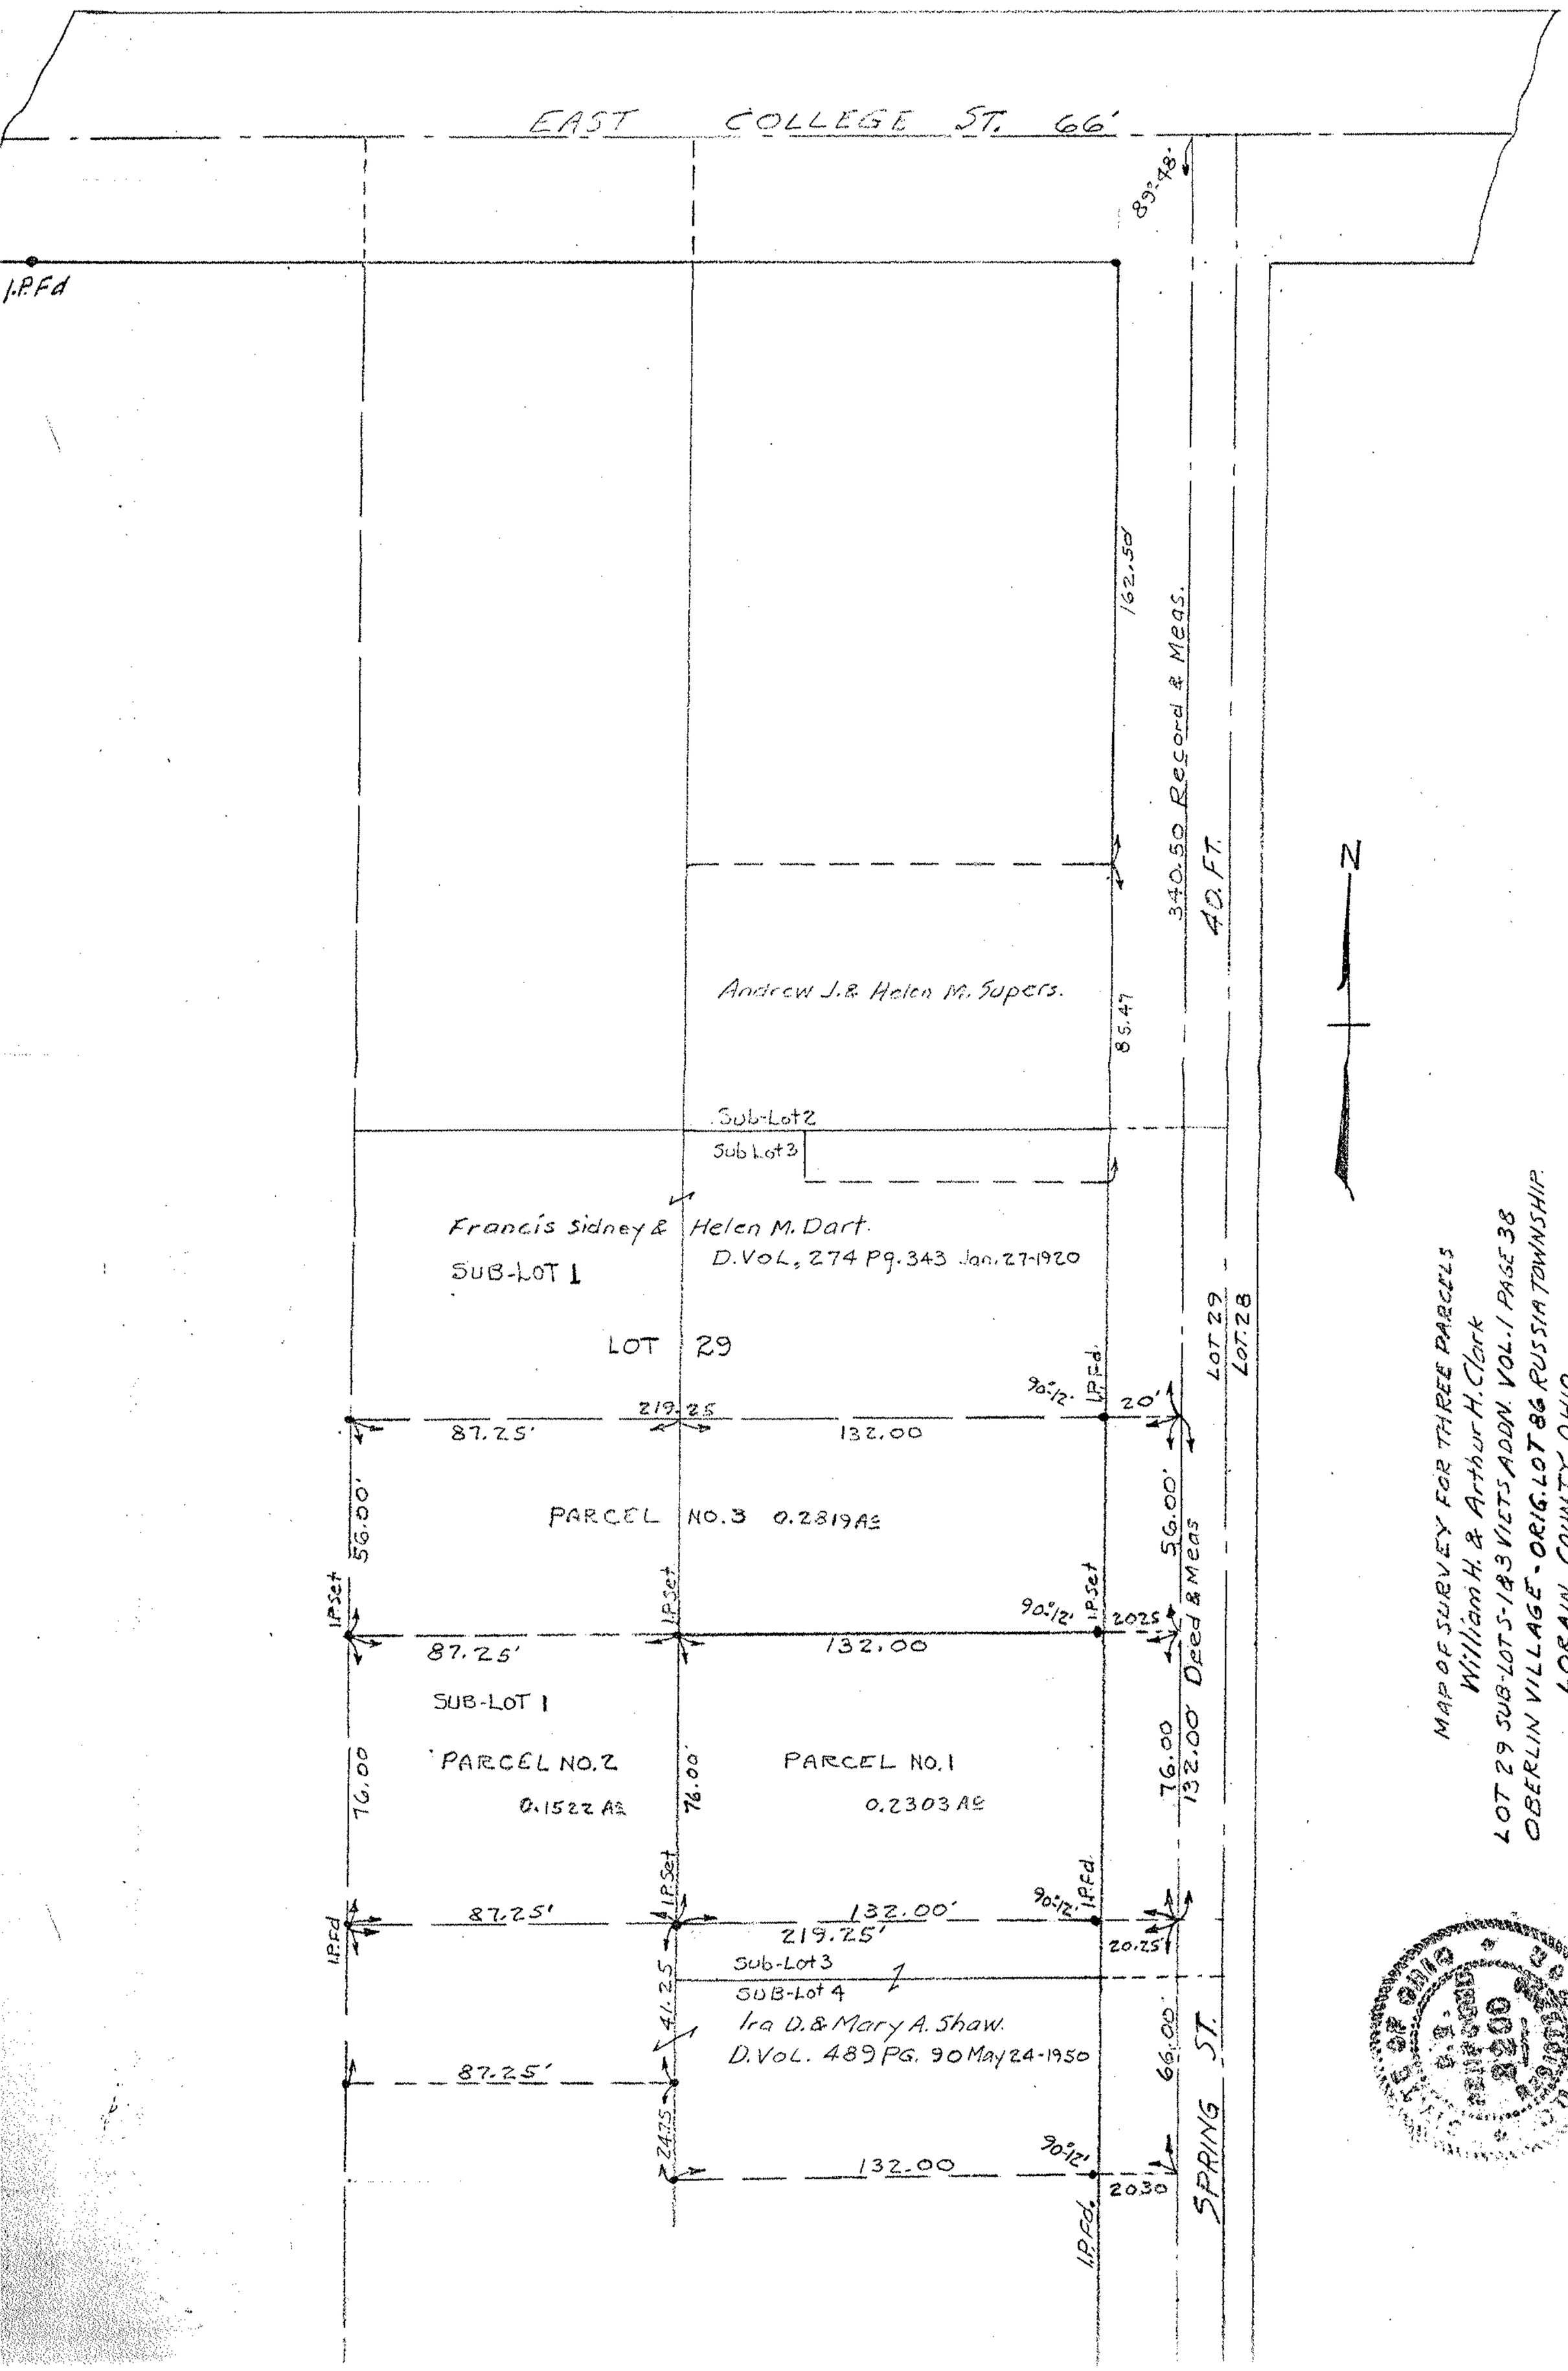

MAP OF SURVEY FOR THREE PARCELS
William H. & Arthur H. Clark
LOT 29 SUB-LOTS-1&3 VIETS ADDN. VOL. 1 PAGE 38
OBERLIN VILLAGE - ORIG. LOT 86 RUSSIA TOWNSHIP
LORAIN COUNTY OHIO
SCALE 1" = 40'
C.E. Penfound
NOV. 23-1952
Registered Surveyor.