SURVEY

OF PART OF

ROCHESTER TOWNSHIP

LOTS 4, 9, 10, 11 & 17 TRACT Nº 5

COUNTY OF LORAIN STATE OF OHIO

PREPARED FOR

ZF LAND CO. LTD
48265 GRIGGS RD.
WELLINGTON, OH.
AND
JOAN EATON
25535 QUARRY RD.
WELLINGTON, OH.

PREPARED BY:

HAPONEK & ASSOC. INC.
SURVEYORS
N. RIDGEVILLE, OH.

DATE: APRIL 1999
SCALE: 1" = 200'

STATE OF OHIO
DANE A. HAPONEK
S-8318
REGISTERED SURVEYOR

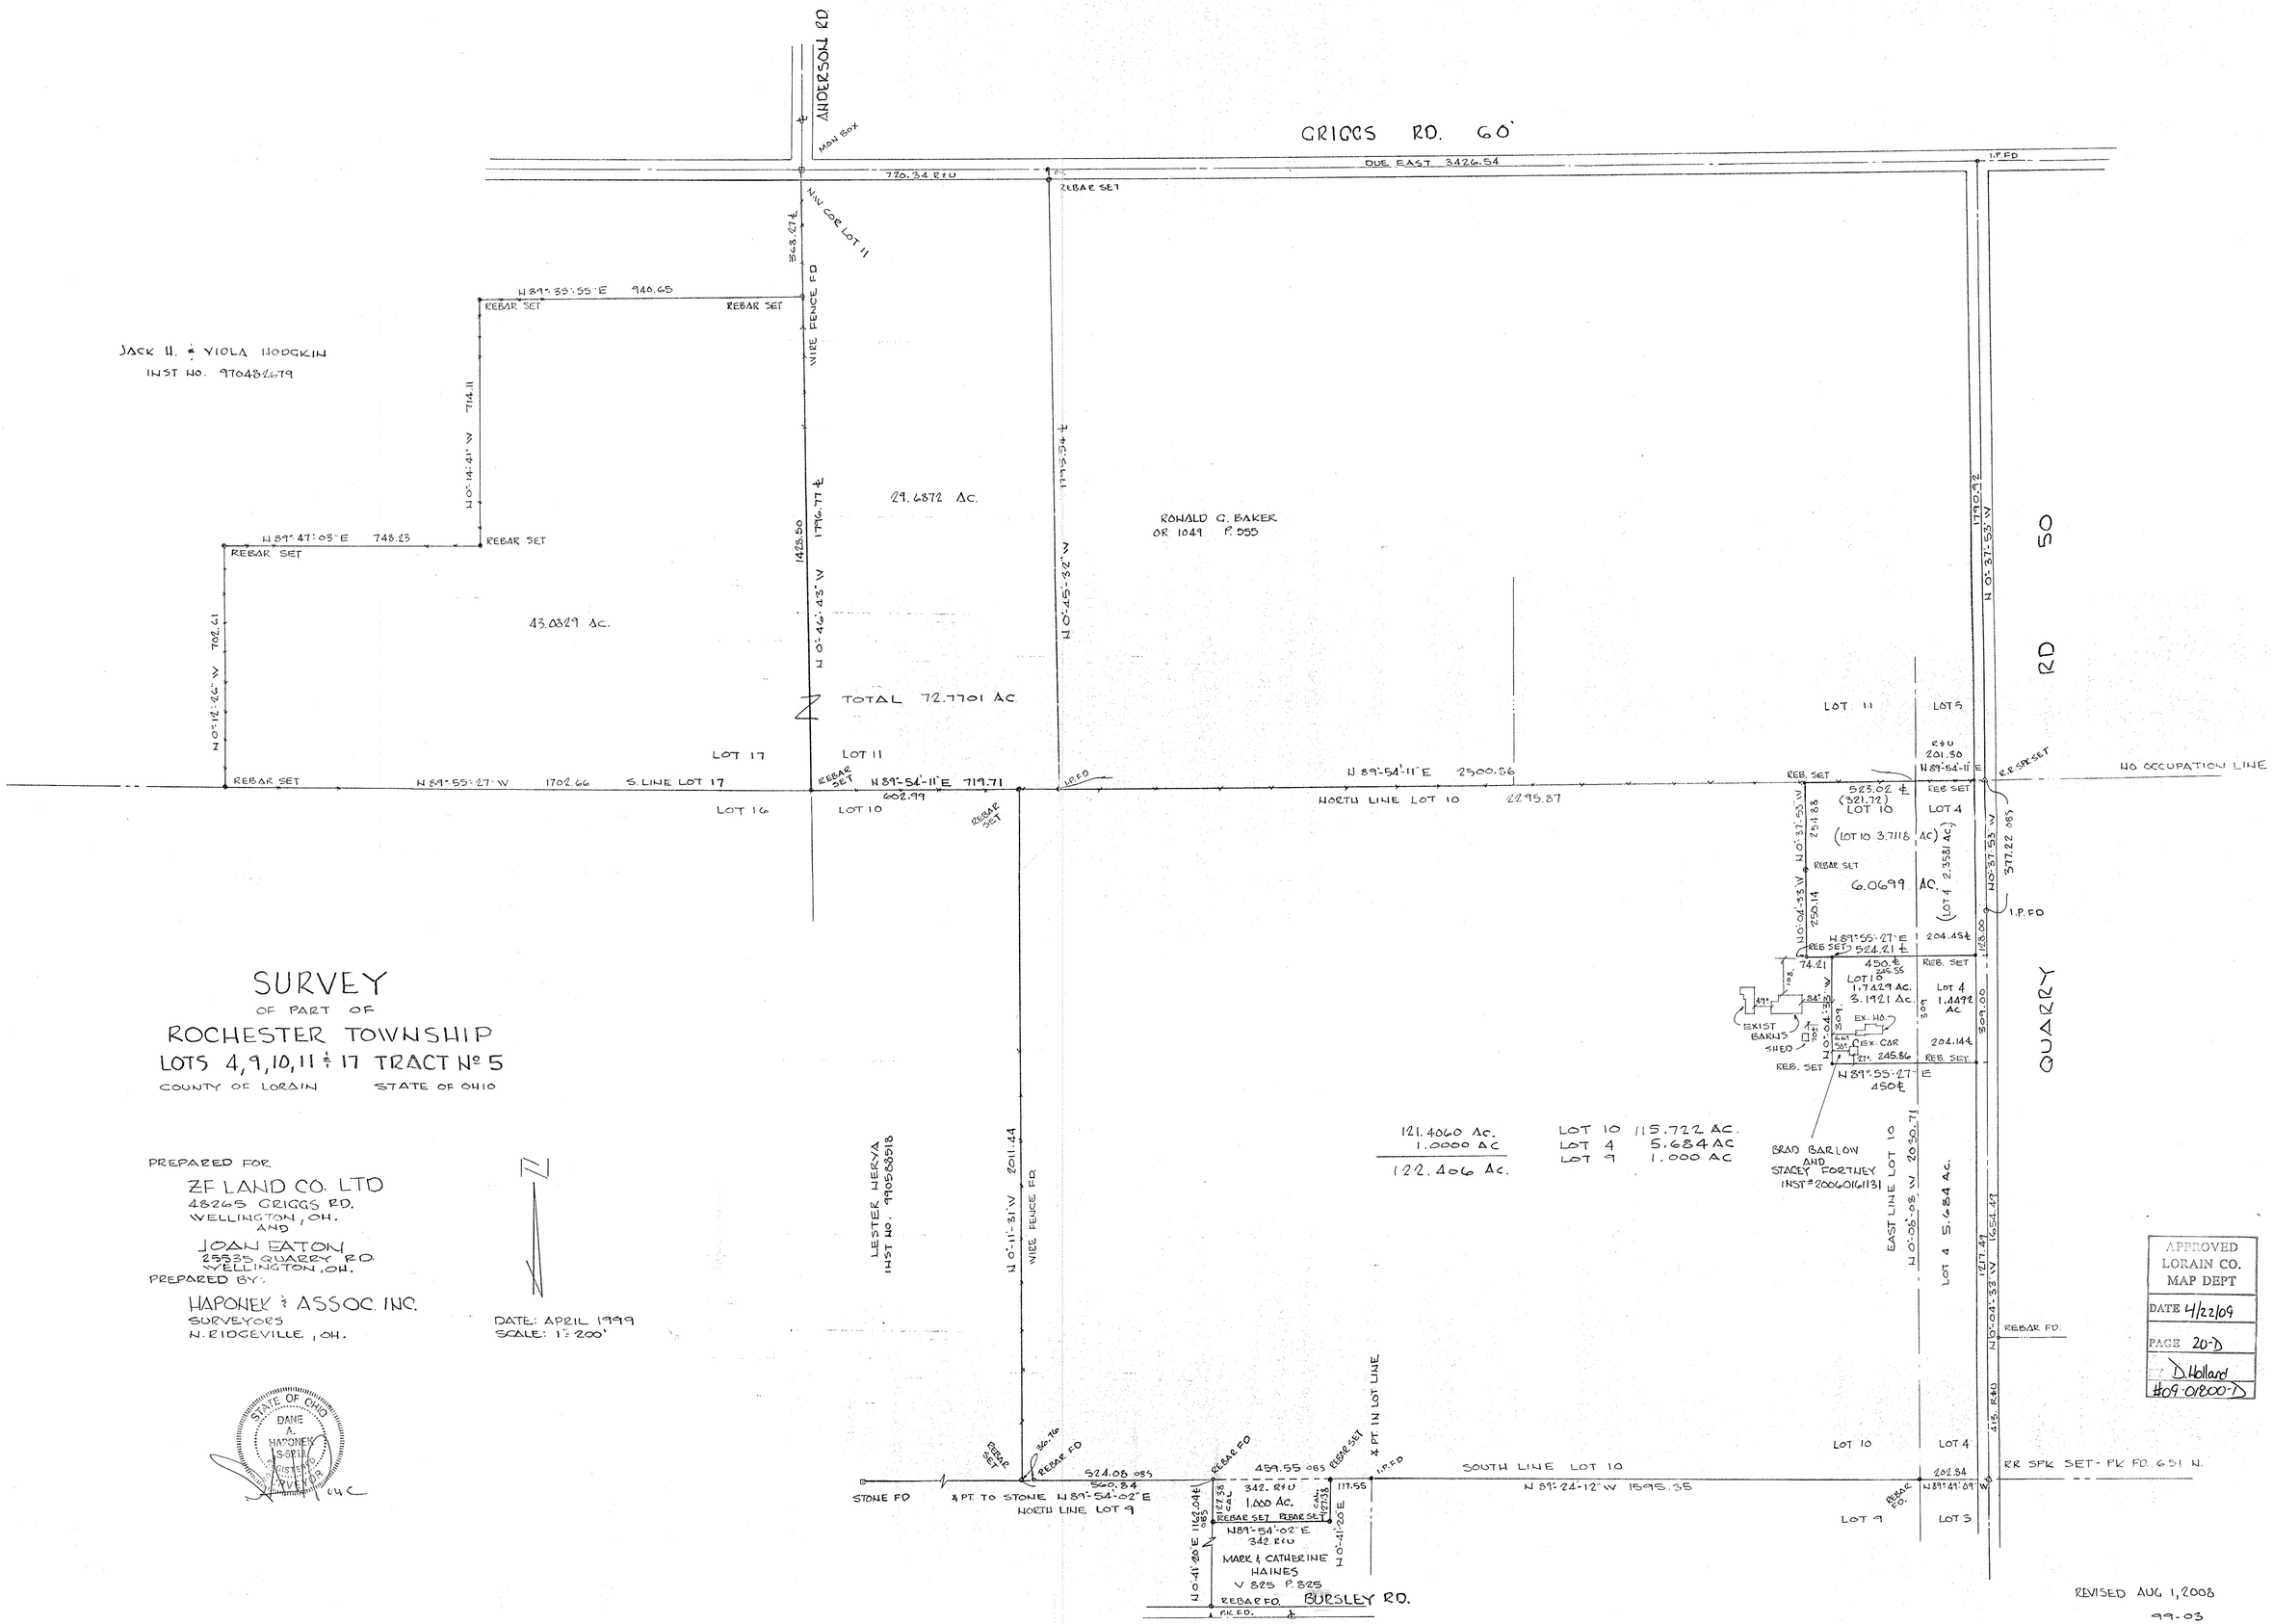

REVISED AUG 1, 2008

99-03