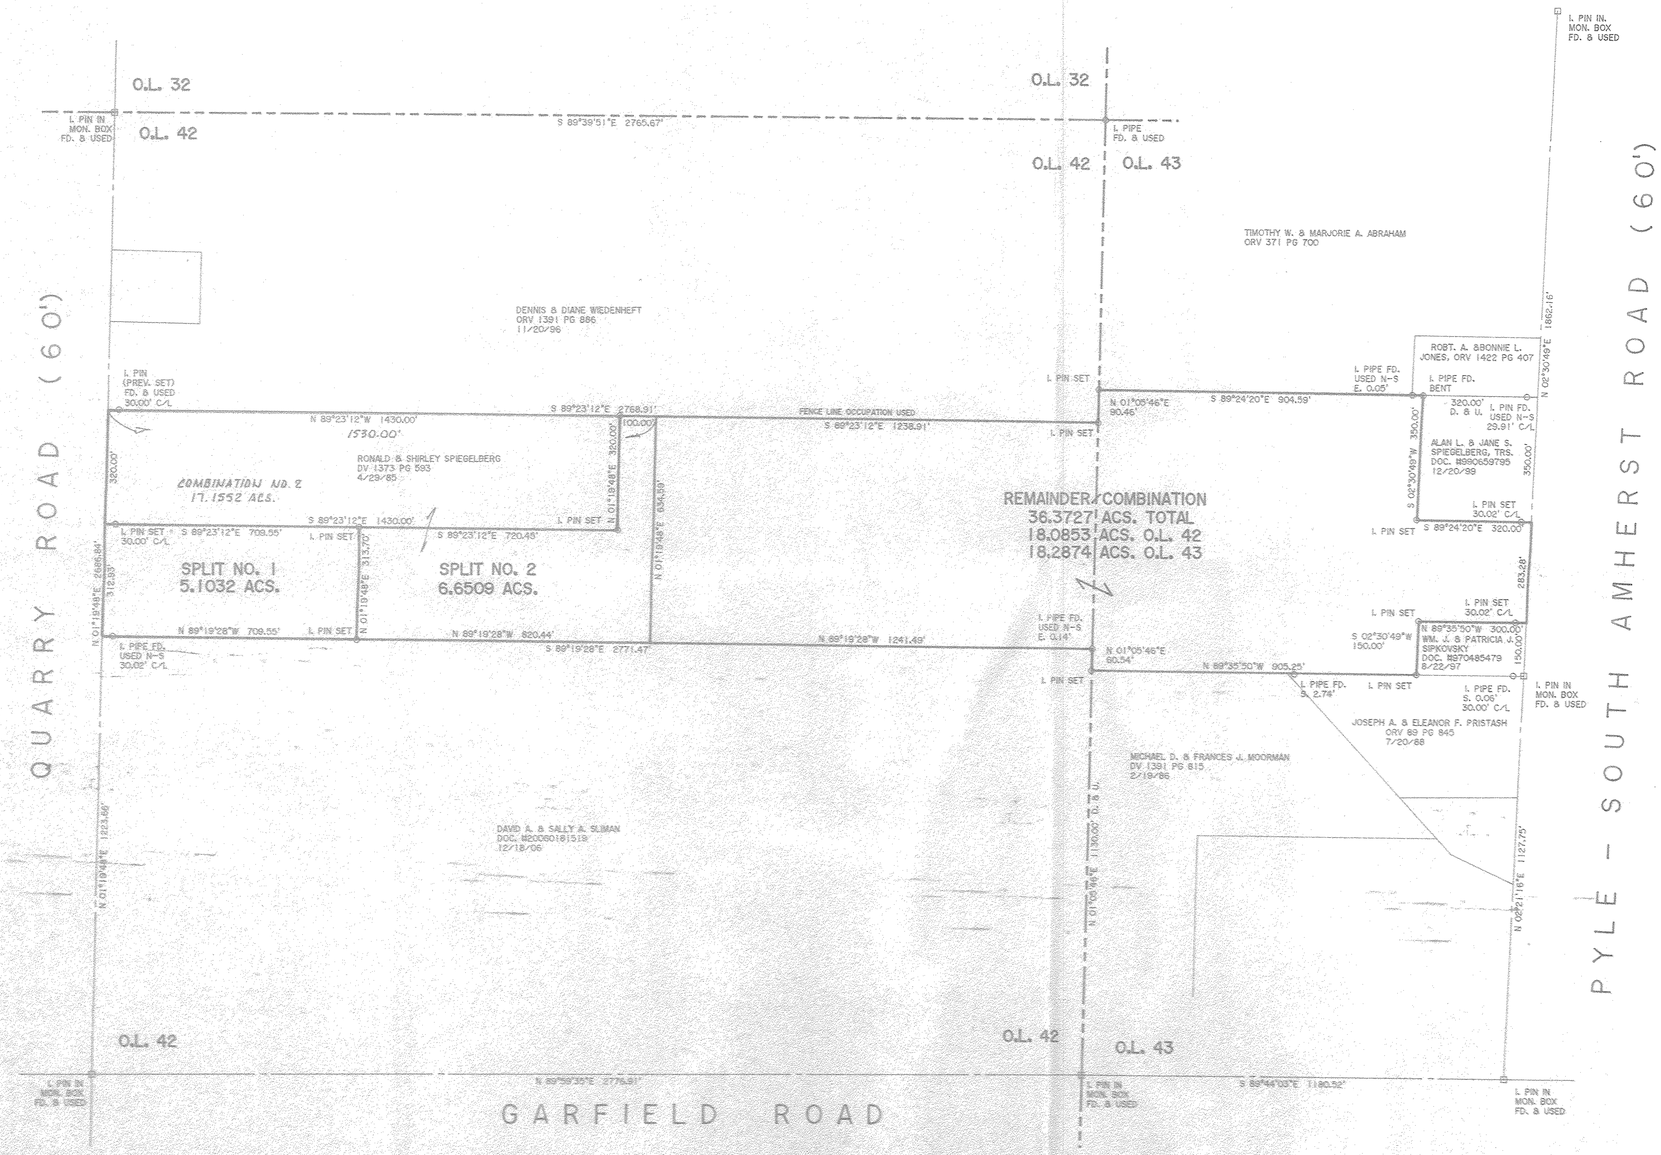

200 0 200 400 600
GRAPHIC SCALE - FEET

N

DIMENSIONS SHOWN ON THIS PLAT ARE EXPRESSED IN FEET AND DECIMAL PARTS THEREOF, ALL BEARINGS ARE TO AN ASSUMED MERIDIAN AND ARE USED TO INDICATE ANGLES ONLY. PERMANENT MONUMENTS WERE FOUND OR SET AT ALL POINTS INDICATED HEREON, ALL OF WHICH I CERTIFY TO BE CORRECT.

STATE OF OHIO THOMAS A. SIMON S-7775 REGISTERED PROFESSIONAL SURVEYOR

THOMAS A. SIMON
REG. PROFESSIONAL SURVEYOR
NO. S-7775

BASIS OF BEARINGS IS THE CENTERLINE OF QUARRY ROAD (NORTH 01°19'48" EAST). IRON PINS SET ARE 5/8" DIAMETER, 30" LONG WITH PLASTIC CAPS "T. SIMON, S-7775".

#026.91
APPROVED
LORAIN CO.
MAP DEPT
DATE 4-29-09
9-00-042-000-005,904
PAGE 9-00-042-A,B
BY JHatfield
#09-02491

09-00-043-000-034

PLAT OF SURVEY, SPLIT & COMBINATION FOR RONALD & ALAN SPIEGELBERG

BEING KNOWN AS PARTS OF ORIGINAL NEW RUSSIA TOWNSHIP LOT NOS. 42 AND 43

COUNTY OF LORAIN STATE OF OHIO

JULY, 2008 SCALE: 1" = 200'

THOMAS SIMON & ASSOCIATES, INC.
PROFESSIONAL LAND SURVEYORS
190 SOUTH OLIVE STREET
ELYRIA, OHIO 44035
(440) 327-2923
FAX 327-2964

JOB NO. 2008-027

REV. 4/09 COMBINATION NO. 2