Survey for

THE PARTS REALTY COMPANY.

Parts of Lots 509 Block 95; Lot 546 Block 98; and part Block 99.

Heman Ely's Addition - Volume 1 - Pg. 35.

Elyria Lorain Co., Ohio.

May 16, 1919.

Warden & Laundon.
Civil Engineers.

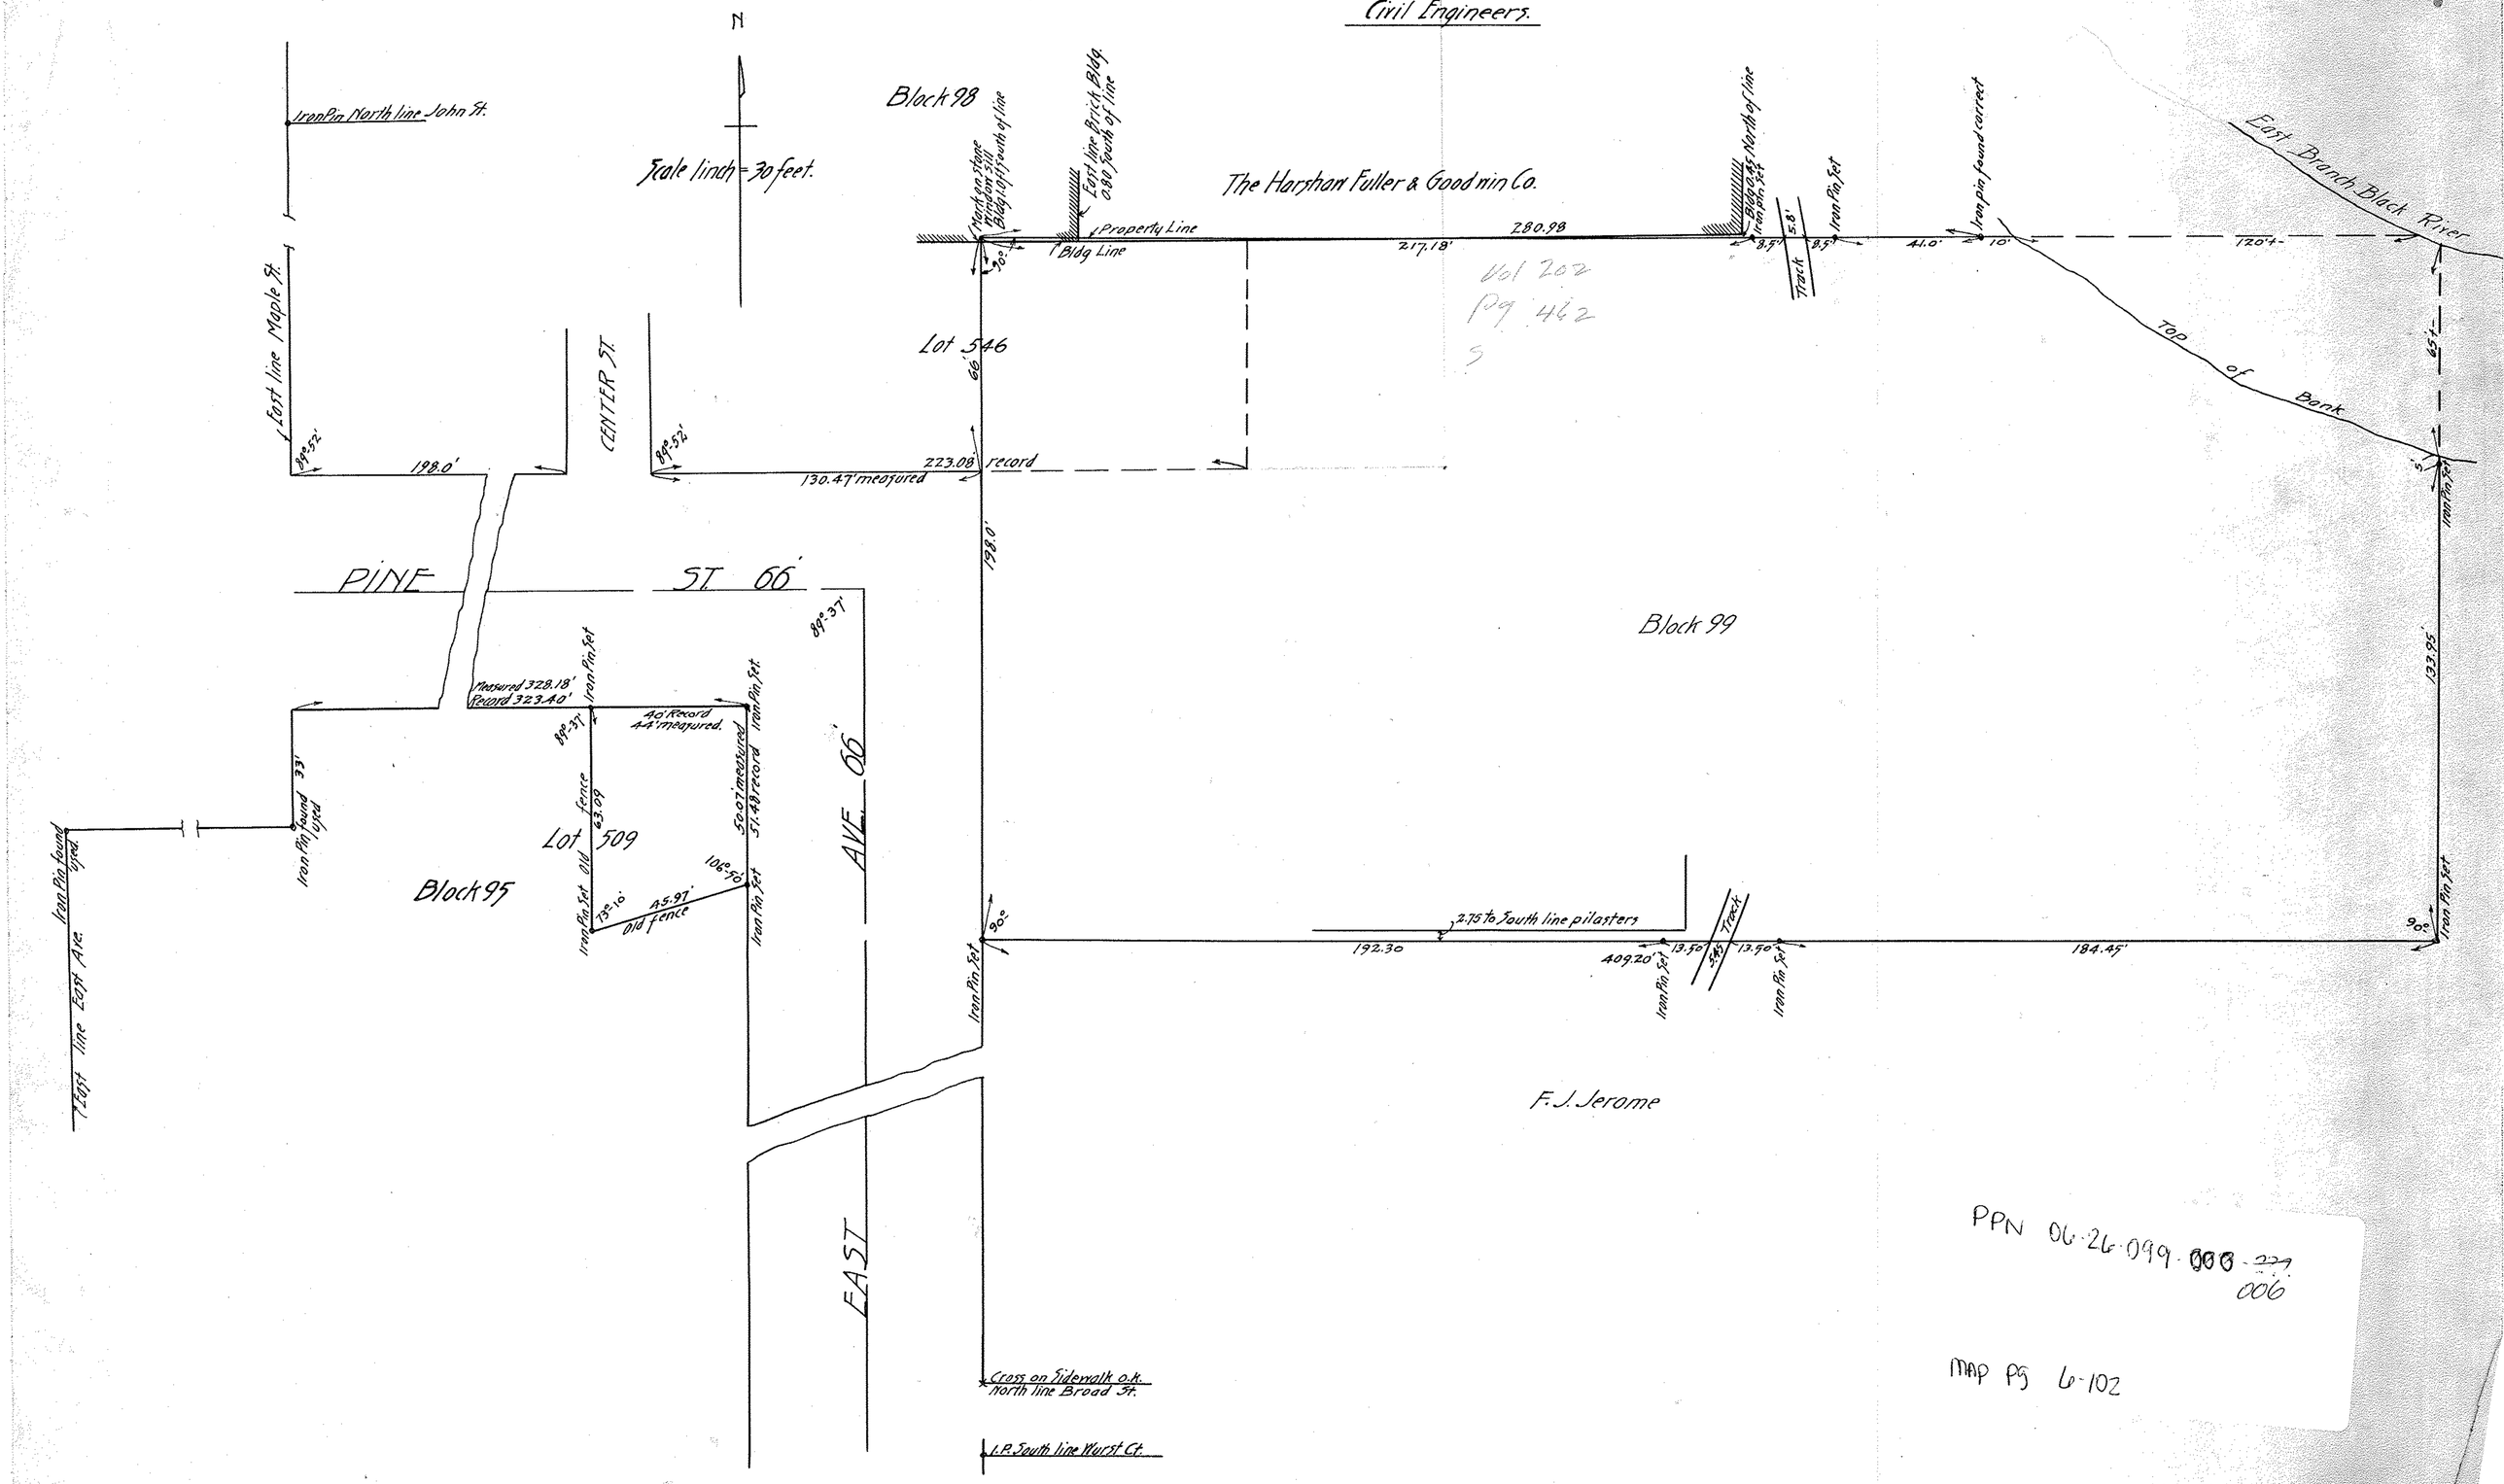

Vol 202
Pg 462
S

PPN 06-26-099-000-~~229~~ 006

MAP Pg 6-102

300440