PPN 06-24-008-105-002
06-24-009-108-027

MAP Pg 6-135

Survey for
ALEX ALTFELD.
Original Lots 8 and 9, West of West Branch of Black River,
Elyria Twp., Elyria City, Lorain Co.,
Ohio.

Oct. 11. 1930. Scale 1 inch = 50 feet.
Wardner & Launder. Civil Engineers.

6.730 Acres West of Lots
2.198 " " Lots
2.357 " to be leased.
17.916 " Total
Note: All acreages are calculated to sides of Streets
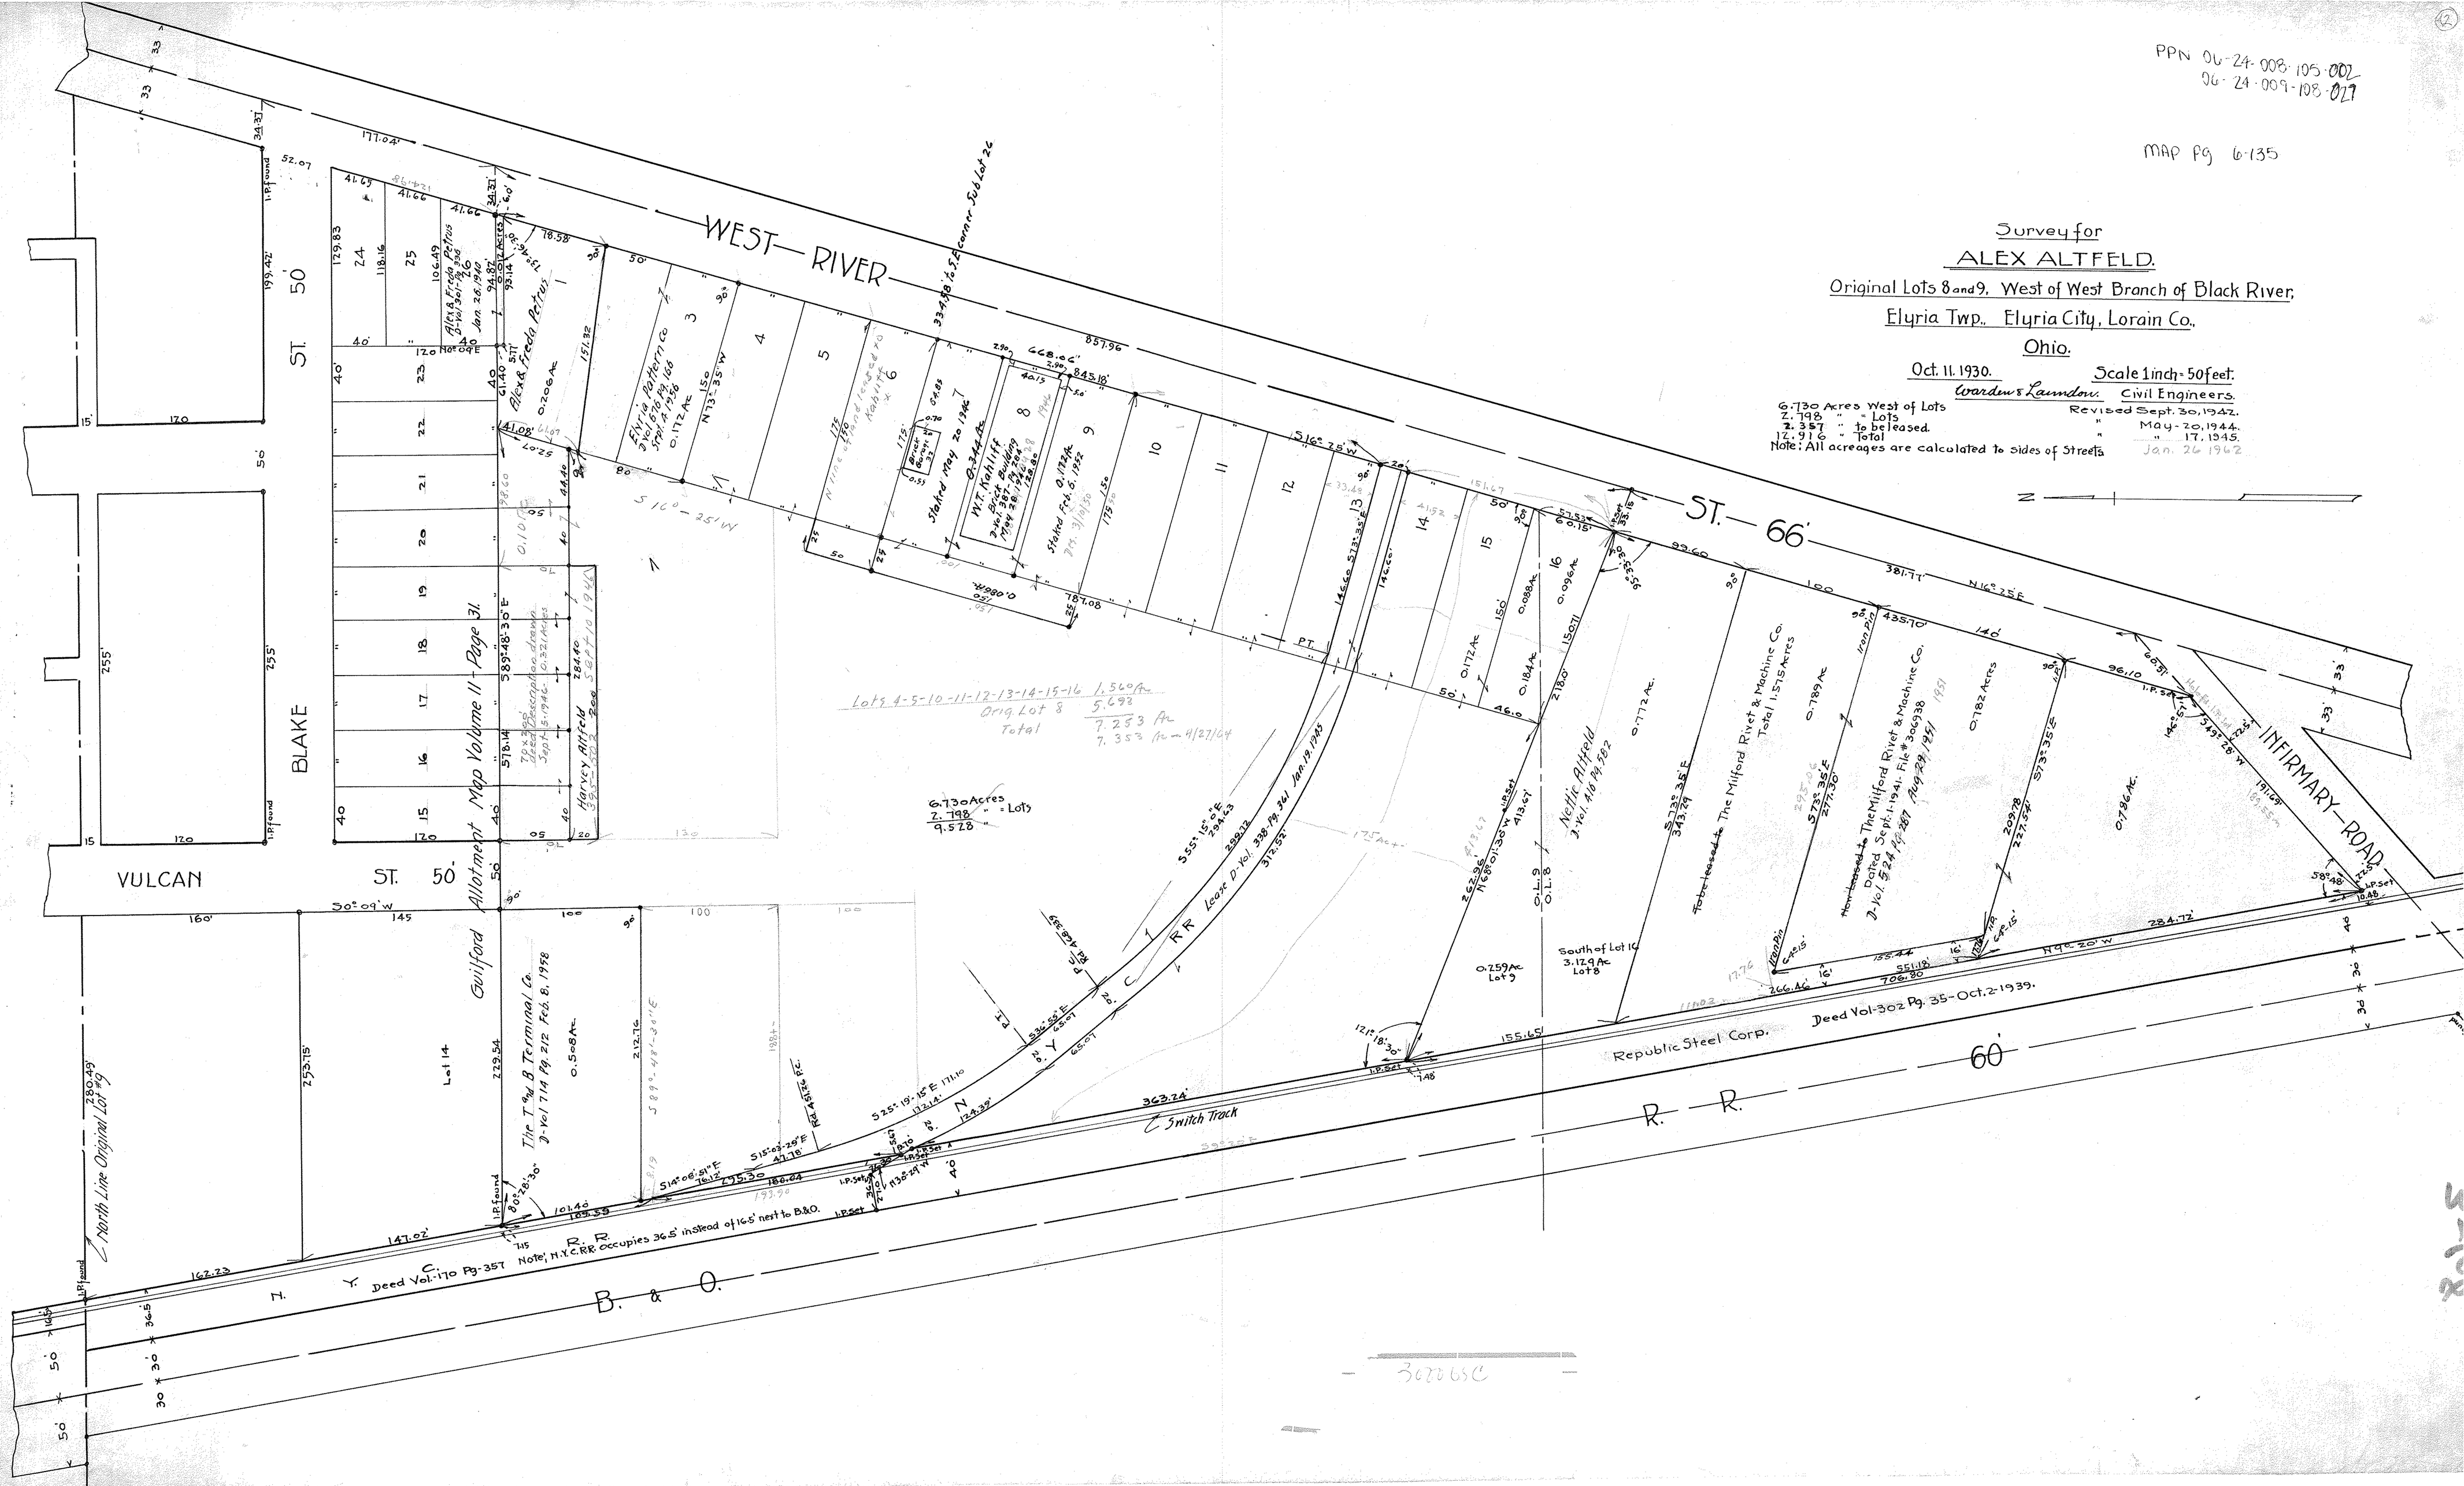
Revised Sept. 30, 1942.
" May-20, 1944.
" " 17, 1945.
Jan. 26 1962