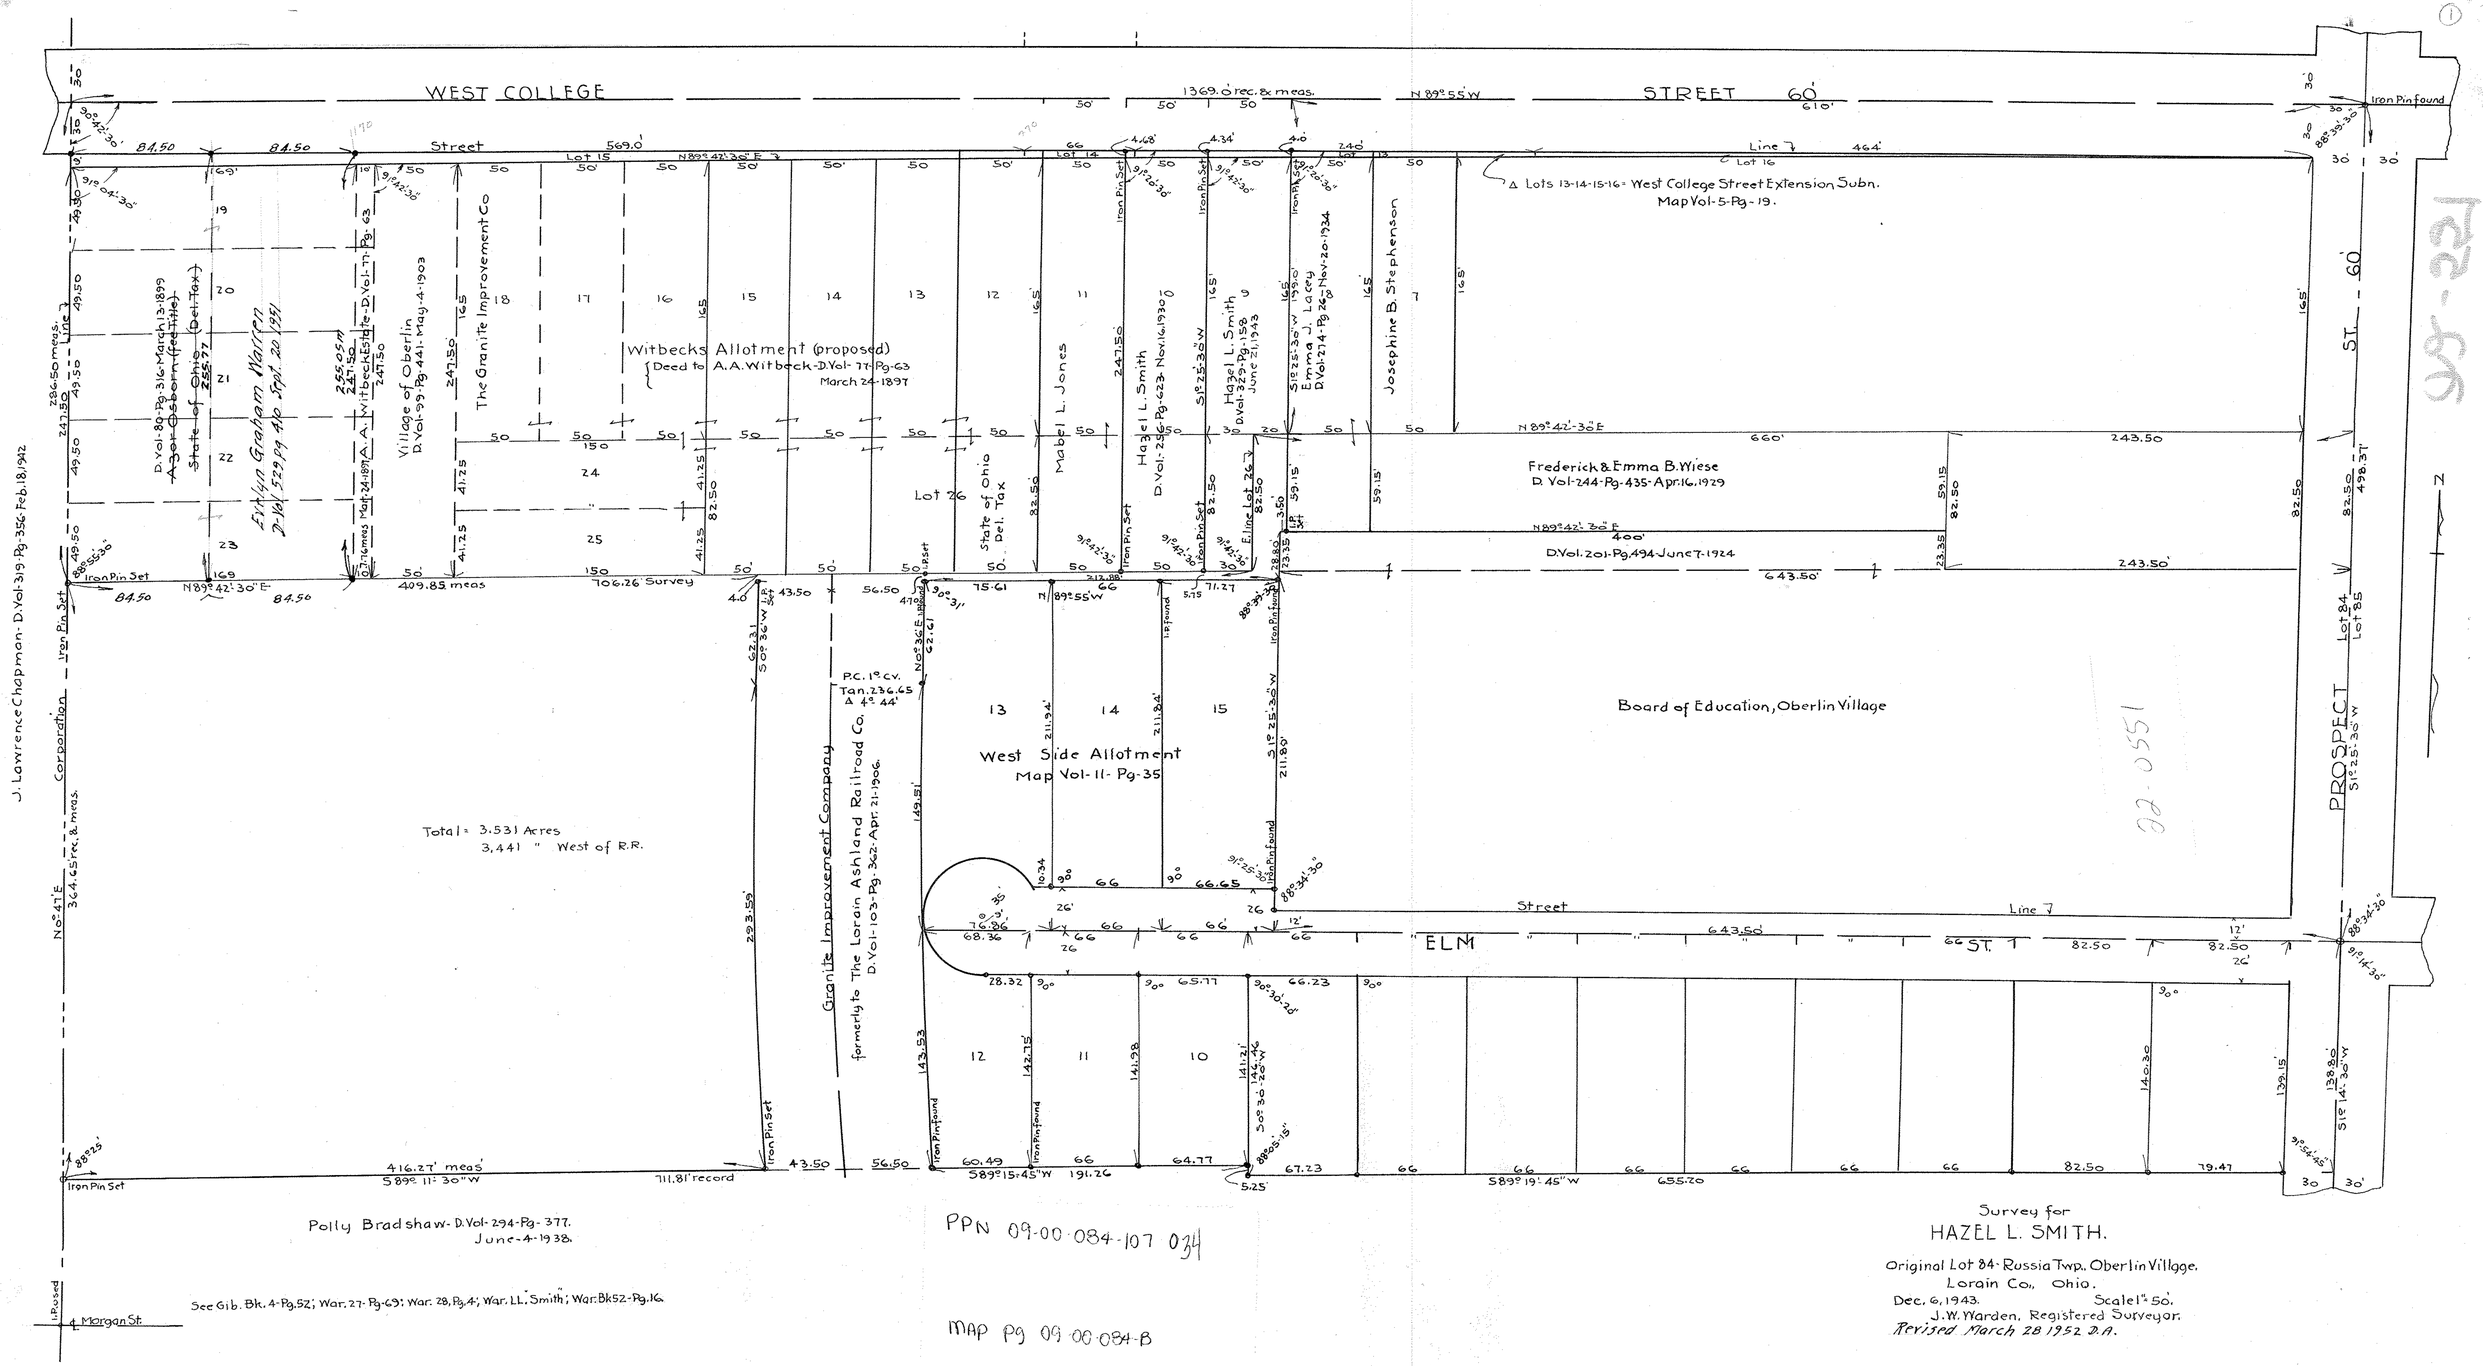
WEST COLLEGE STREET 60'
Street
Line
Lots 13-14-15-16 - West College Street Extension Subn. Map Vol-5-Pg-19.
Witbecks Allotment (proposed)
Deed to A.A. Witbeck - D.Vol-77-Pg-63 March 24-1897
The Granite Improvement Co
Village of Oberlin D.Vol-99-Pg-441-May-4-1903
State of Ohio (Del. Tax)
Mabel L. Jones
Hazel L. Smith D.Vol-236-Pg-623-Nov.16.1930
Hazel L. Smith D.Vol-329-Pg-158 June 21.1943
Emma J. Lacey D.Vol-274-Pg-26 Nov-20-1934
Josephine B. Stephenson
Frederick & Emma B. Wiese D.Vol-244-Pg-435-Apr.16.1929
D.Vol.201-Pg.494-June 7-1924
Board of Education, Oberlin Village
West Side Allotment Map Vol-11-Pg-35
Granite Improvement Company formerly to The Lorain Ashland Railroad Co. D.Vol-103-Pg-362-Apr. 21-1906.
Total = 3.531 Acres
3.441 " West of R.R.
ELM ST. 60'
PROSPECT ST. 60'
Polly Bradshaw - D.Vol-294-Pg-377. June-4-1938.
PPN 09-00-084-107 034
MAP Pg 09-00-084-B
Survey for HAZEL L. SMITH.
Original Lot 84 - Russia Twp., Oberlin Village. Lorain Co., Ohio.
Dec. 6, 1943. Scale 1" = 50'.
J.W. Warden, Registered Surveyor.
Revised March 28 1952 D.A.