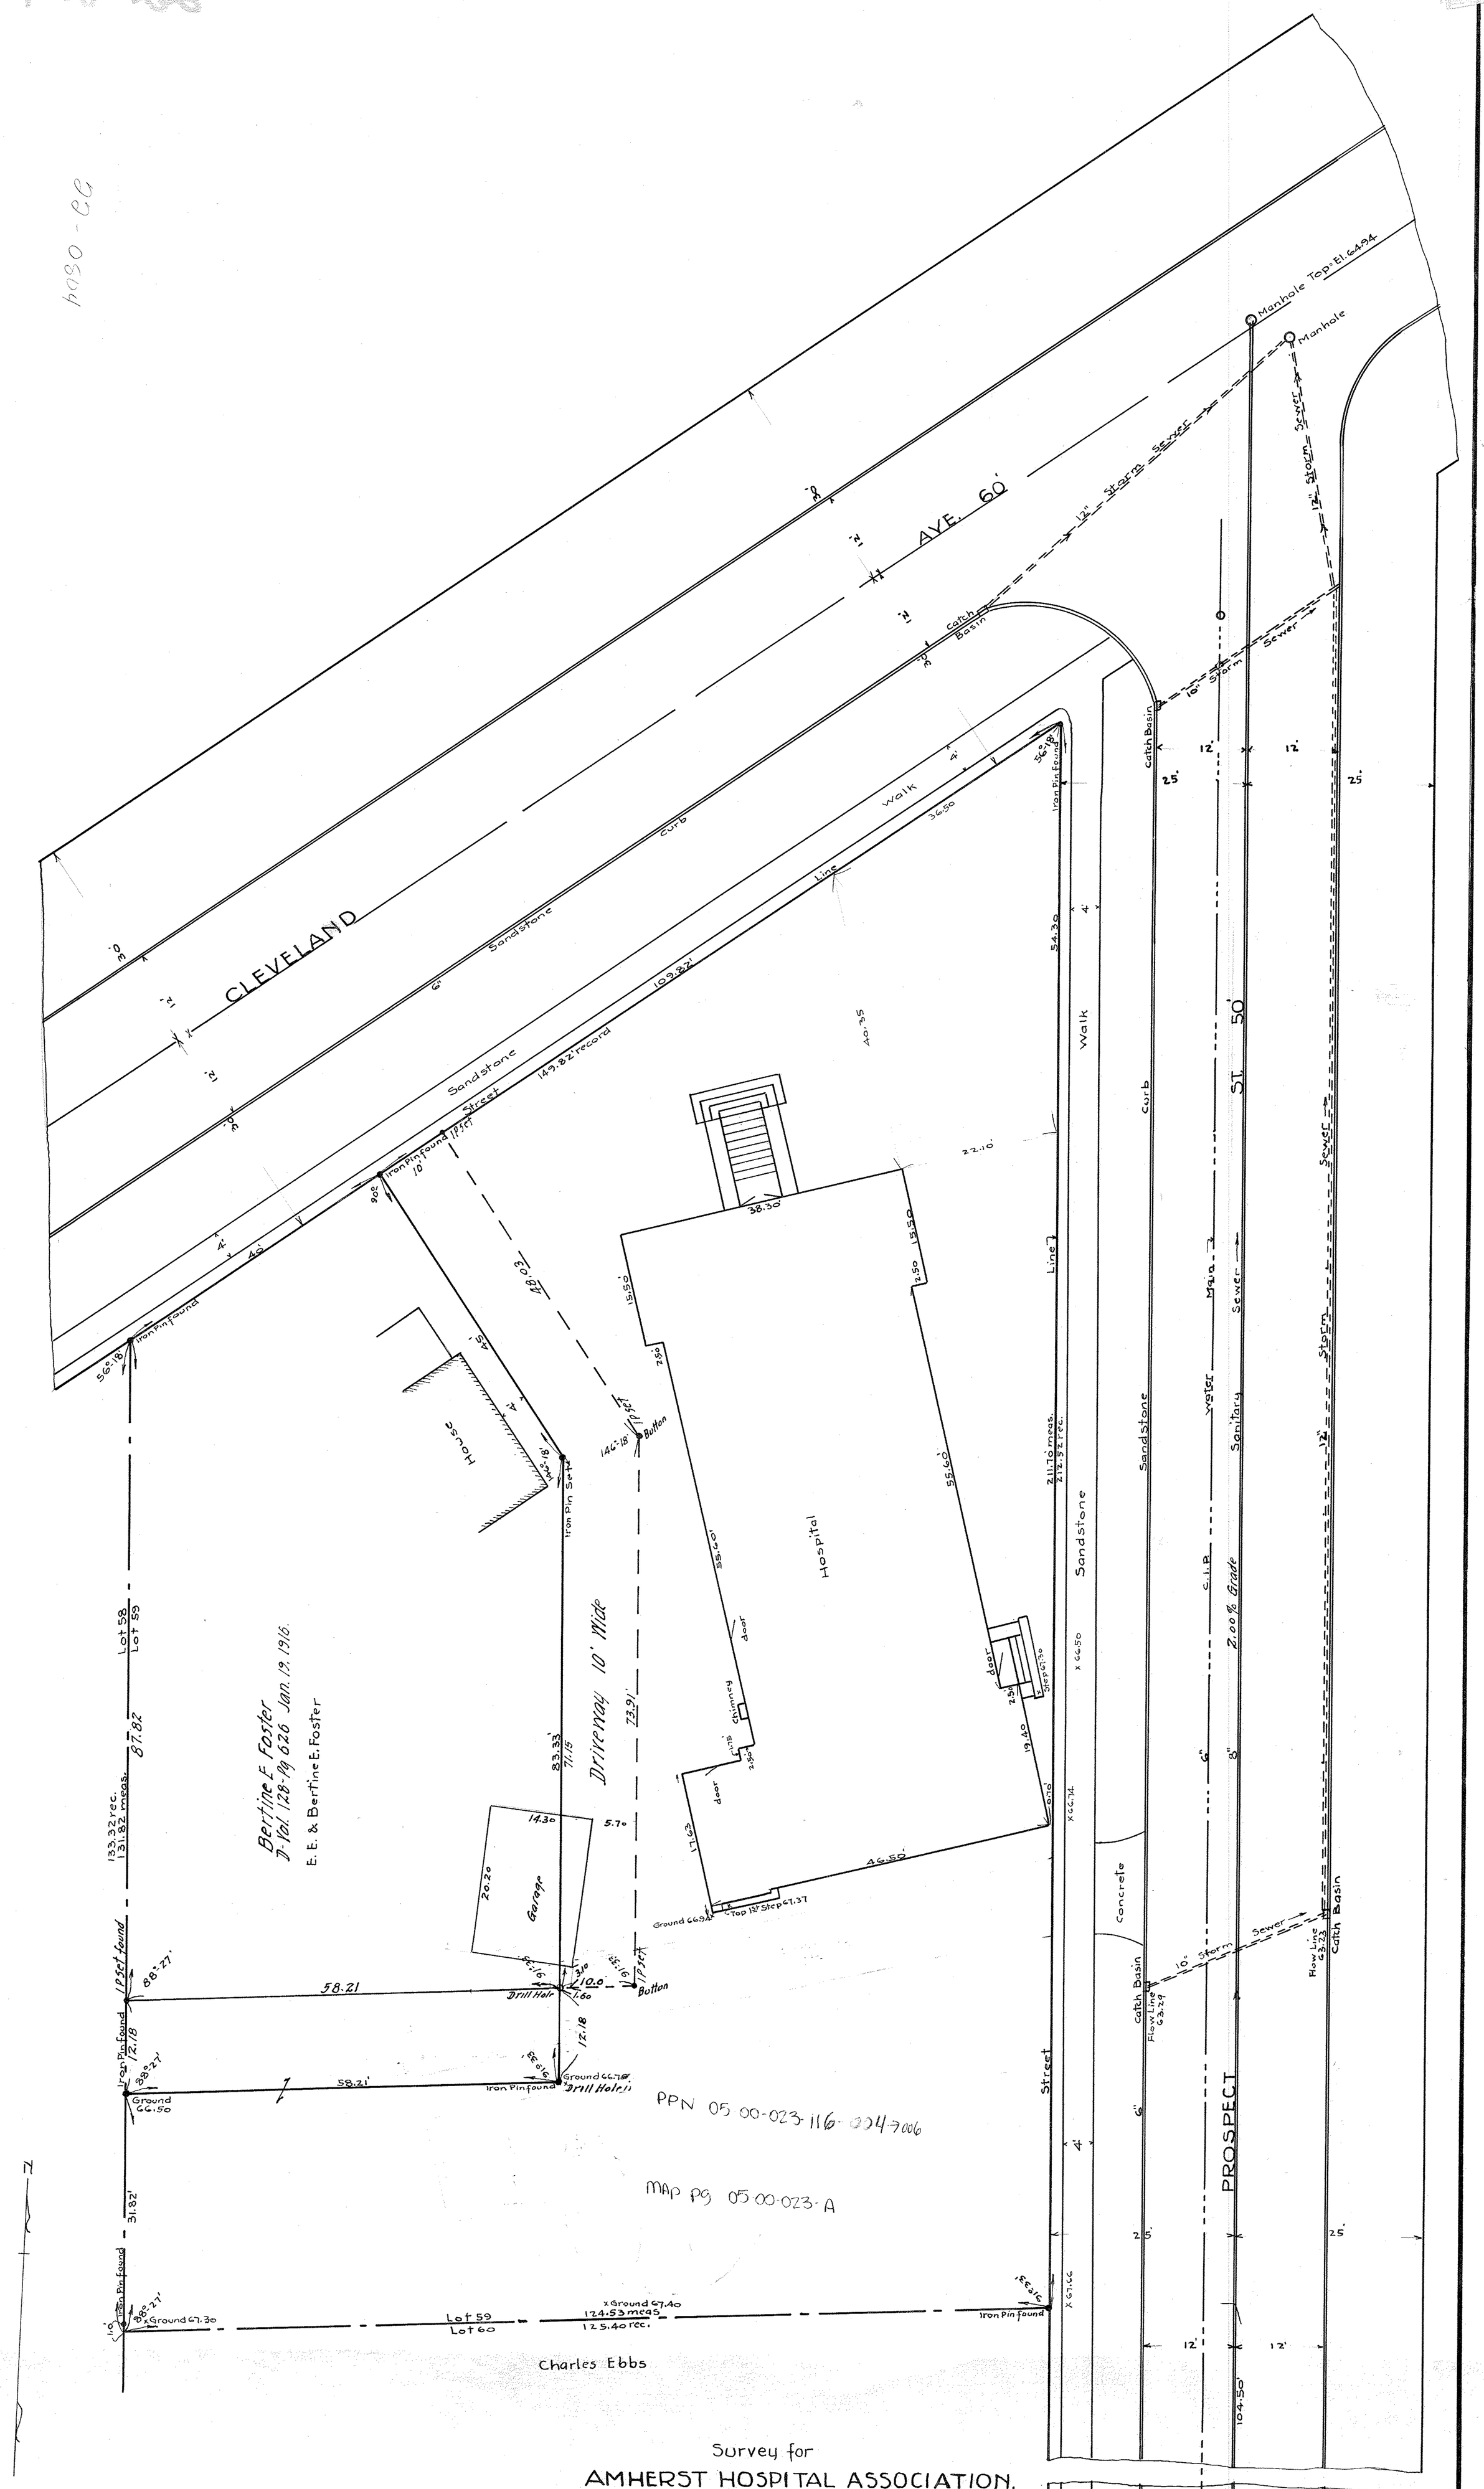

Survey for

AMHERST HOSPITAL ASSOCIATION.

Lot 59-Onstine Addition-Map Vol-1-Pg-5.

Amherst, Lorain Co., Ohio.

Nov. 18, 1943. Scale 1"=10'.

Deed Vol-153-Pg-149-Oct. 1, 1917.

J.W. Warden, Registered Surveyor. *Revised Feb. 25. 1949. - April. 6. 1953.*

Note:- Measurements on Hospital Building are taken to Water table.