21-1334-1

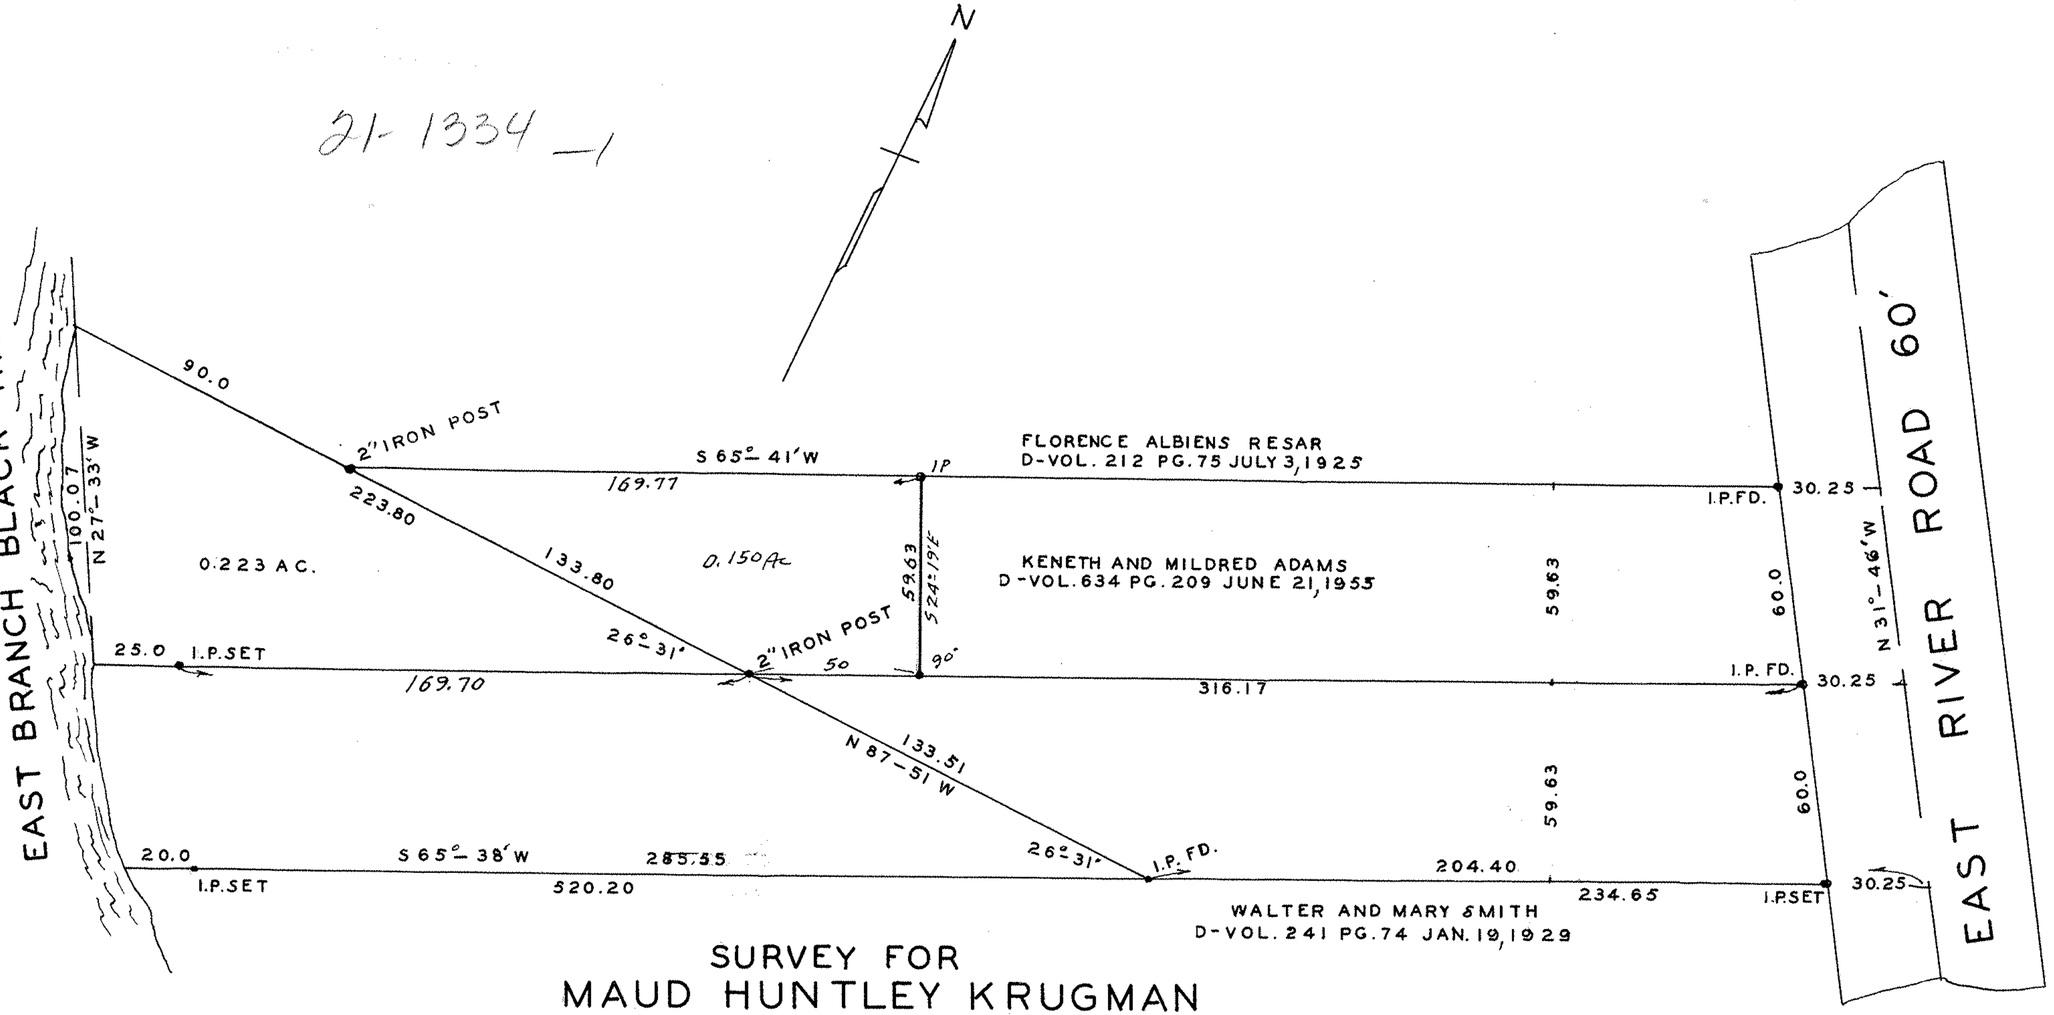

SURVEY FOR
MAUD HUNTLEY KRUGMAN
D-VOL. 248 PG. 471 MARCH 6, 1930
SECTION 4 CARLISLE TOWNSHIP
LORAIN COUNTY OHIO
SCALE 1" = 40' MAY 2, 1960
J.W. WARDEN AND ASSOCIATES REG. SURVEYORS

BY — D.D. Andrus
D.D. ANDRUS
Revised June 9 1965

PPN 10-00-004-132-026,027

MAP pg 10-00-004-C