



PPW 06-26-073-000 007, 008, 009

MAP PG 6-119

Scm 41998

Survey for The Wolfe-Sill Realty Co.  
Parts of Lots #62 & 63, Block 73.  
Original Village Plat. Elyria, Lorain Co. Ohio.  
Jan. 24, 1921 Scale 1" = 20'

We hereby certify that the locations of buildings and dimensions as shown on this plat are in accordance with our survey of same as made on this 24<sup>th</sup> day of Jan, 1921  
Warden & Laundon - Engineers.  
by J.W. Laundon.

 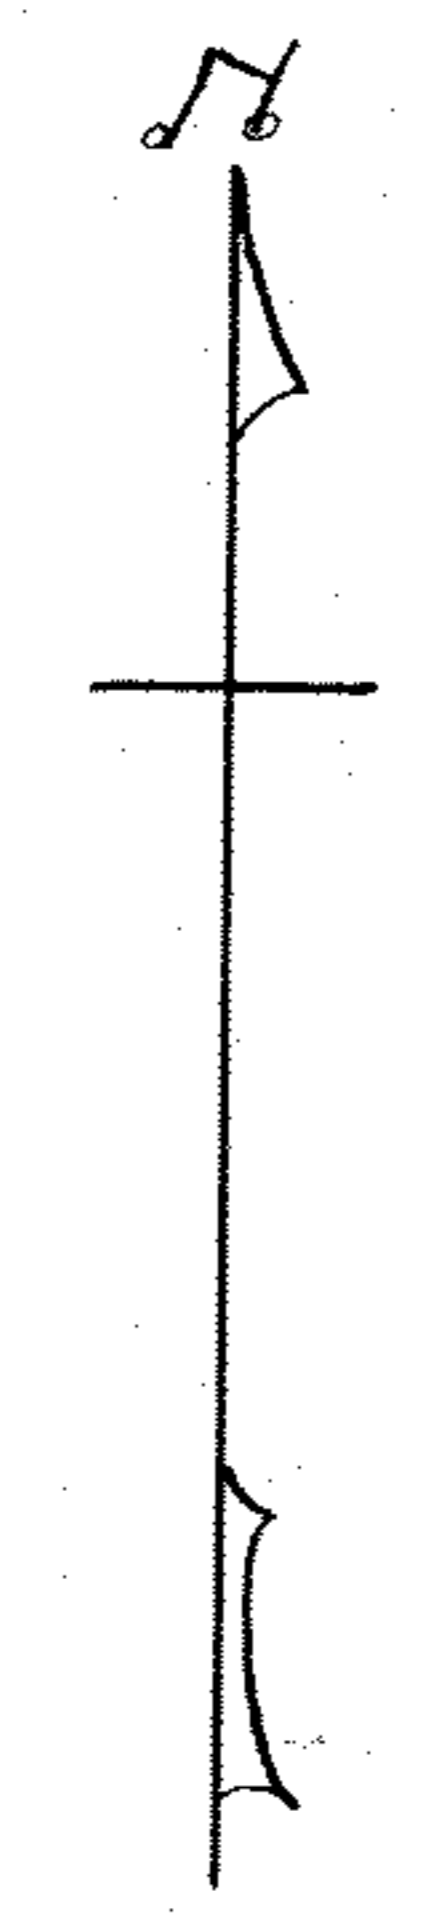

315

V 212208

WEST AVENUE 66' ST.

stone