


88-630

PPN 08-12-012-000-015,040,139

MAP pg 8-E

Emmett C. Jr. & Josephine G. Thompson
D-Val 317-Pg 176 Oct. 30 1941.

BECKER ROAD

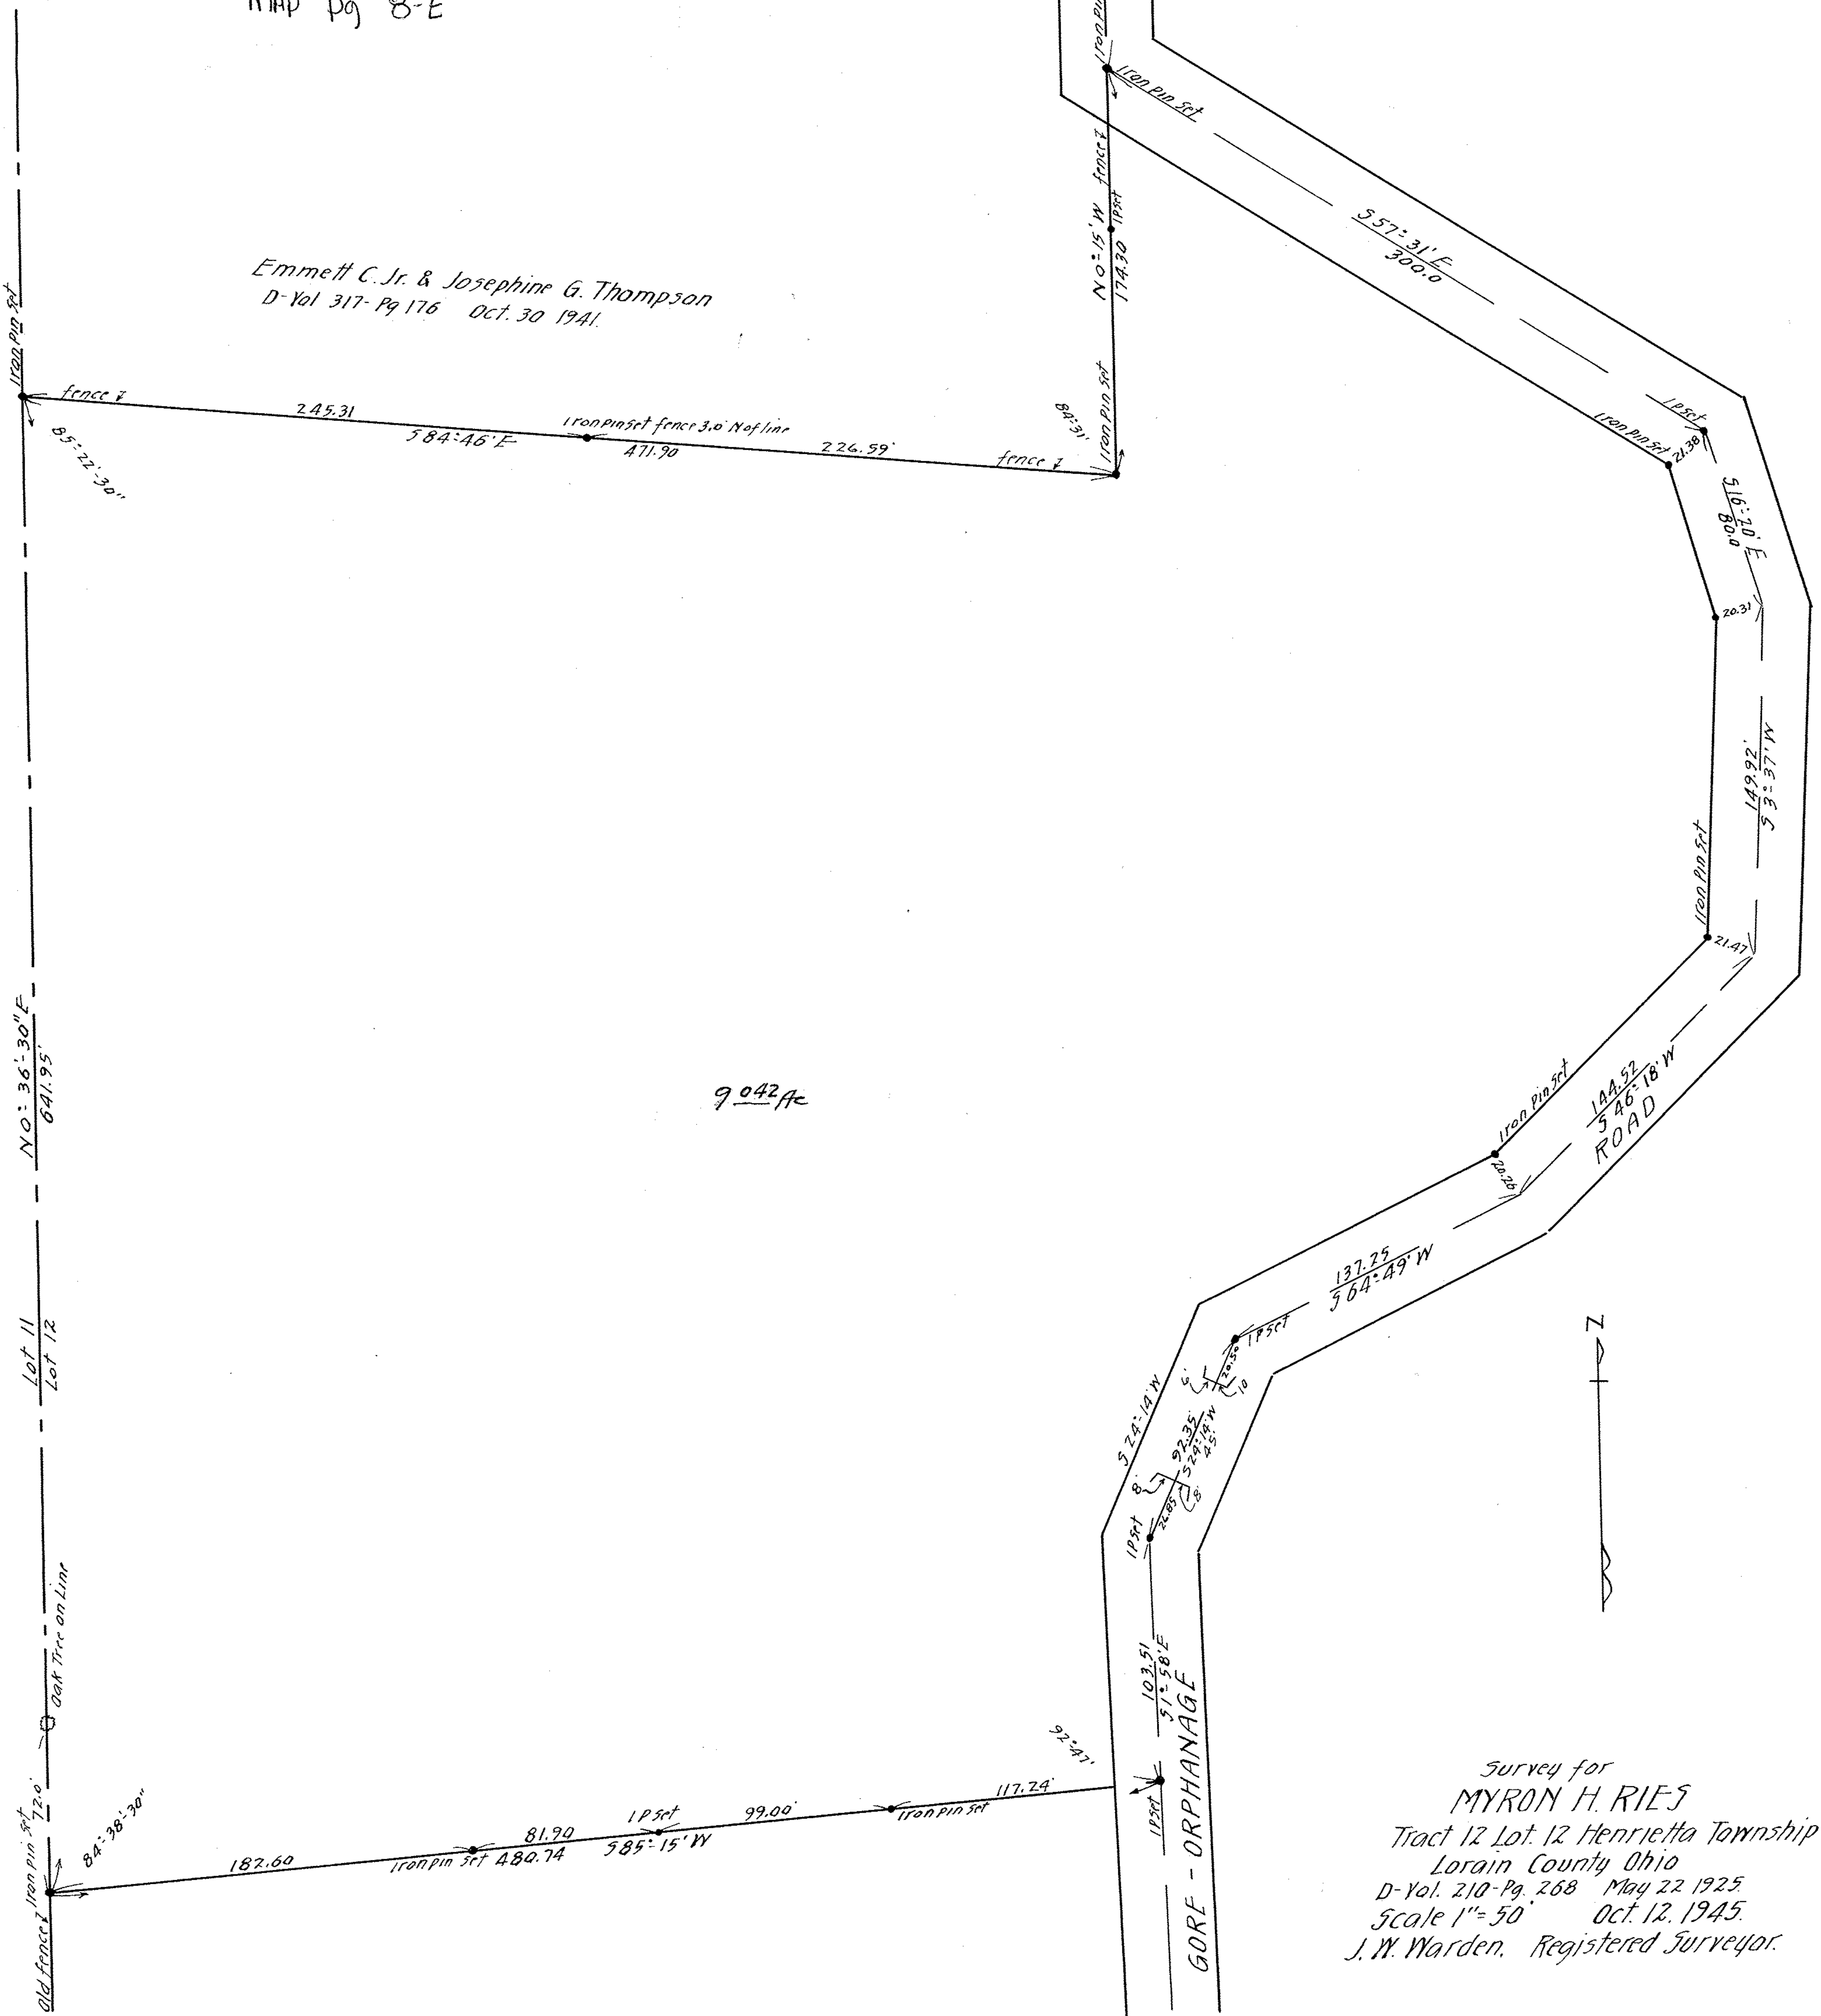

9.042 Ac

Survey for
MYRON H. RIES
 Tract 12 Lot 12 Henrietta Township
 Lorain County Ohio
 D-Val. 210-Pg. 268 May 22 1925
 Scale 1" = 50' Oct. 12, 1945.
 J. W. Warden, Registered Surveyor.