


SURVEY FOR
AUSTIN DRAPER
SUB LOTS 35-36 HEDGEROW PARK ALLOT.
MAP VOL 16 page 2
RIDGEVILLE VILLAGE LORAIN CO OHIO
SCALE 1" = 20' APRIL 6, 1960
J. W. WARDEN AND ASSOCIATES REG SURVEYORS

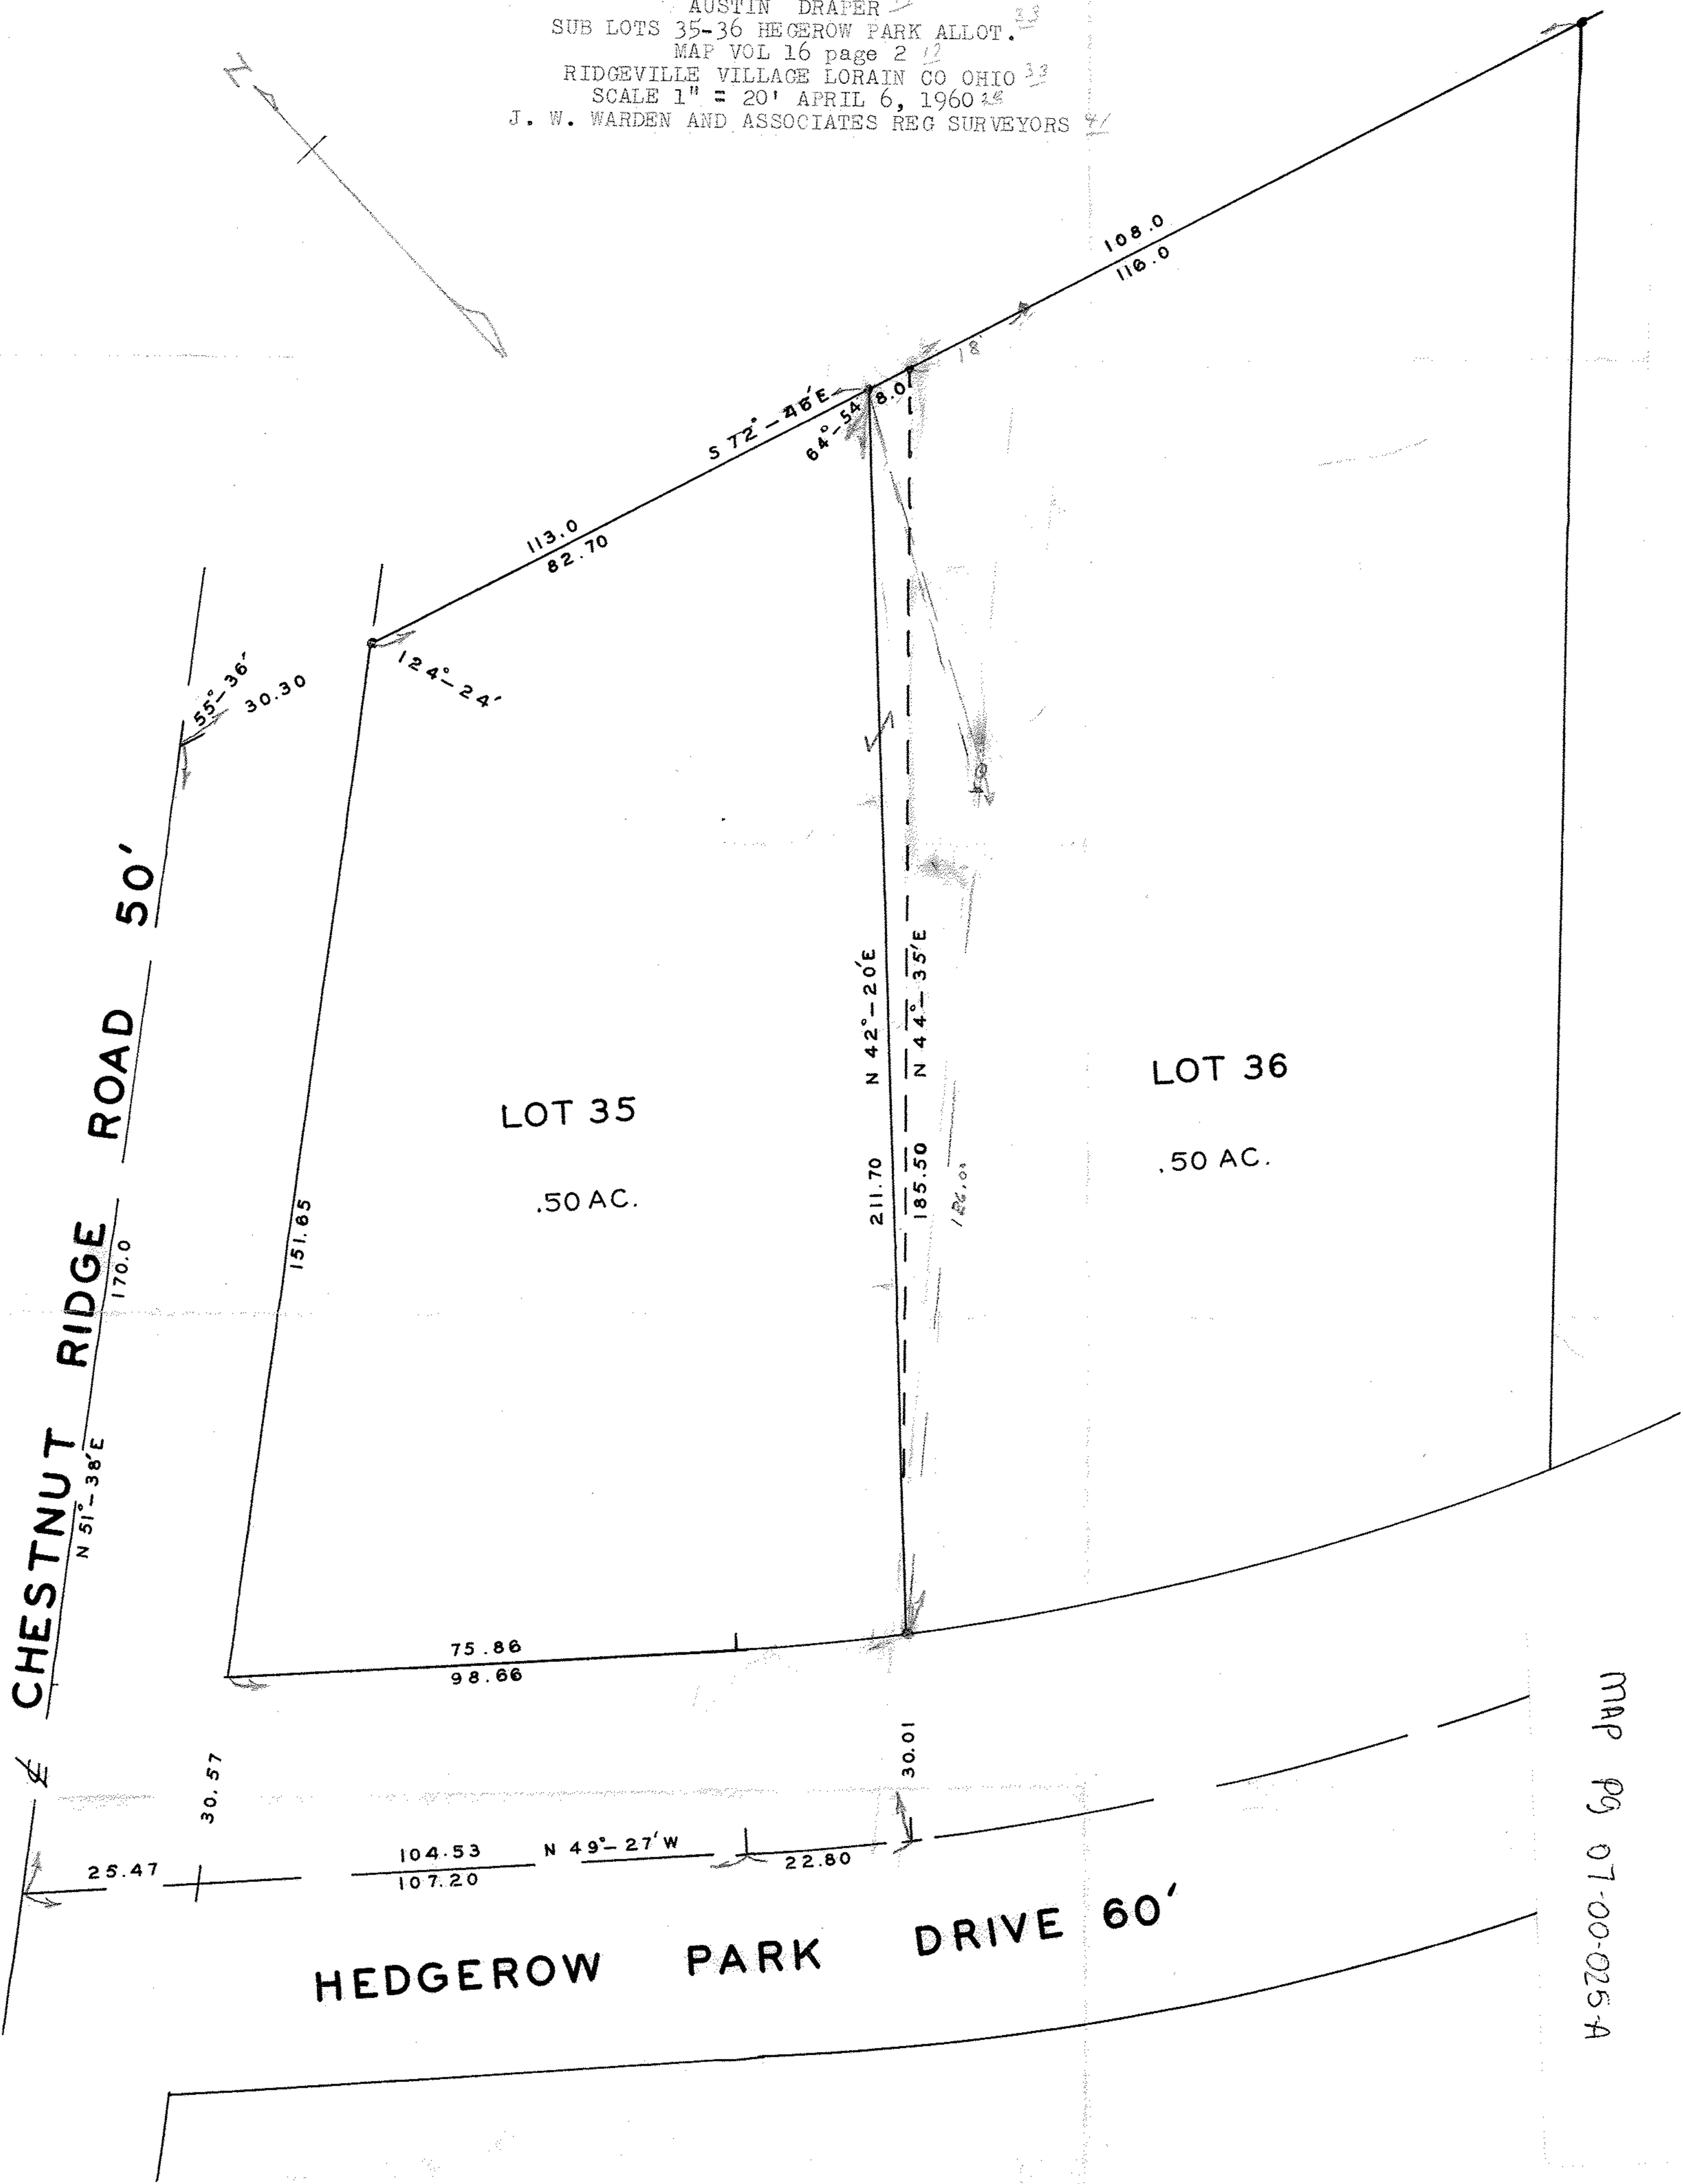

22-1329-2

MAP PG 07-00-025-A

PPN 07-00-025-164-019
020