91-1259

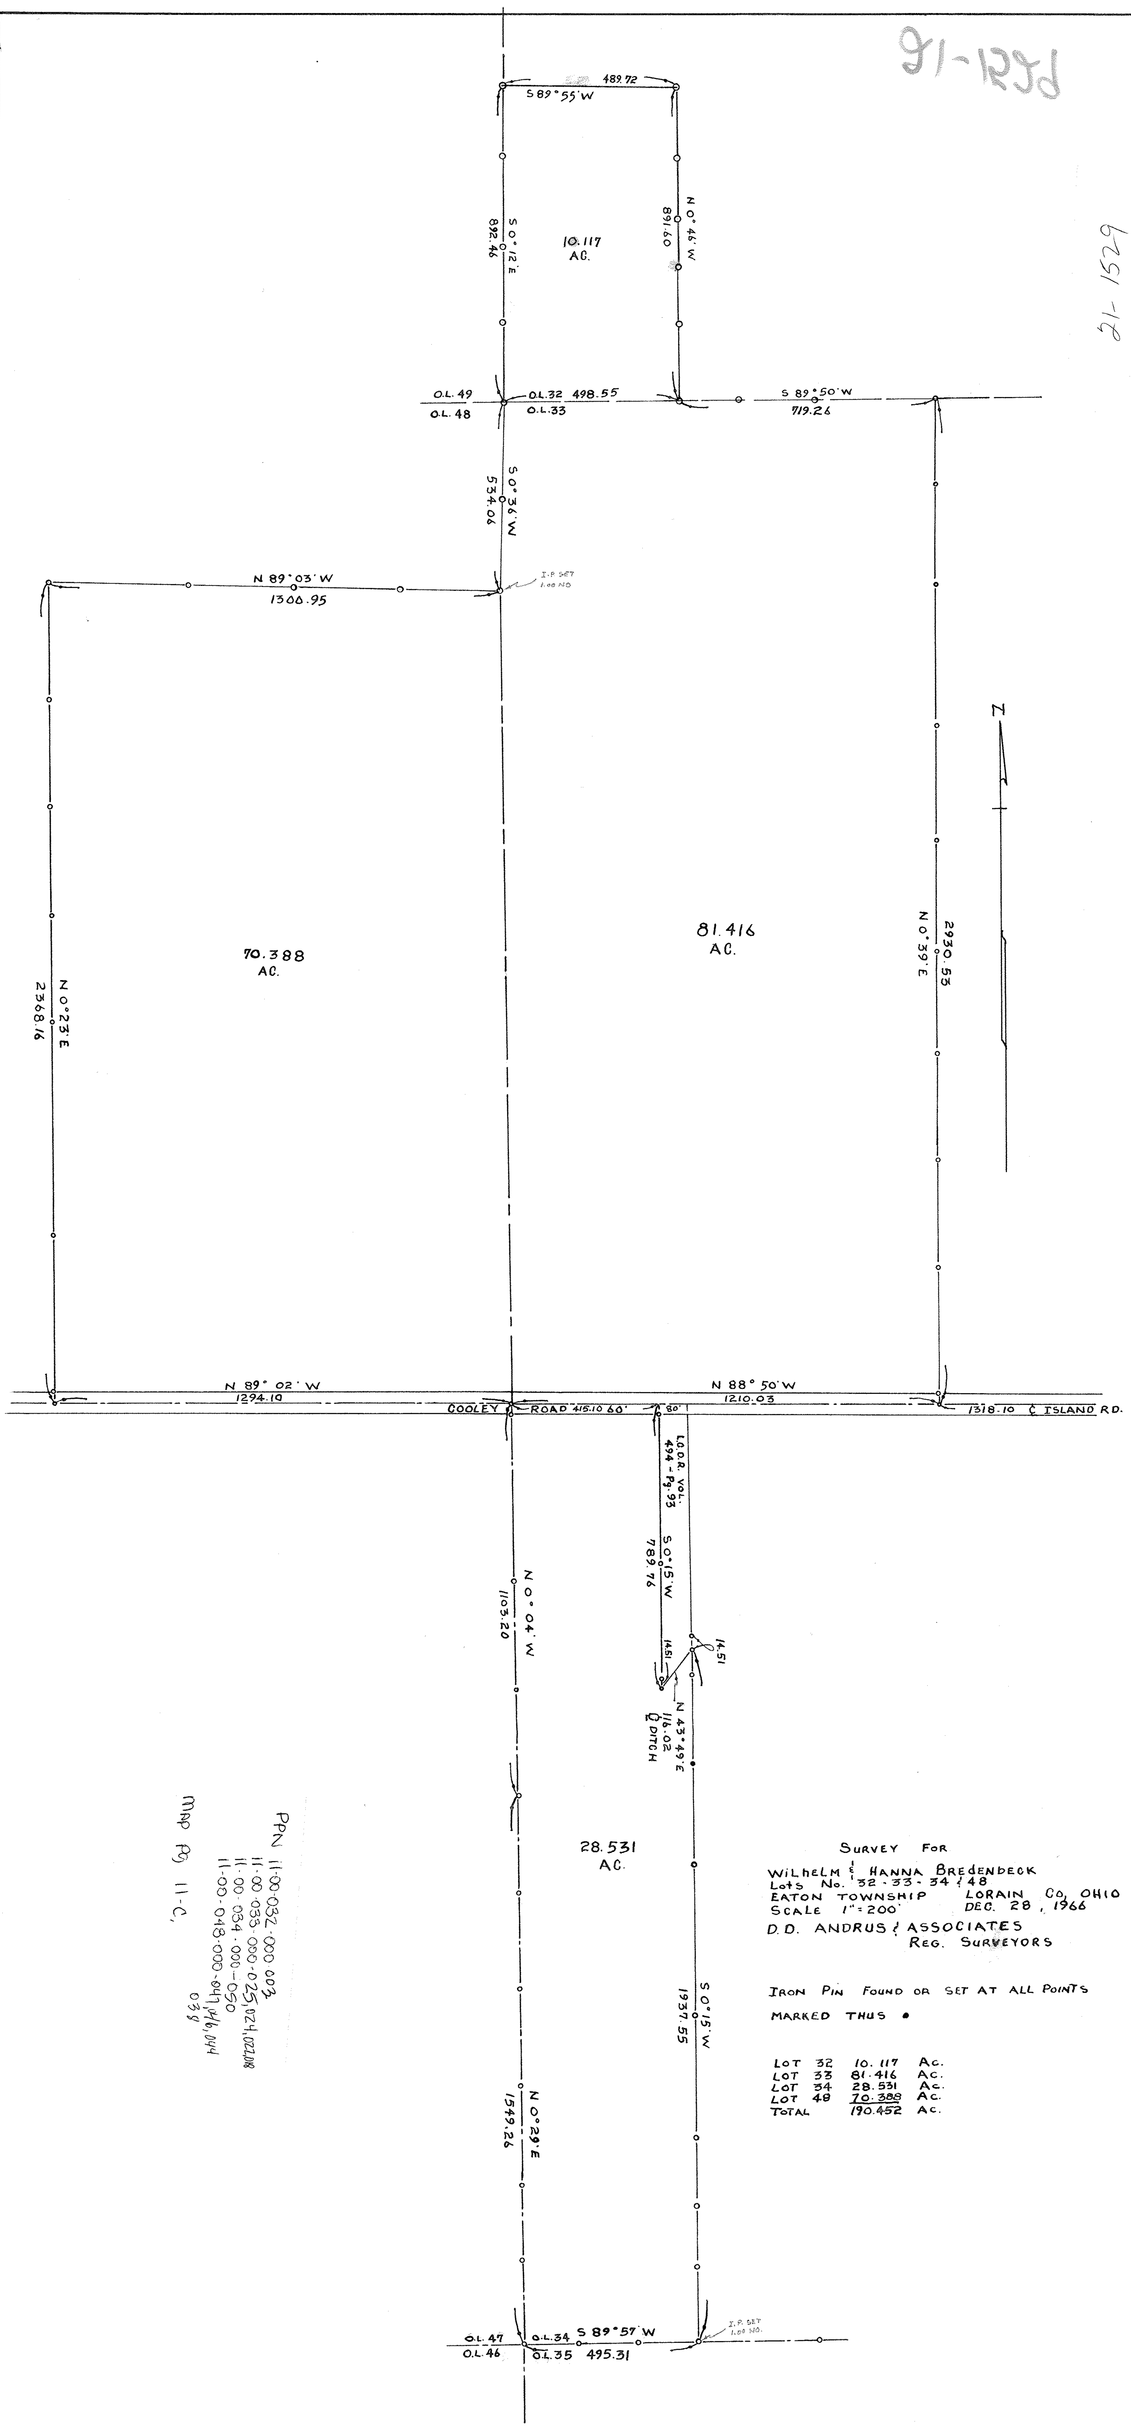

Map Pg 11-C.

PPN 11-00-032-000-003
11-00-033-000-025
11-00-034-000-050
11-00-048-000-040
8/20/08
0.38

SURVEY FOR

WILHELM & HANNA BREDENDECK
LOTS No. 32 - 33 - 34 & 48
EATON TOWNSHIP LORAIN Co, OHIO
SCALE 1" = 200' DEC. 28, 1966

D.D. ANDRUS & ASSOCIATES
REG. SURVEYORS

IRON PIN FOUND OR SET AT ALL POINTS MARKED THUS •

LOT 32	10.117	AC.
LOT 33	81.416	AC.
LOT 34	28.531	AC.
LOT 48	70.388	AC.
TOTAL	190.452	AC.