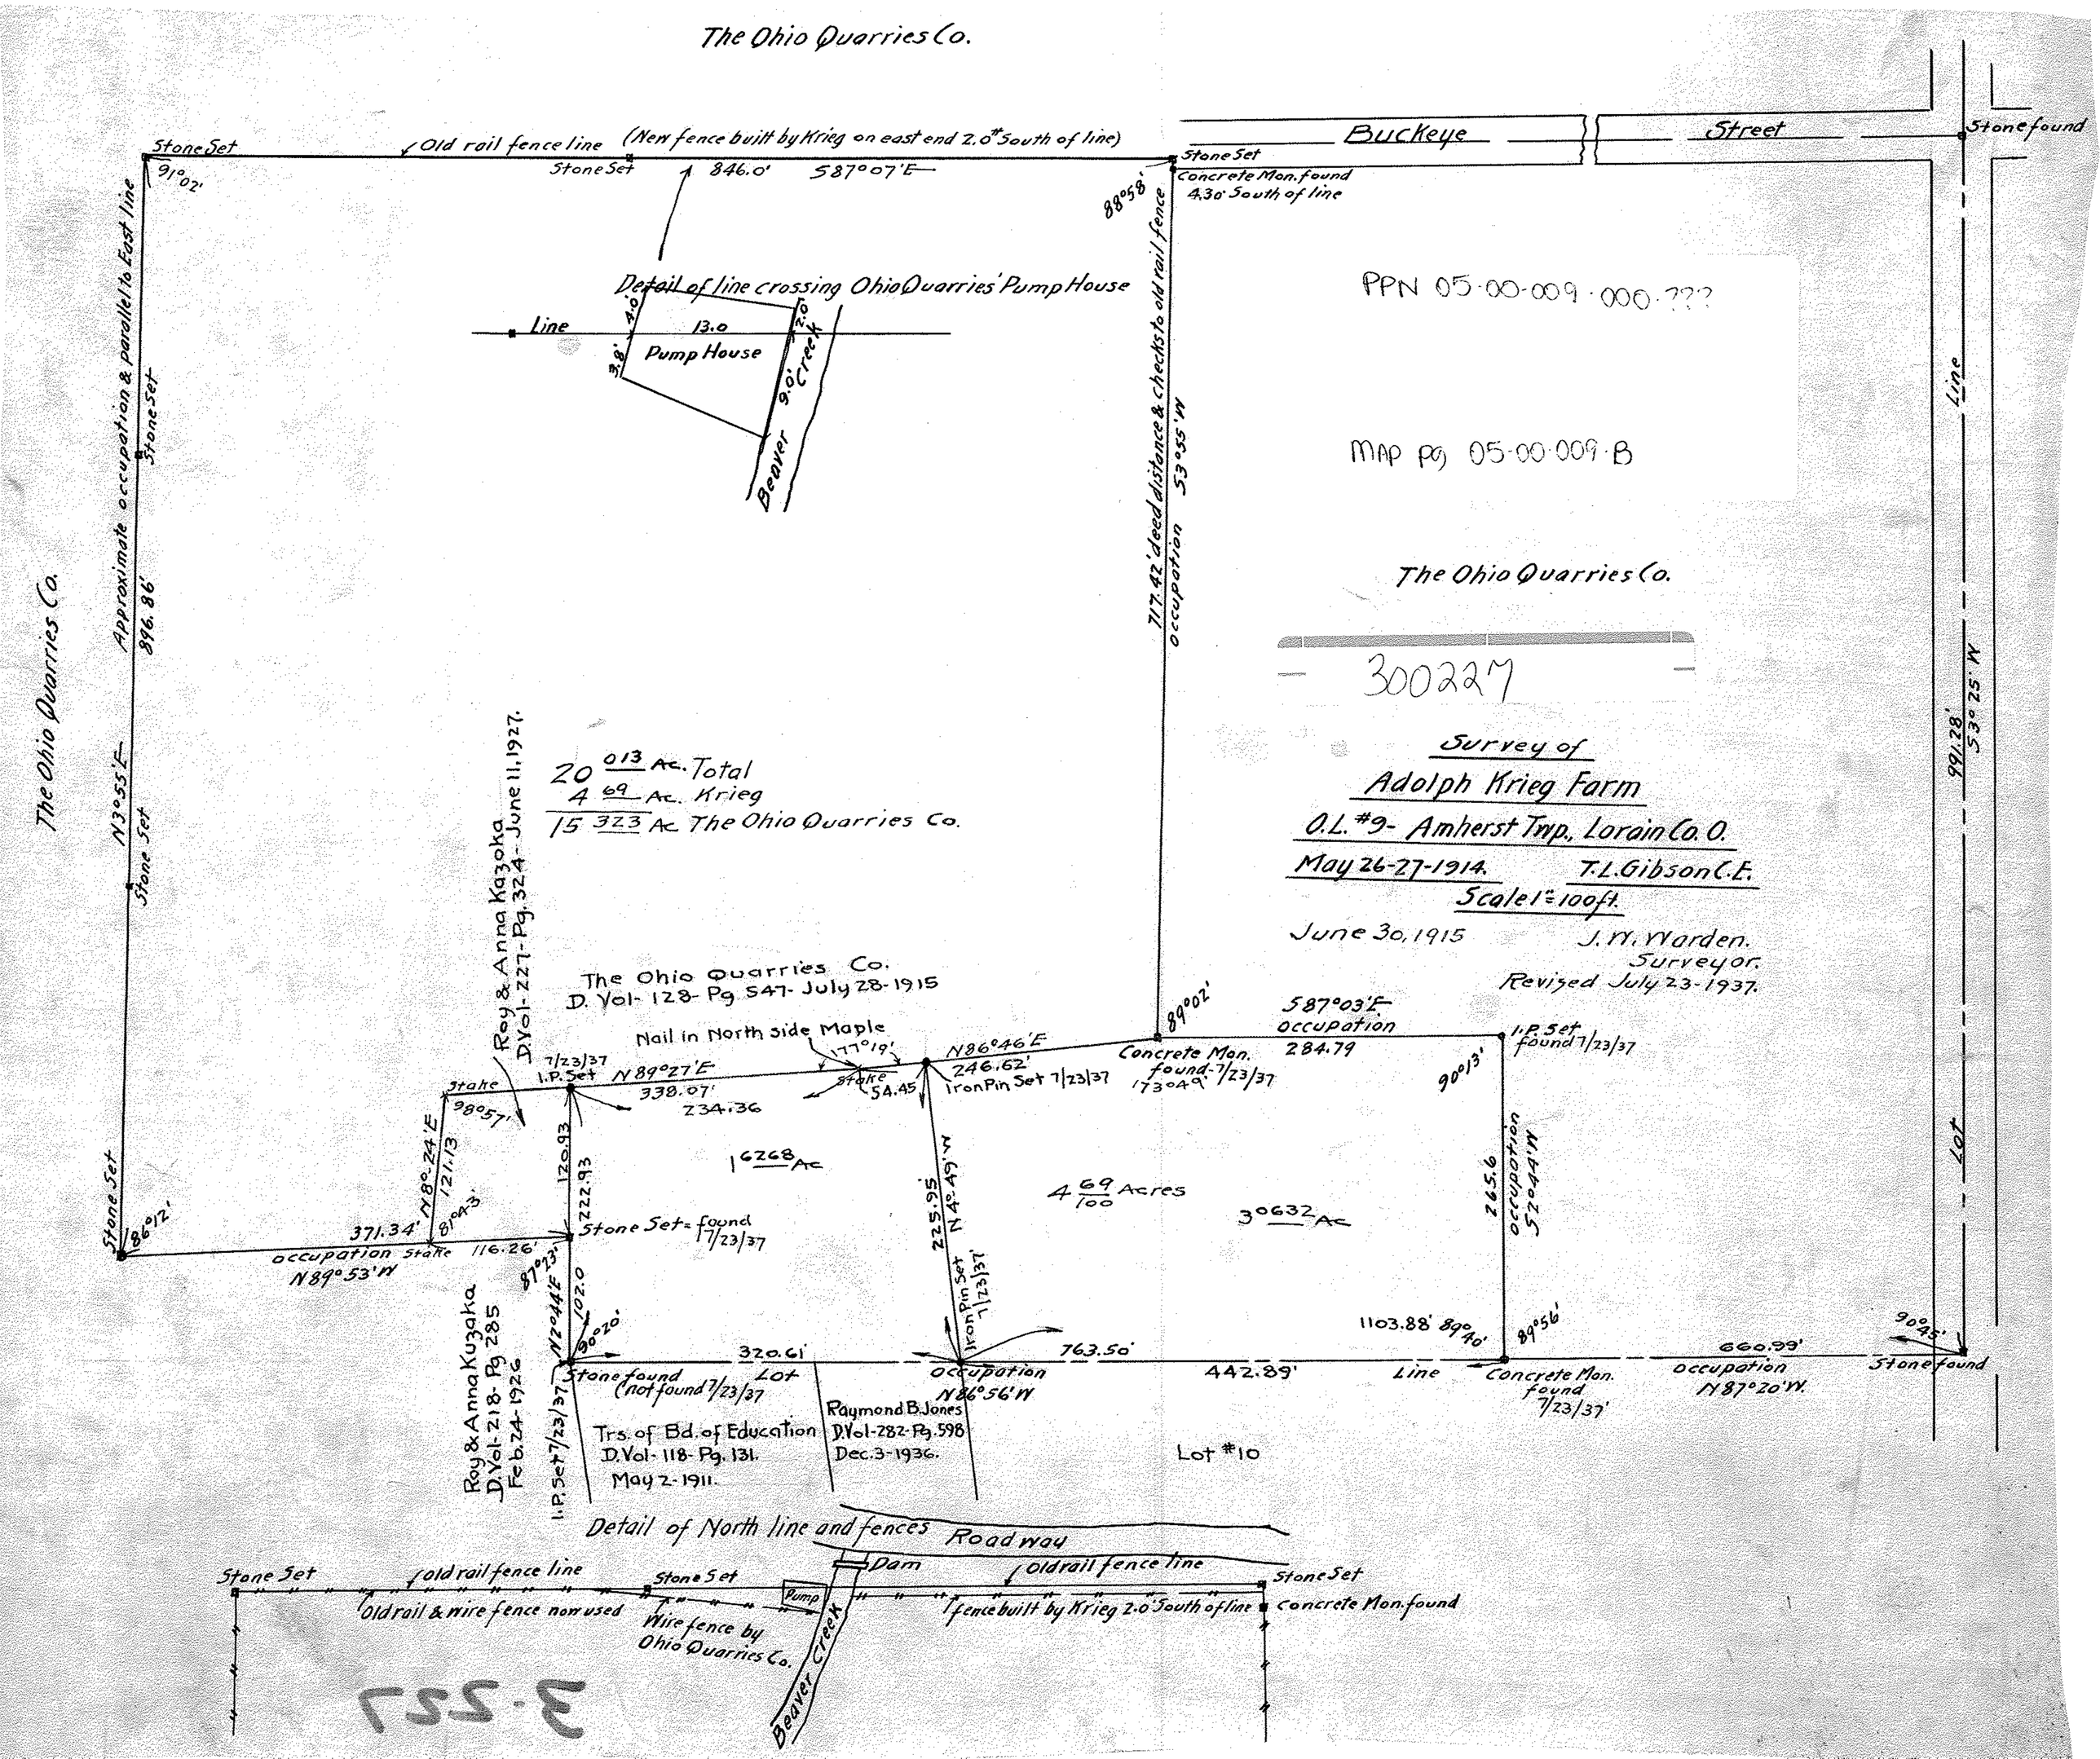
The Ohio Quarries Co.
Buckeye Street
Stone found
Stone Set
Old rail fence line
(New fence built by Krieg on east end 2.0# South of line)
Stone Set
846.0'
S87°07'E
Stone Set
Concrete Mon. found
4.30' South of line
88°58'
91°02'
Detail of line crossing Ohio Quarries' Pump House
Line
13.0
Pump House
Beaver Creek
PPN 05-00-009-000-???
MAP pg 05-00-009-B
The Ohio Quarries Co.
300227
Survey of
Adolph Krieg Farm
O.L. #9- Amherst Twp., Lorain Co. O.
May 26-27-1914.
T.L. Gibson C.E.
Scale 1" = 100 ft.
June 30, 1915
J.W. Warden.
Surveyor.
Revised July 23-1937.
The Ohio Quarries Co.
Approximate occupation & parallel to East line
896.86'
N3°55'E
Stone Set
717.42' deed distance & checks to old rail fence
occupation S3°55'W
991.28'
S3°25'W
Line
Lot
20 013 Ac. Total
4 69 Ac. Krieg
15 323 Ac The Ohio Quarries Co.
Roy & Anna Kazoka
D.Vol-227-Pg.324-June 11, 1927.
The Ohio Quarries Co.
D. Vol-128-Pg 547-July 28-1915
Nail in North side Maple
177°19'
N86°46'E
246.62'
Iron Pin Set 7/23/37
89°02'
Concrete Mon. found-7/23/37
173°49'
S87°03'E
occupation
284.79
I.P. Set found 7/23/37
90°13'
7/23/37
I.P. Set
N89°27'E
338.07'
234.36
Stake
54.45
Stake
98°57'
N8°24'E
121.13
81°43'
120.93
222.93
1 6268 Ac
4 69/100 Acres
3 0632 Ac
265.6
occupation
S2°44'W
Stone Set
86°12'
371.34'
occupation
N89°53'W
Stake
116.26'
Stone Set = found 7/23/37
87°23'
N2°44'E
102.0
90°20'
225.95
N4°49'W
Iron Pin Set 7/23/37
1103.88'
89°40'
89°56'
90°45'
Roy & Anna Kuzaka
D.Vol-218-Pg 285
Feb.24-1926
320.61'
Lot
Stone found
(not found 7/23/37
Occupation
N86°56'W
763.50'
442.89'
Line
Concrete Mon. found 7/23/37
660.99'
occupation
N87°20'W.
Stone found
Trs. of Bd. of Education
D.Vol-118-Pg. 131.
May 2-1911.
Raymond B. Jones
D.Vol-282-Pg.598
Dec.3-1936.
Lot #10
Detail of North line and fences
Roadway
Dam
Stone Set
old rail fence line
Stone Set
Pump
old rail fence line
Stone Set
Old rail & wire fence now used
Wire fence by Ohio Quarries Co.
Beaver Creek
fence built by Krieg 2.0' South of line
Concrete Mon. found
3-227