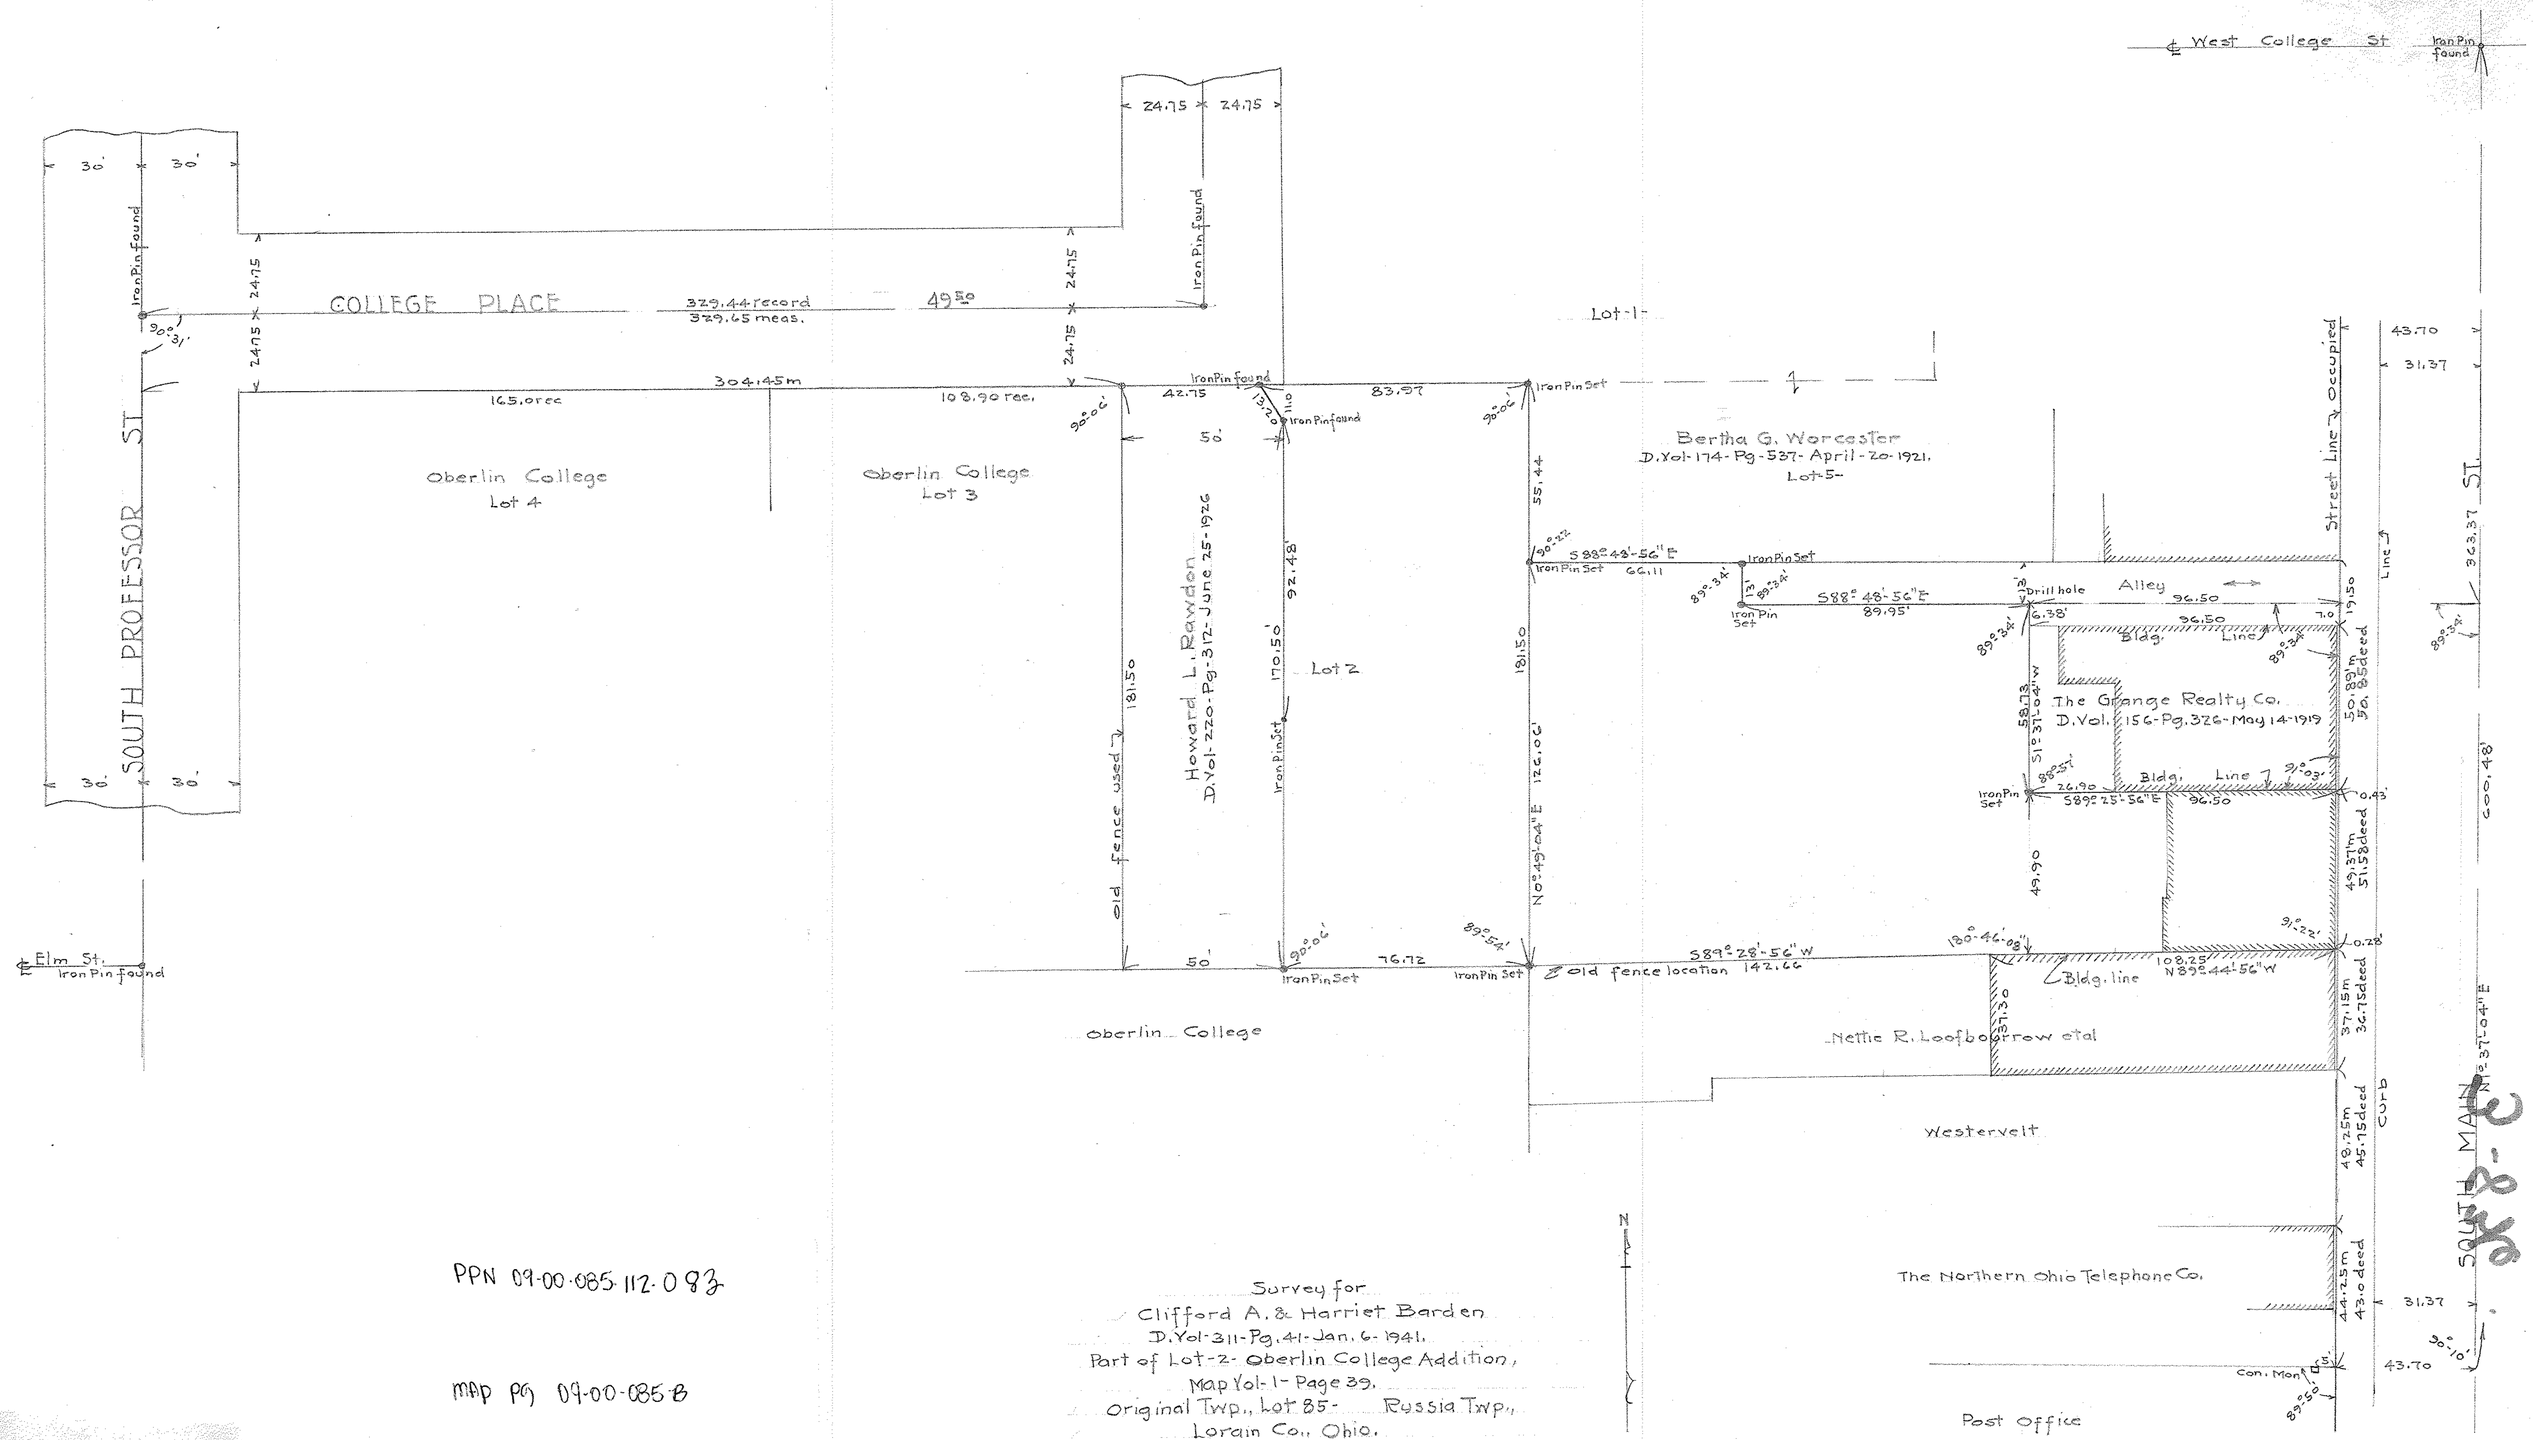

PPN 09-00-085.112.083

map pg 09-00-085-B

Survey for
Clifford A. & Harriet Barden
D. Vol-311-Pg. 41-Jan. 6-1941.
Part of Lot-2- Oberlin College Addition,
Map Vol-1- Page 39.
Original Twp., Lot 85- Russia Twp.,
Lorain Co., Ohio.
Scale 1" = 30' Aug. 6-1941.
J. W. Warden. Registered Surveyor.

— 300836 —