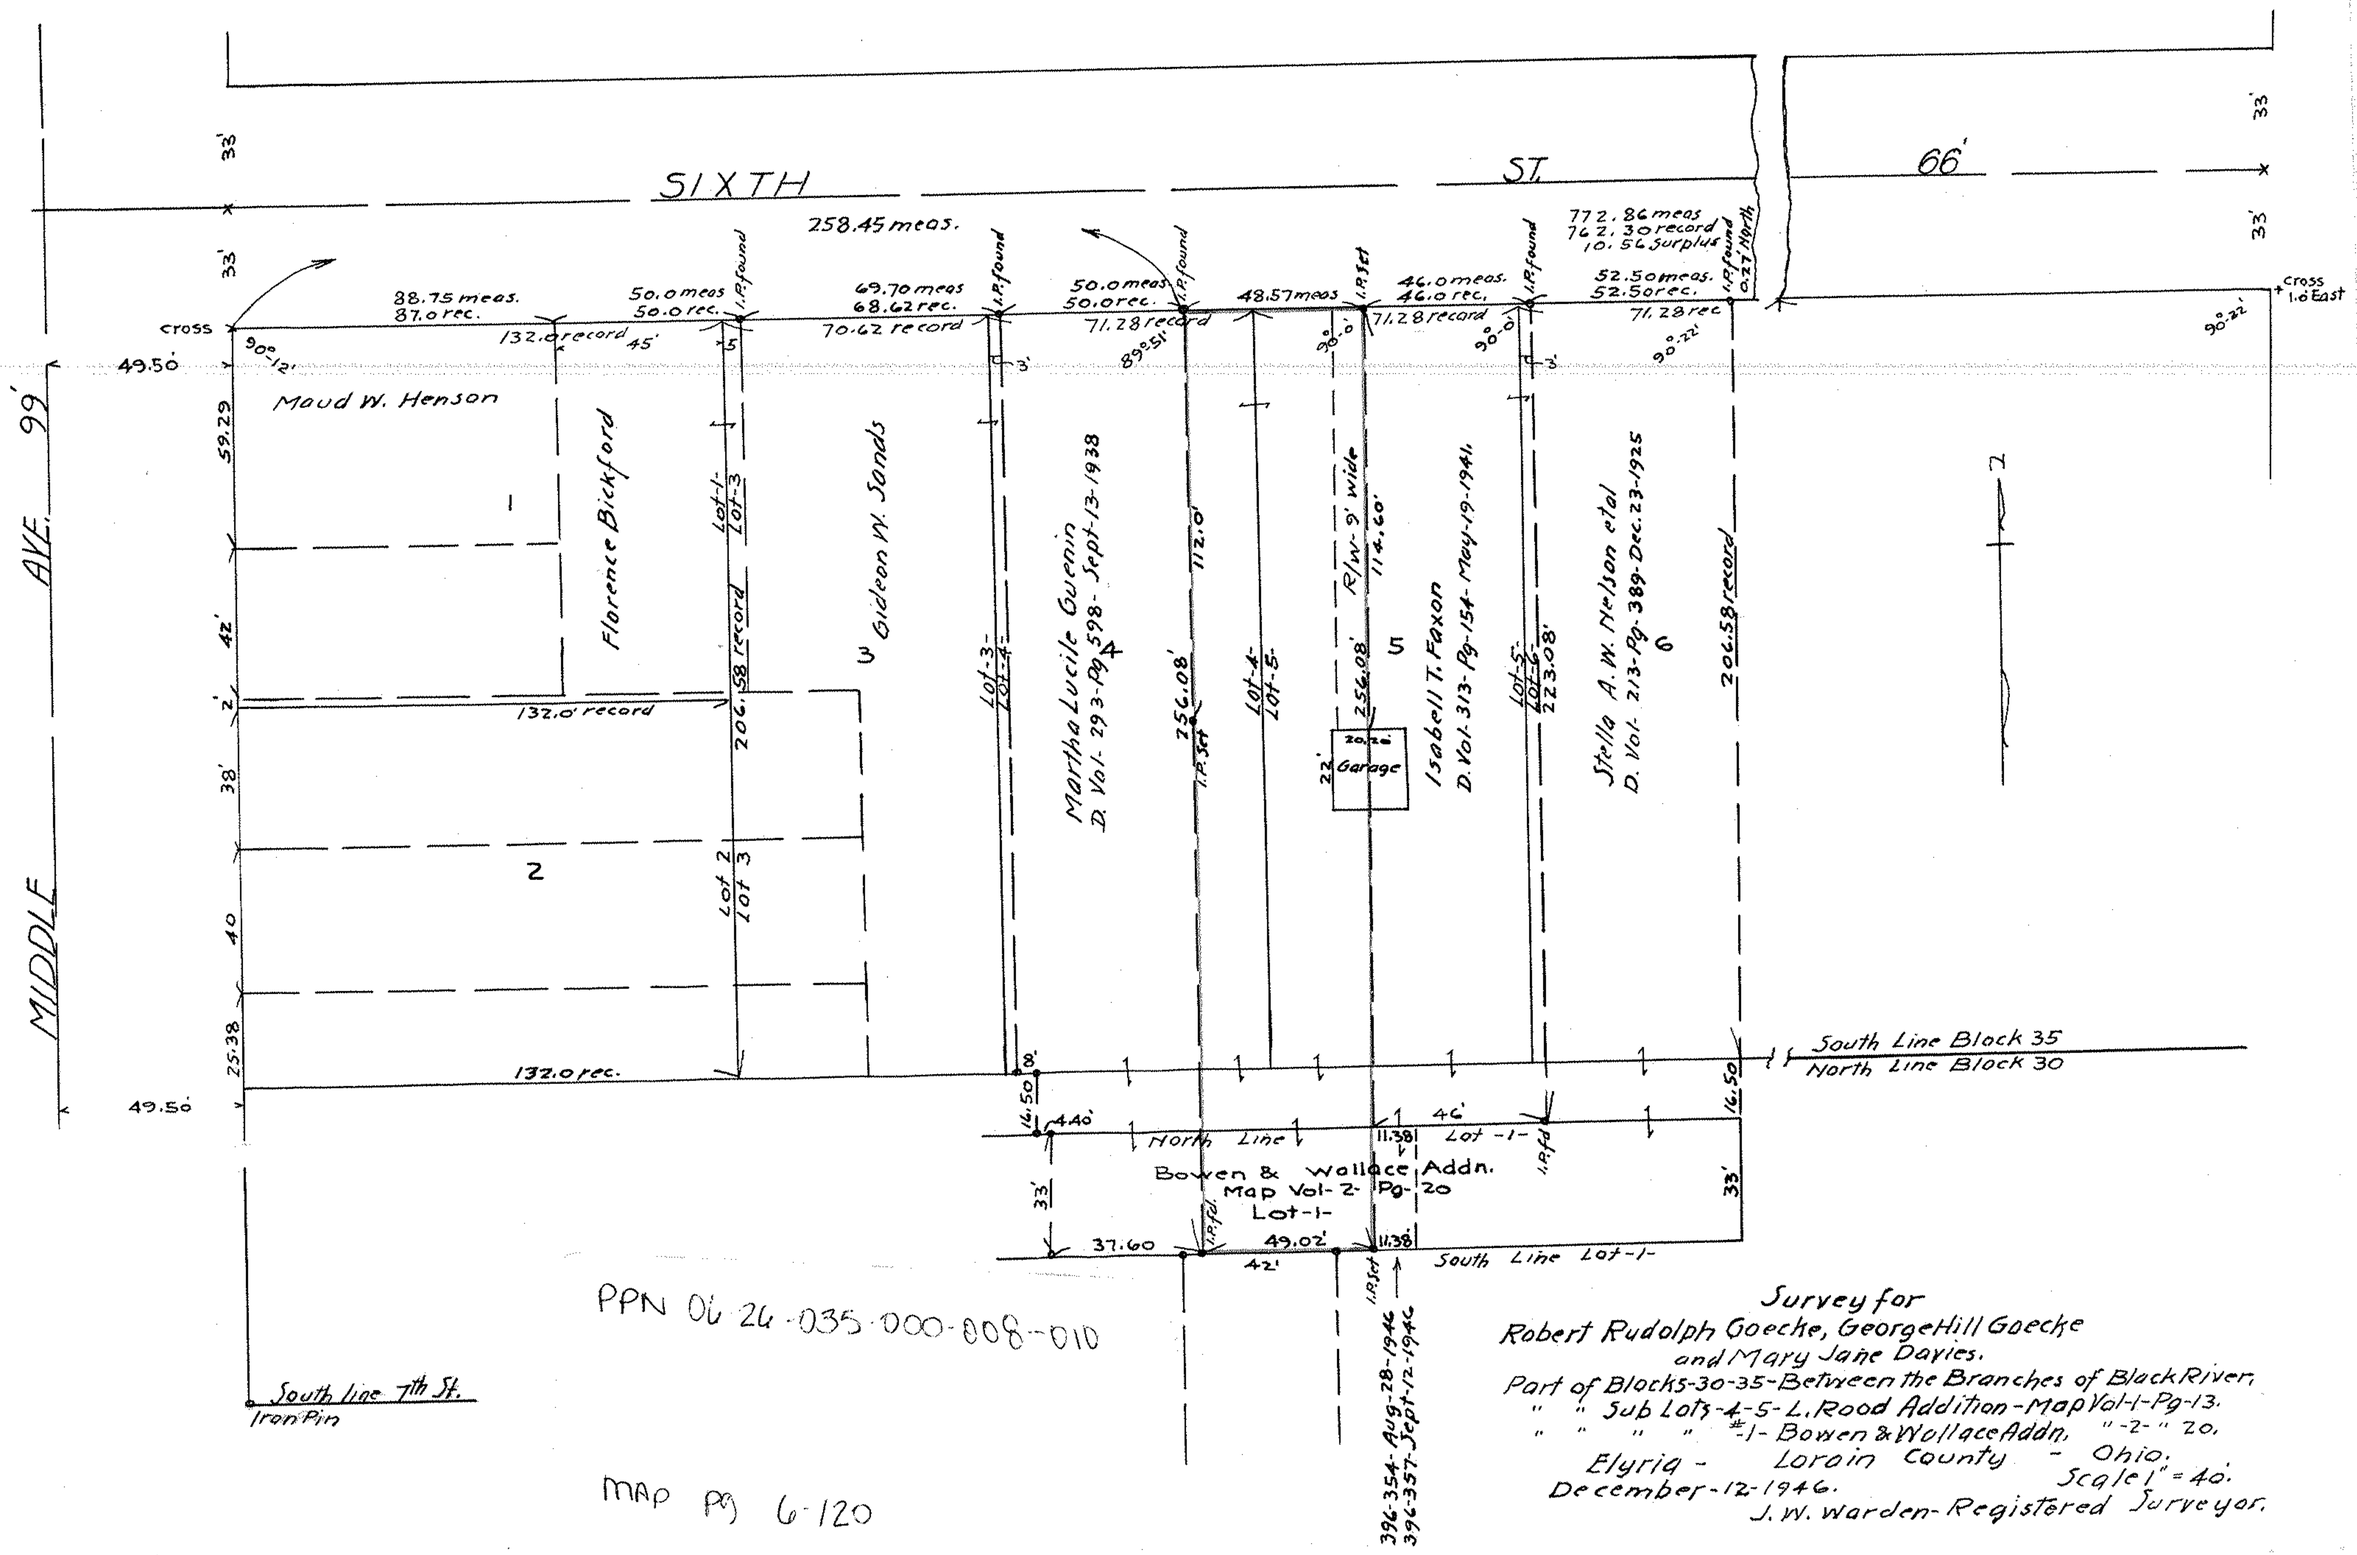

Survey for
Robert Rudolph Goecke, George Hill Goecke
and Mary Jane Davies.
Part of Blocks-30-35-Between the Branches of Black River.
" " Sub Lots-4-5-L. Rood Addition-Map Vol-1-Pg-13.
" " " " #-1- Bowen & Wallace Addn. "-2-" 20.
Elyria - Lorain County - Ohio.
December-12-1946. Scale 1" = 40'.
J. W. Warden-Registered Surveyor.