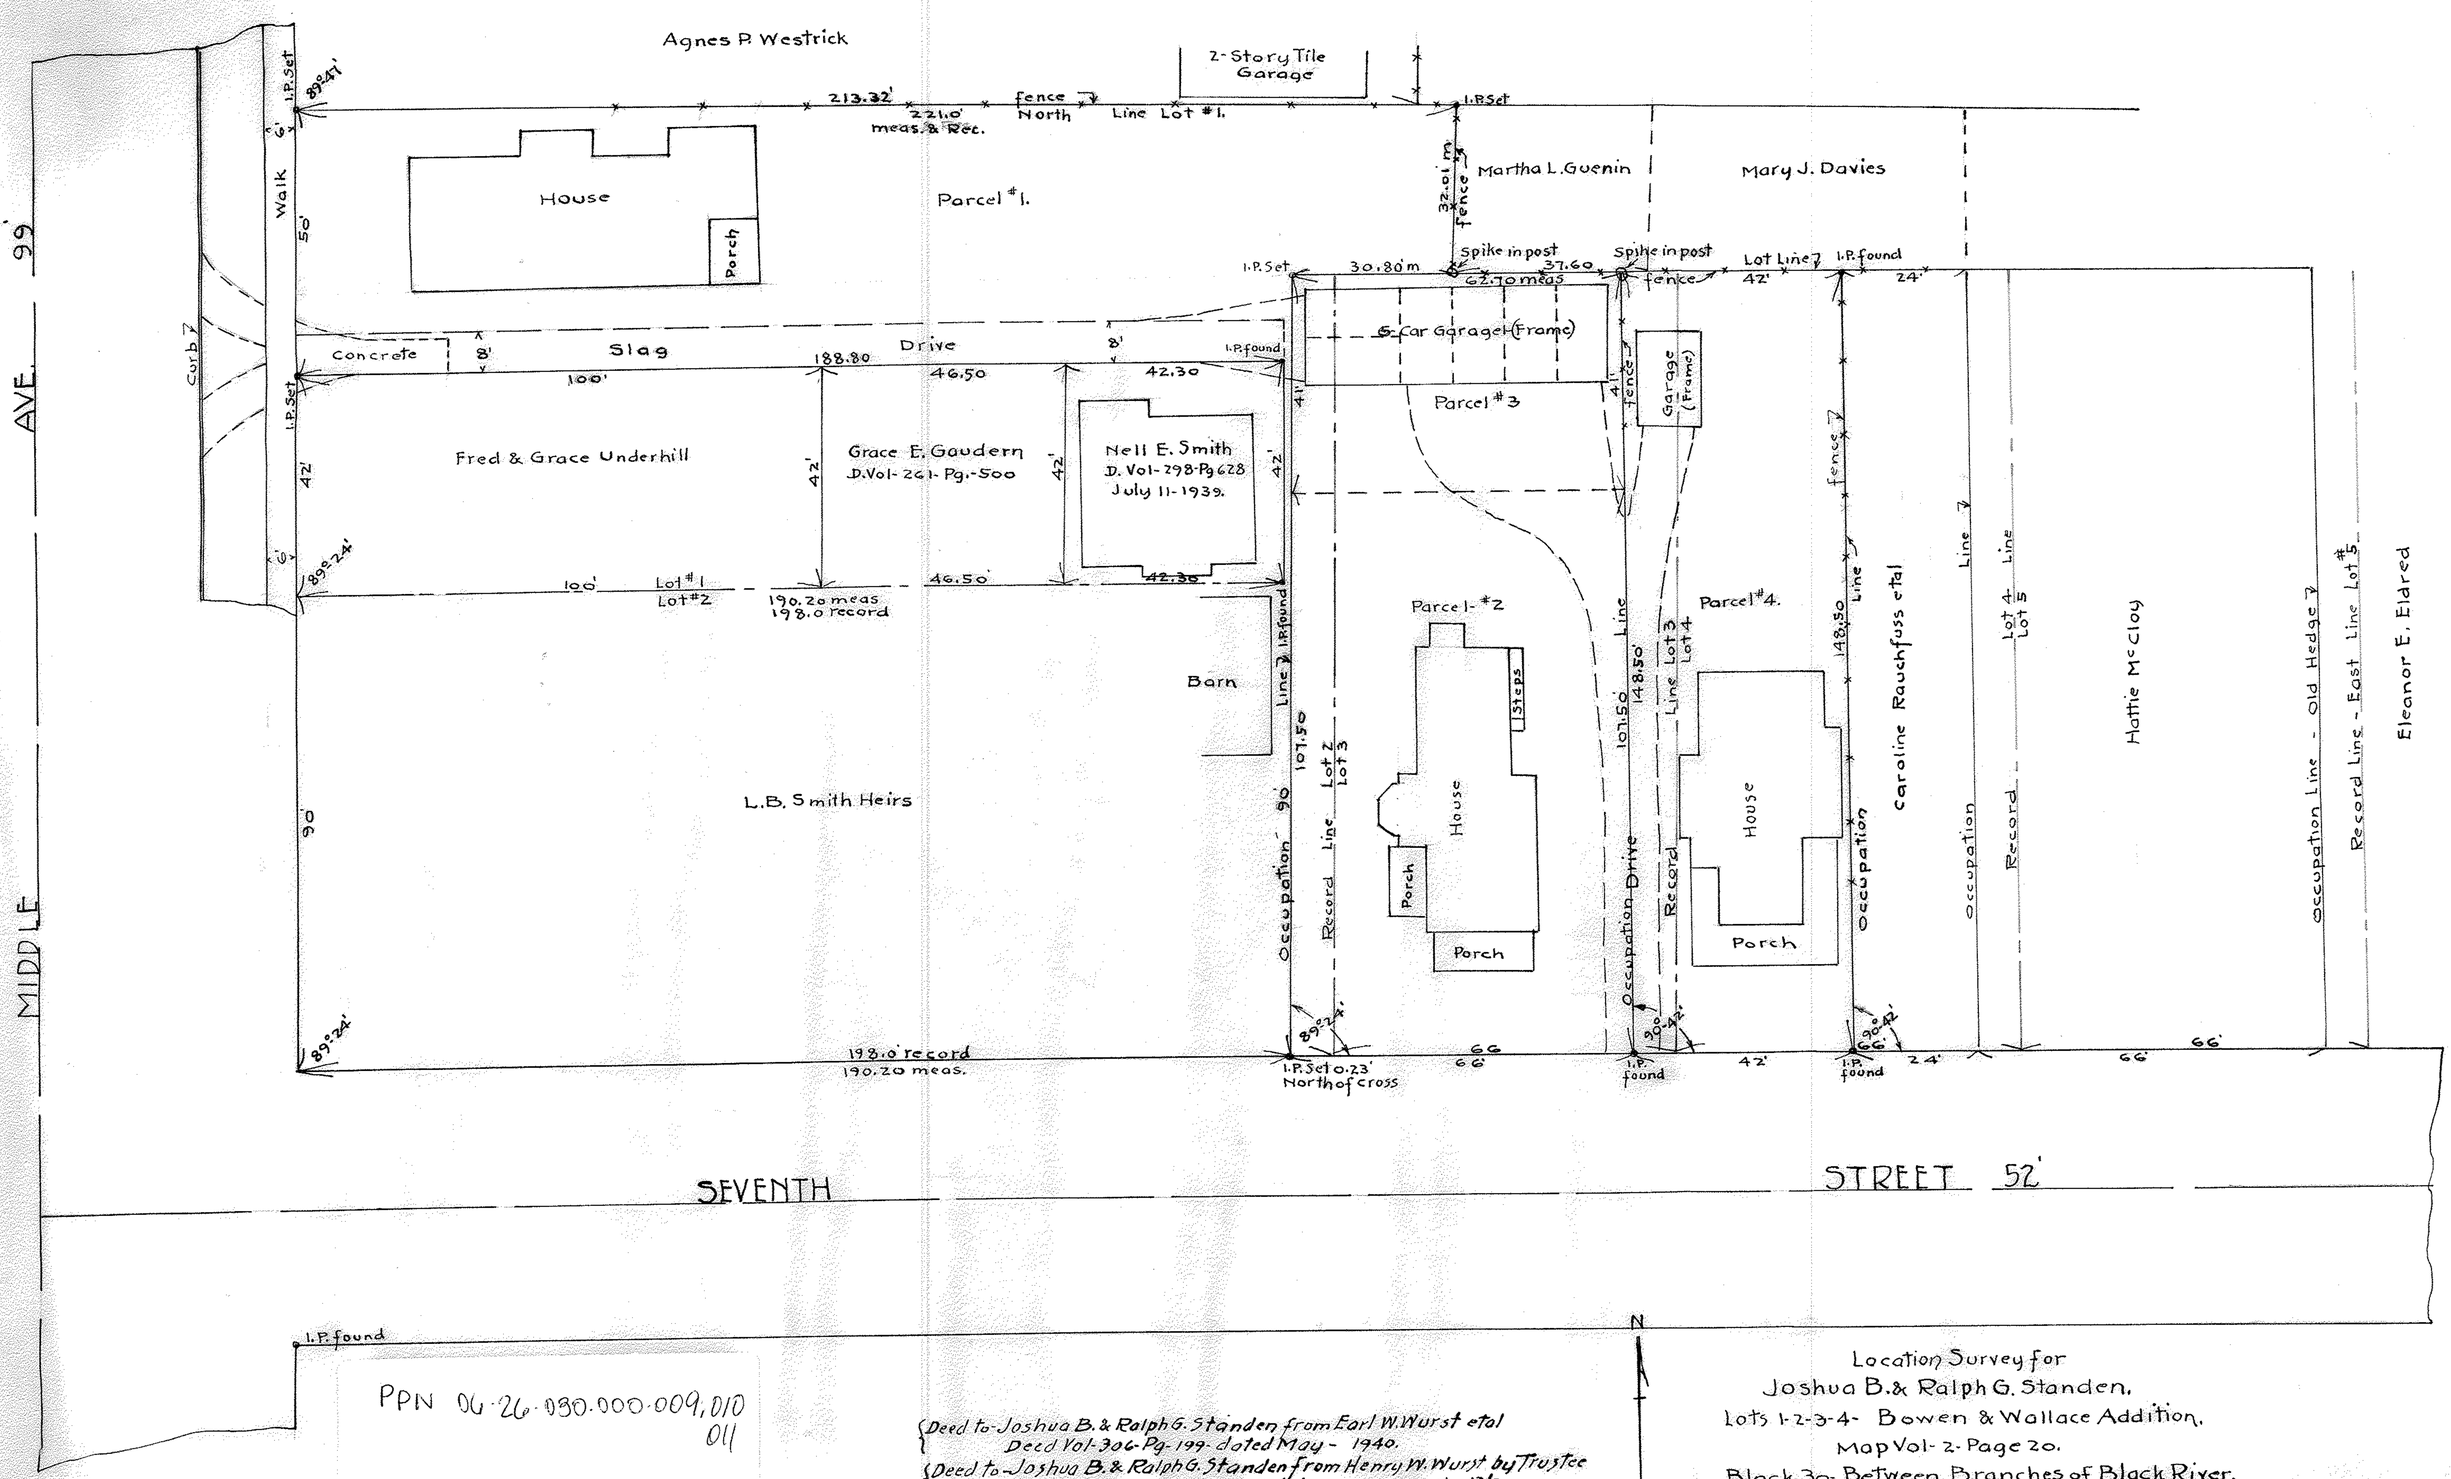
Agnes P. Westrick
2-Story Tile Garage
I.P. Set
S89°47'
213.32'
221.0' meas. & Rec.
fence
North Line Lot #1.
I.P. Set
House
Porch
Parcel #1.
32.01 m
fence
Martha L. Guenin
Mary J. Davies
Walk
6'
50'
Curb
I.P. Set
30.80 m
Spike in post
37.60
62.70 meas
Spike in post
Lot Line
I.P. found
42'
24'
fence
Concrete
8'
Slag
Drive
188.80
46.50
8'
42.30
I.P. found
100'
6-Car Garage (Frame)
Parcel #3
41'
fence
Garage (Frame)
Fred & Grace Underhill
42'
Grace E. Gaudern
Nell E. Smith
D. Vol-298-Pg 628
July 11-1939.
42'
42'
42'
fence
6'
S89°24'
100'
Lot #1
Lot #2
190.20 meas
198.0 record
46.50
42.30
I.P. found
Parcel-#2
Steps
Parcel #4.
148.50
Line
Line
Line