PPN
12-00-043-000-012-067,016
12-00-042-000-059
12-00-039-000-070
MAP PG 12-00-043-B 039A 039A

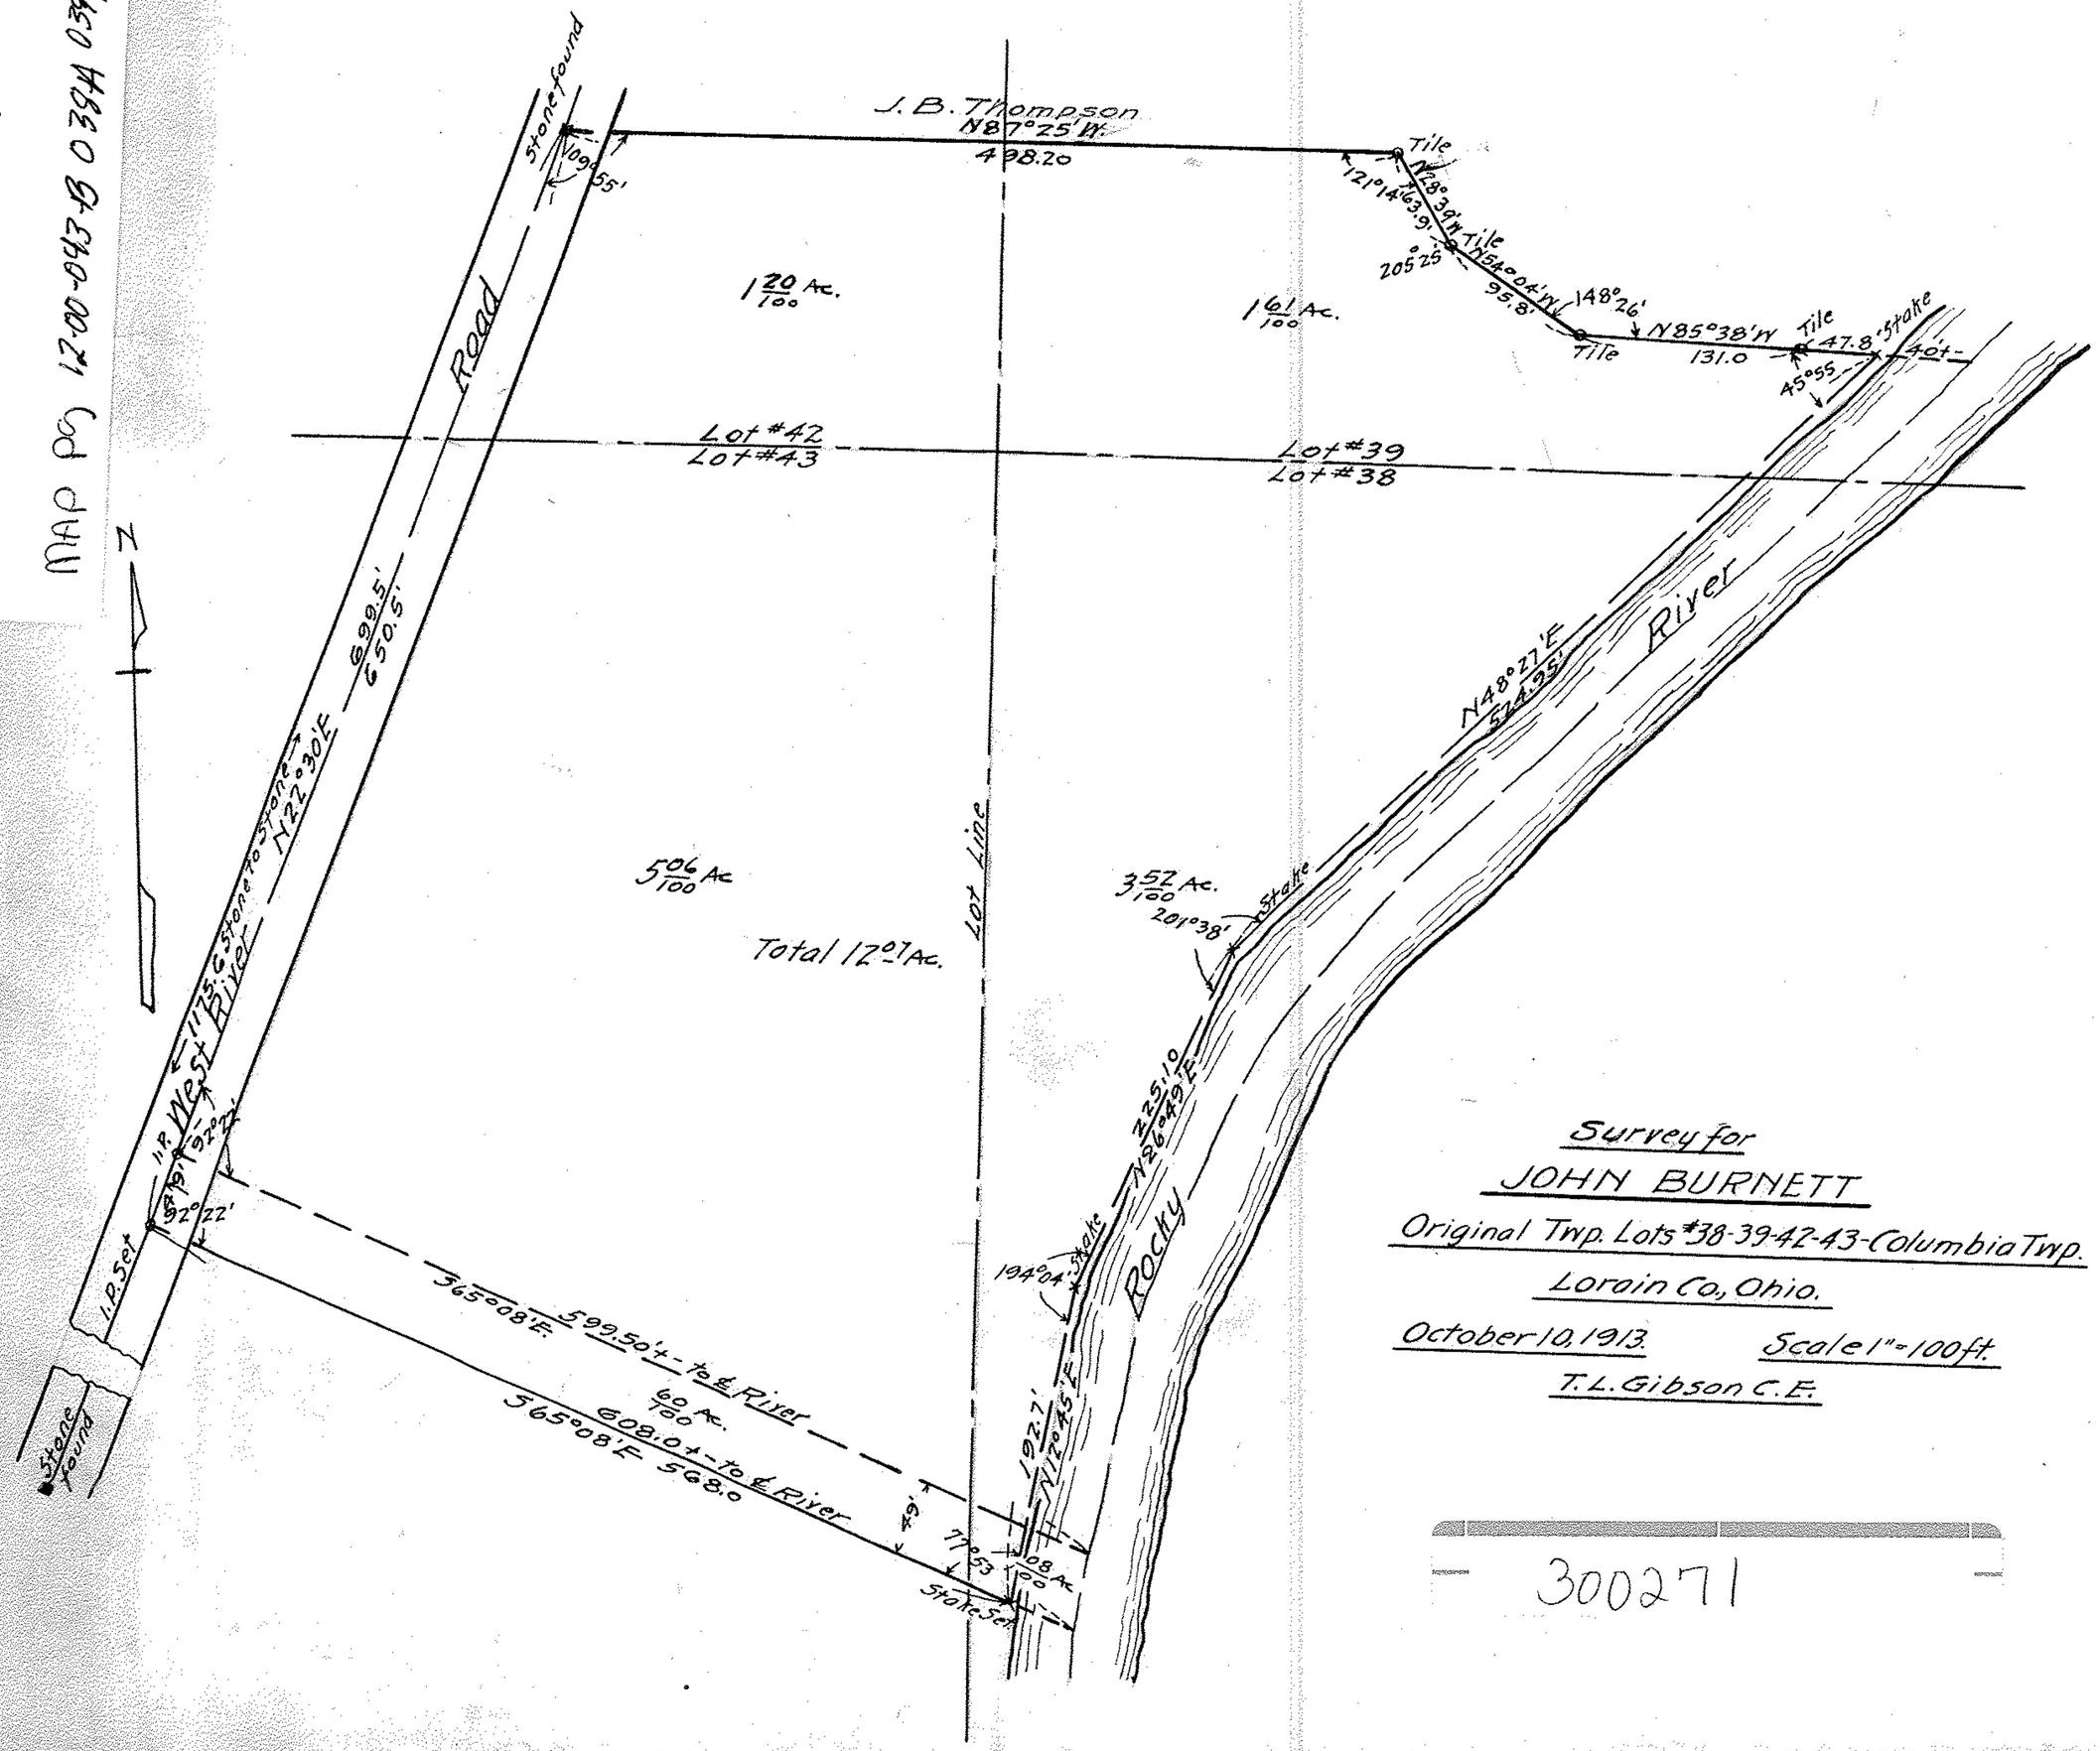

Survey for
JOHN BURNETT
Original Twp. Lots #38-39-42-43-Columbia Twp.
Lorain Co., Ohio.
October 10, 1913. Scale 1"=100 ft.
T. L. Gibson C.E.

300271

3-8-11