Survey for
ALBERT BRING ET AL
Lots 9 and 10 LaGrange Twp.
Lorain Co. Ohio.
April 6. 1925.

Scale 1 inch = 100 ft.
Brandon & Landon
Civil Engineers.

PPN 15-00-010-000 - 017, 020, 021
15-00-009-000 - 036, 037
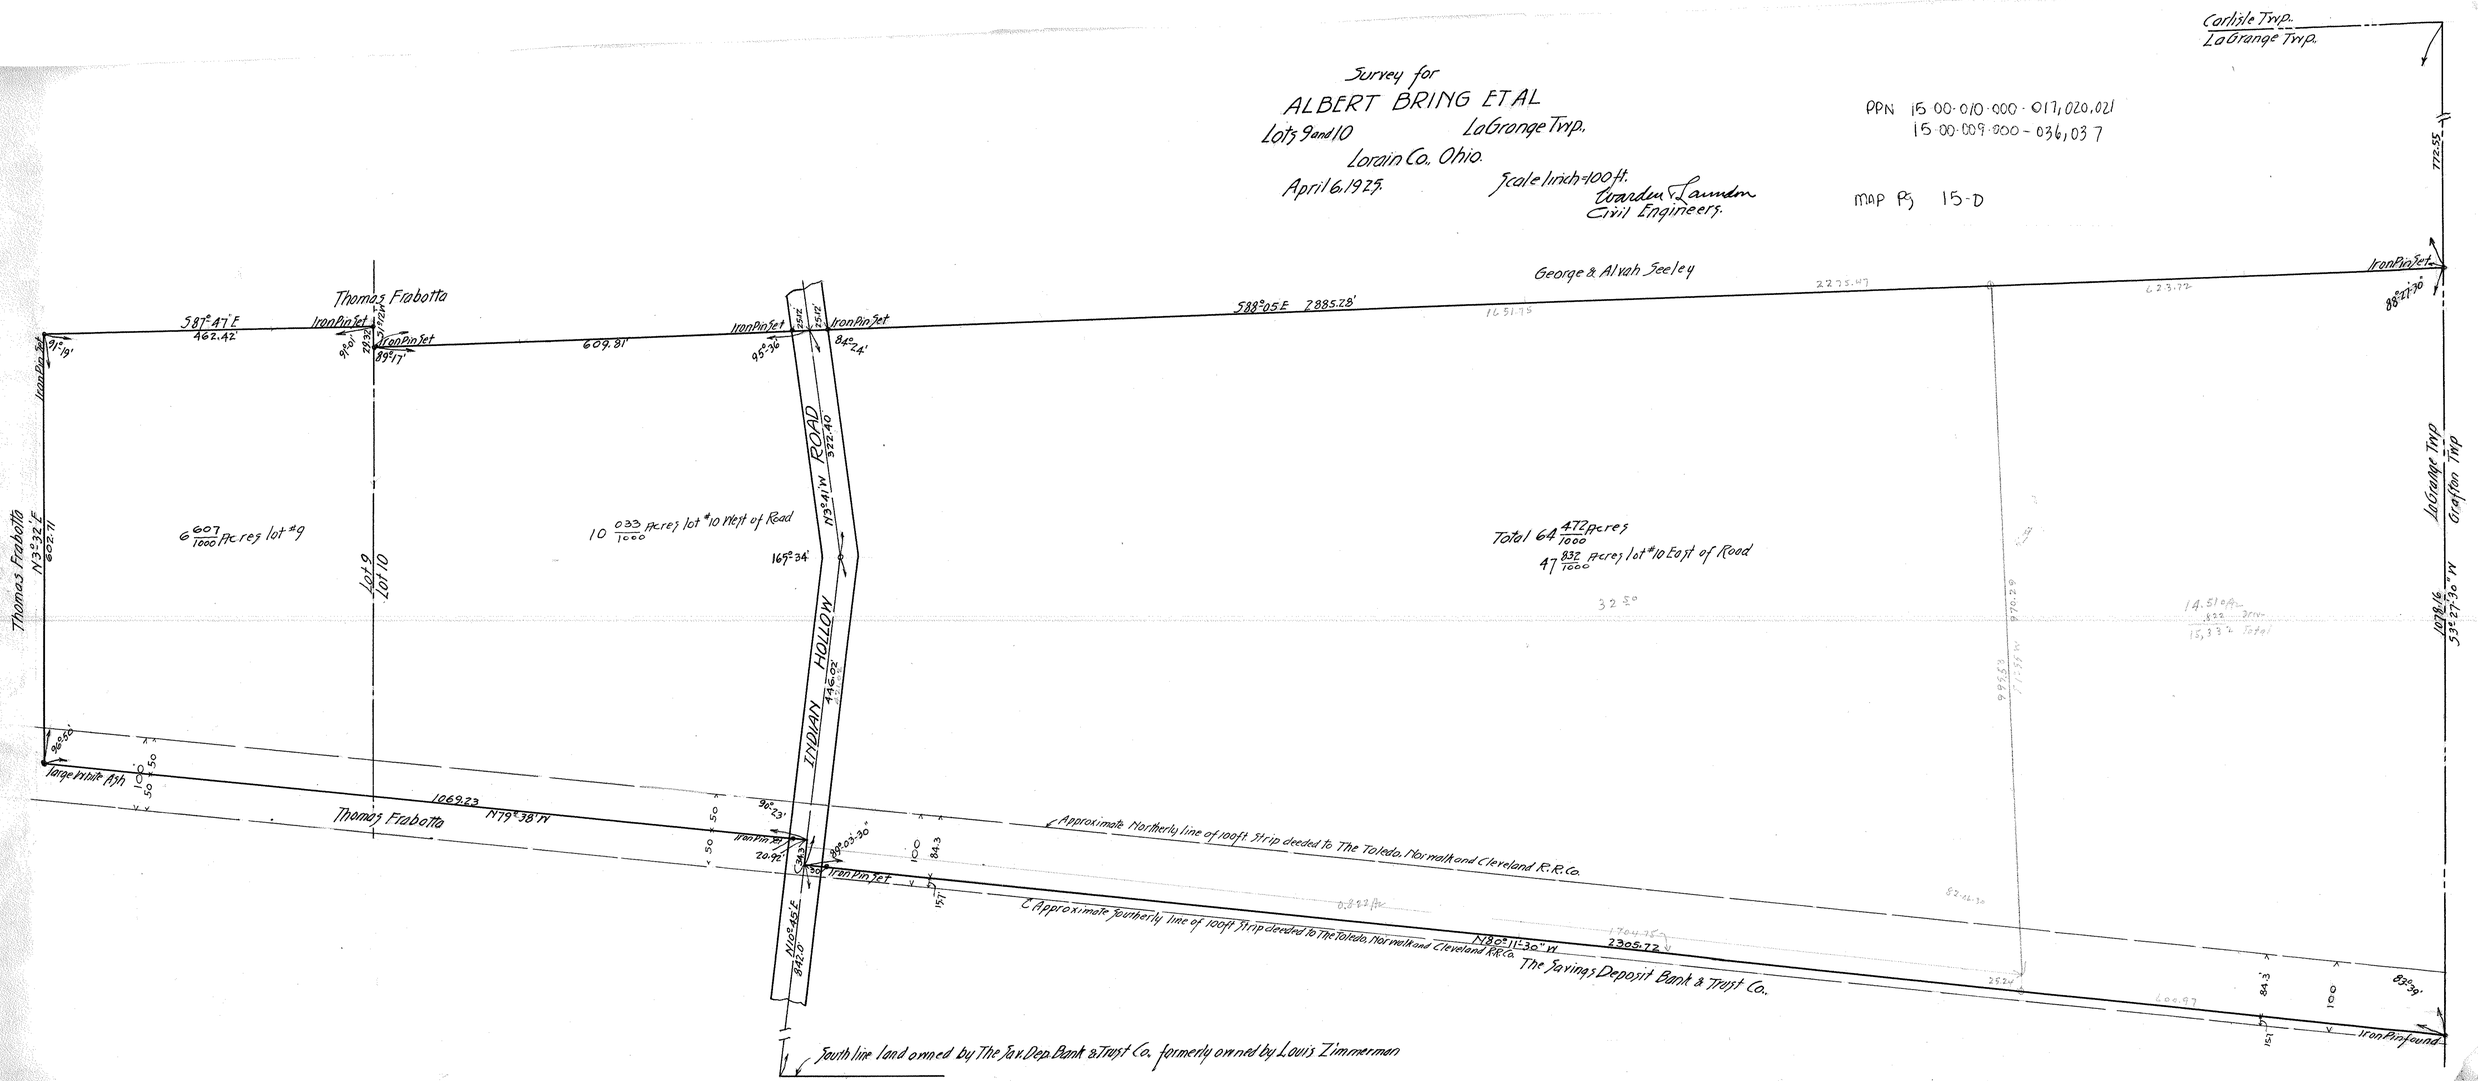
MAP Pg 15-D