PPN 07-00-004-110-???

MAP PG 07-00-004-D
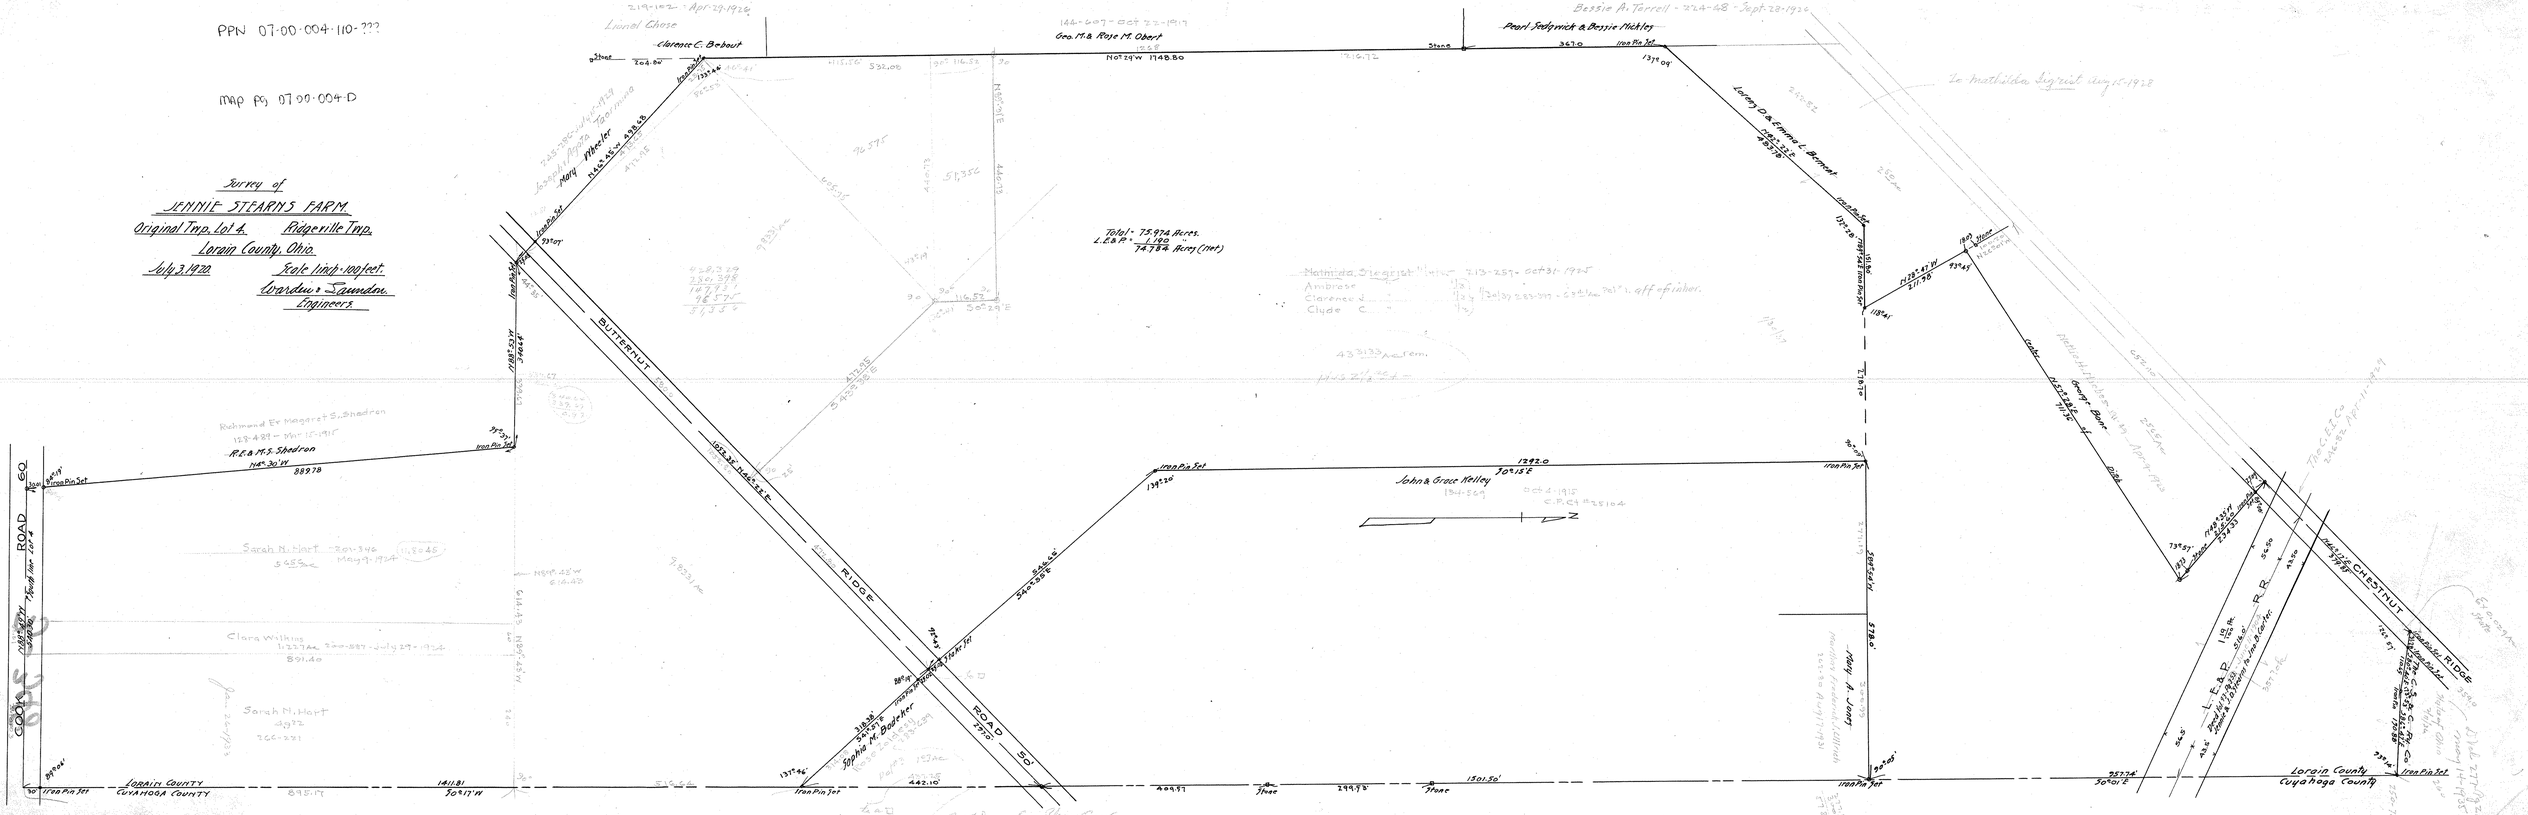
Survey of
JENNIE STEARNS FARM
Original Twp. Lot 4. Ridgeville Twp.
Lorain County, Ohio.
July 3 1920 Scale 1 inch = 100 feet.
Chardeus Saunders
Engineers