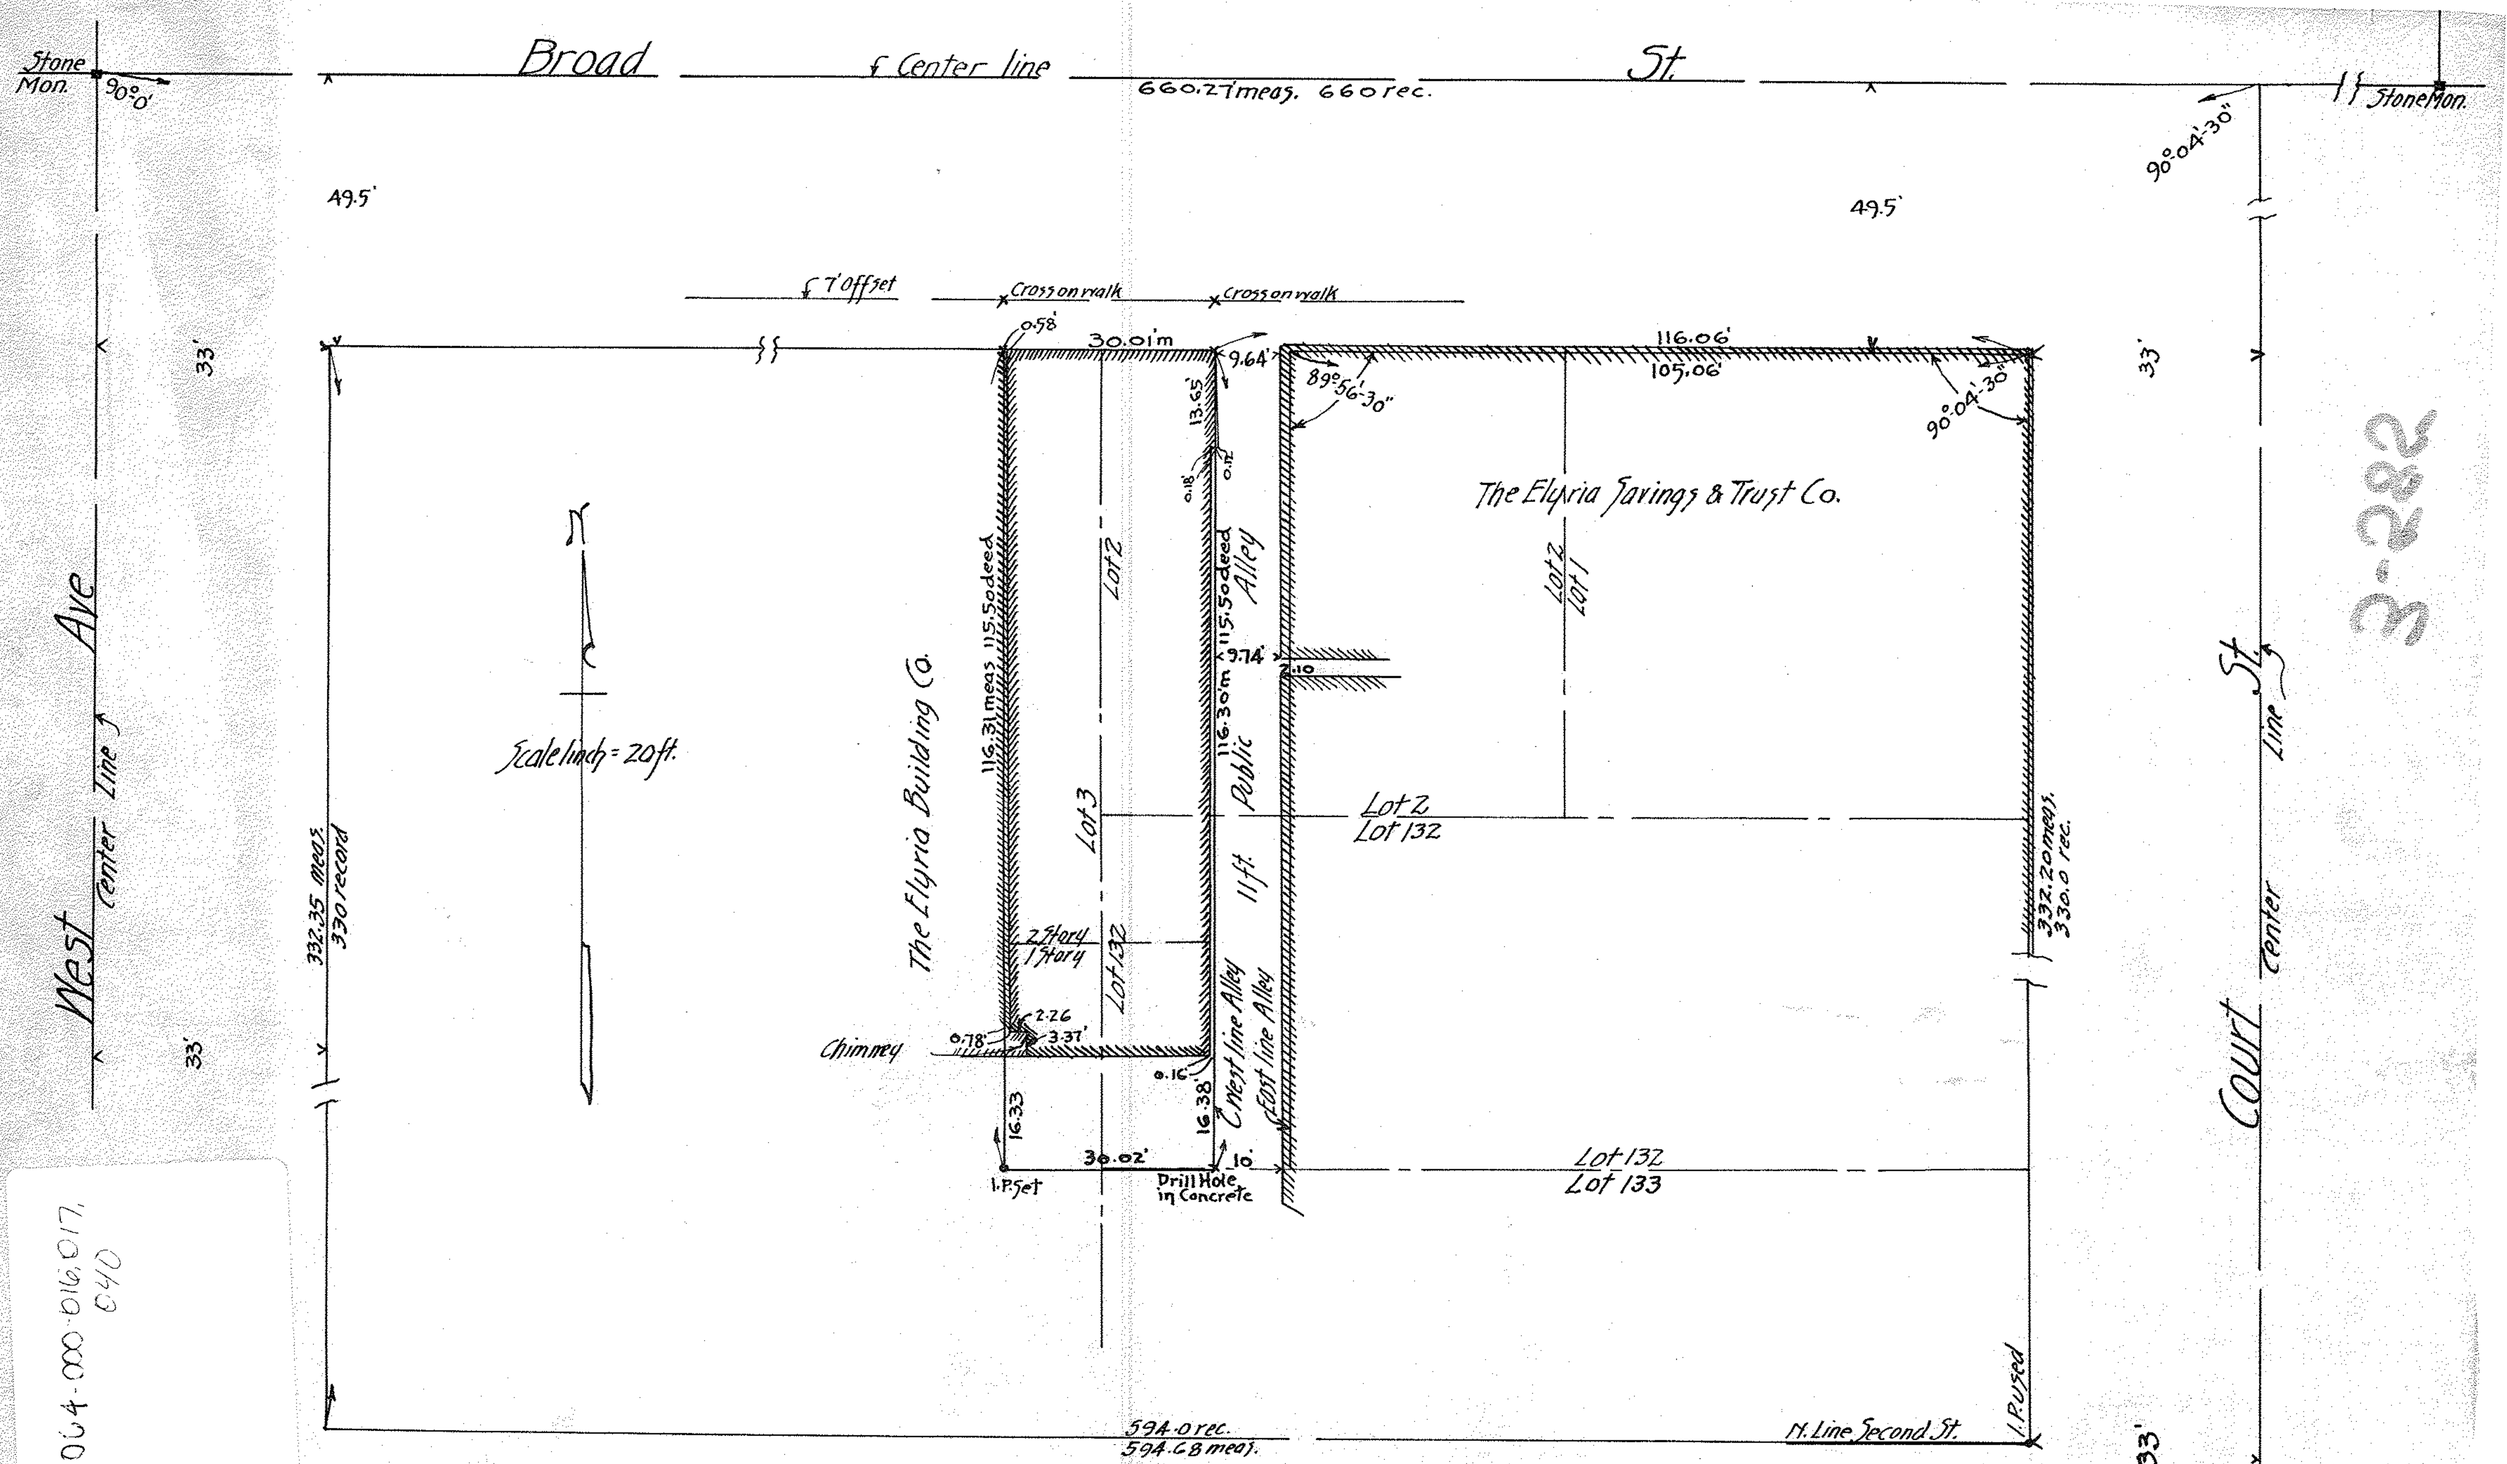

Survey for
The Logan Gas Co.,
Lots 2-3-132, Block 64,
Heman Ely's Original Village Plat of Elyria,
Lorain County Map Vol-3-Pg 14,
Elyria, Lorain Co., Ohio.
March 30, 1928. Warden and Laundon Civil Engineers.

300585

3-282

PPN 06-26-064-000-016,017,040

MAP PG 6-119