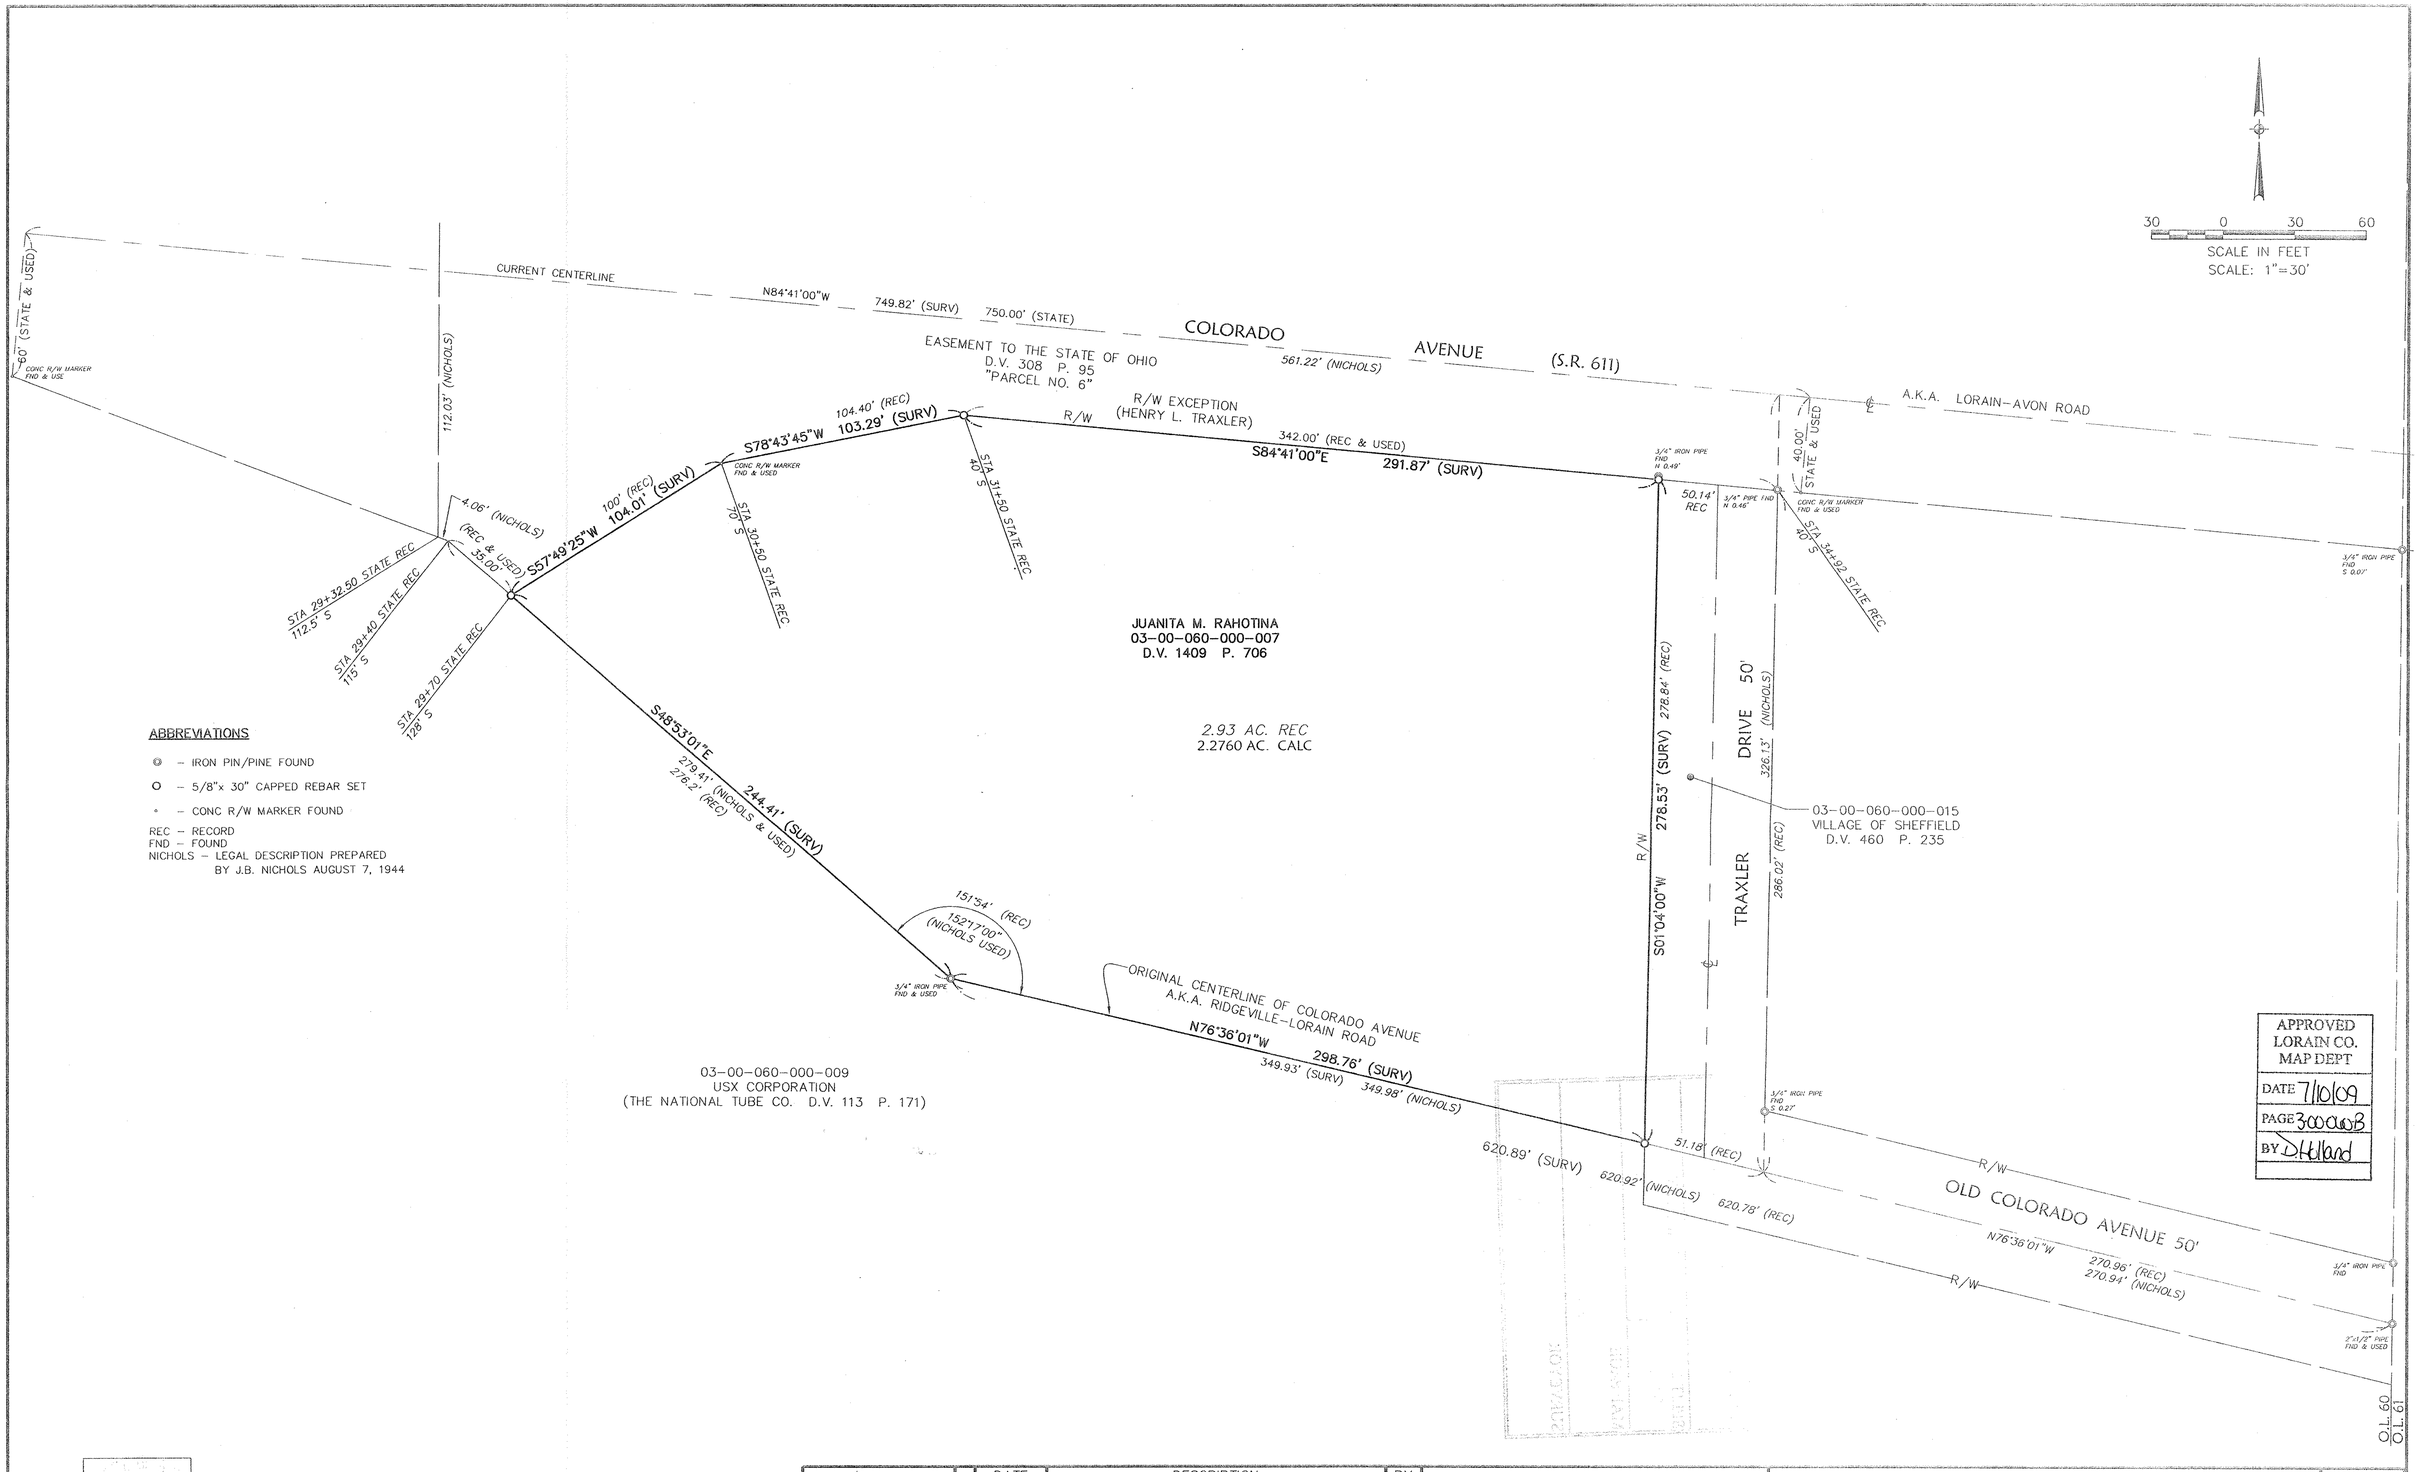

APPROVED
LORAIN CO.
MAP DEPT
DATE 7/10/09
PAGE 3000003
BY DHolland

ABBREVIATIONS

- ● – IRON PIN/PINE FOUND
- O – 5/8"x 30" CAPPED REBAR SET
- • – CONC R/W MARKER FOUND

REC – RECORD
FND – FOUND
NICHOLS – LEGAL DESCRIPTION PREPARED BY J.B. NICHOLS AUGUST 7, 1944

David L. Elwell 12-21-00
DAVID L. ELWELL, REGISTERED SURVEYOR NO. 6333 DATE

DATE: DECEMBER 6, 2000
DRAWN BY: VY
CH'D BY:
DWG. NAME: 0-SURV02.DWG
PATH: 00294\CONTROL
F.B.

REVISIONS	DATE	DESCRIPTION	BY

KS ASSOCIATES, INC.
260 Burns Road, Suite 100
P.O. Box 569
Elyria, Ohio 44036
Phone (440) 365-4730
Fax (440) 365-4790
mailroom@ksassoc.com
www.ksassoc.com

BOUNDARY SURVEY

PART OF ORIGINAL SHEFFIELD TOWNSHIP LOT NO. 60
VILLAGE OF SHEFFIELD * COUNTY OF LORAIN * STATE OF OHIO

SHEET 1 OF 1
JOB NO. 00294