12-00-051-000-007, 008

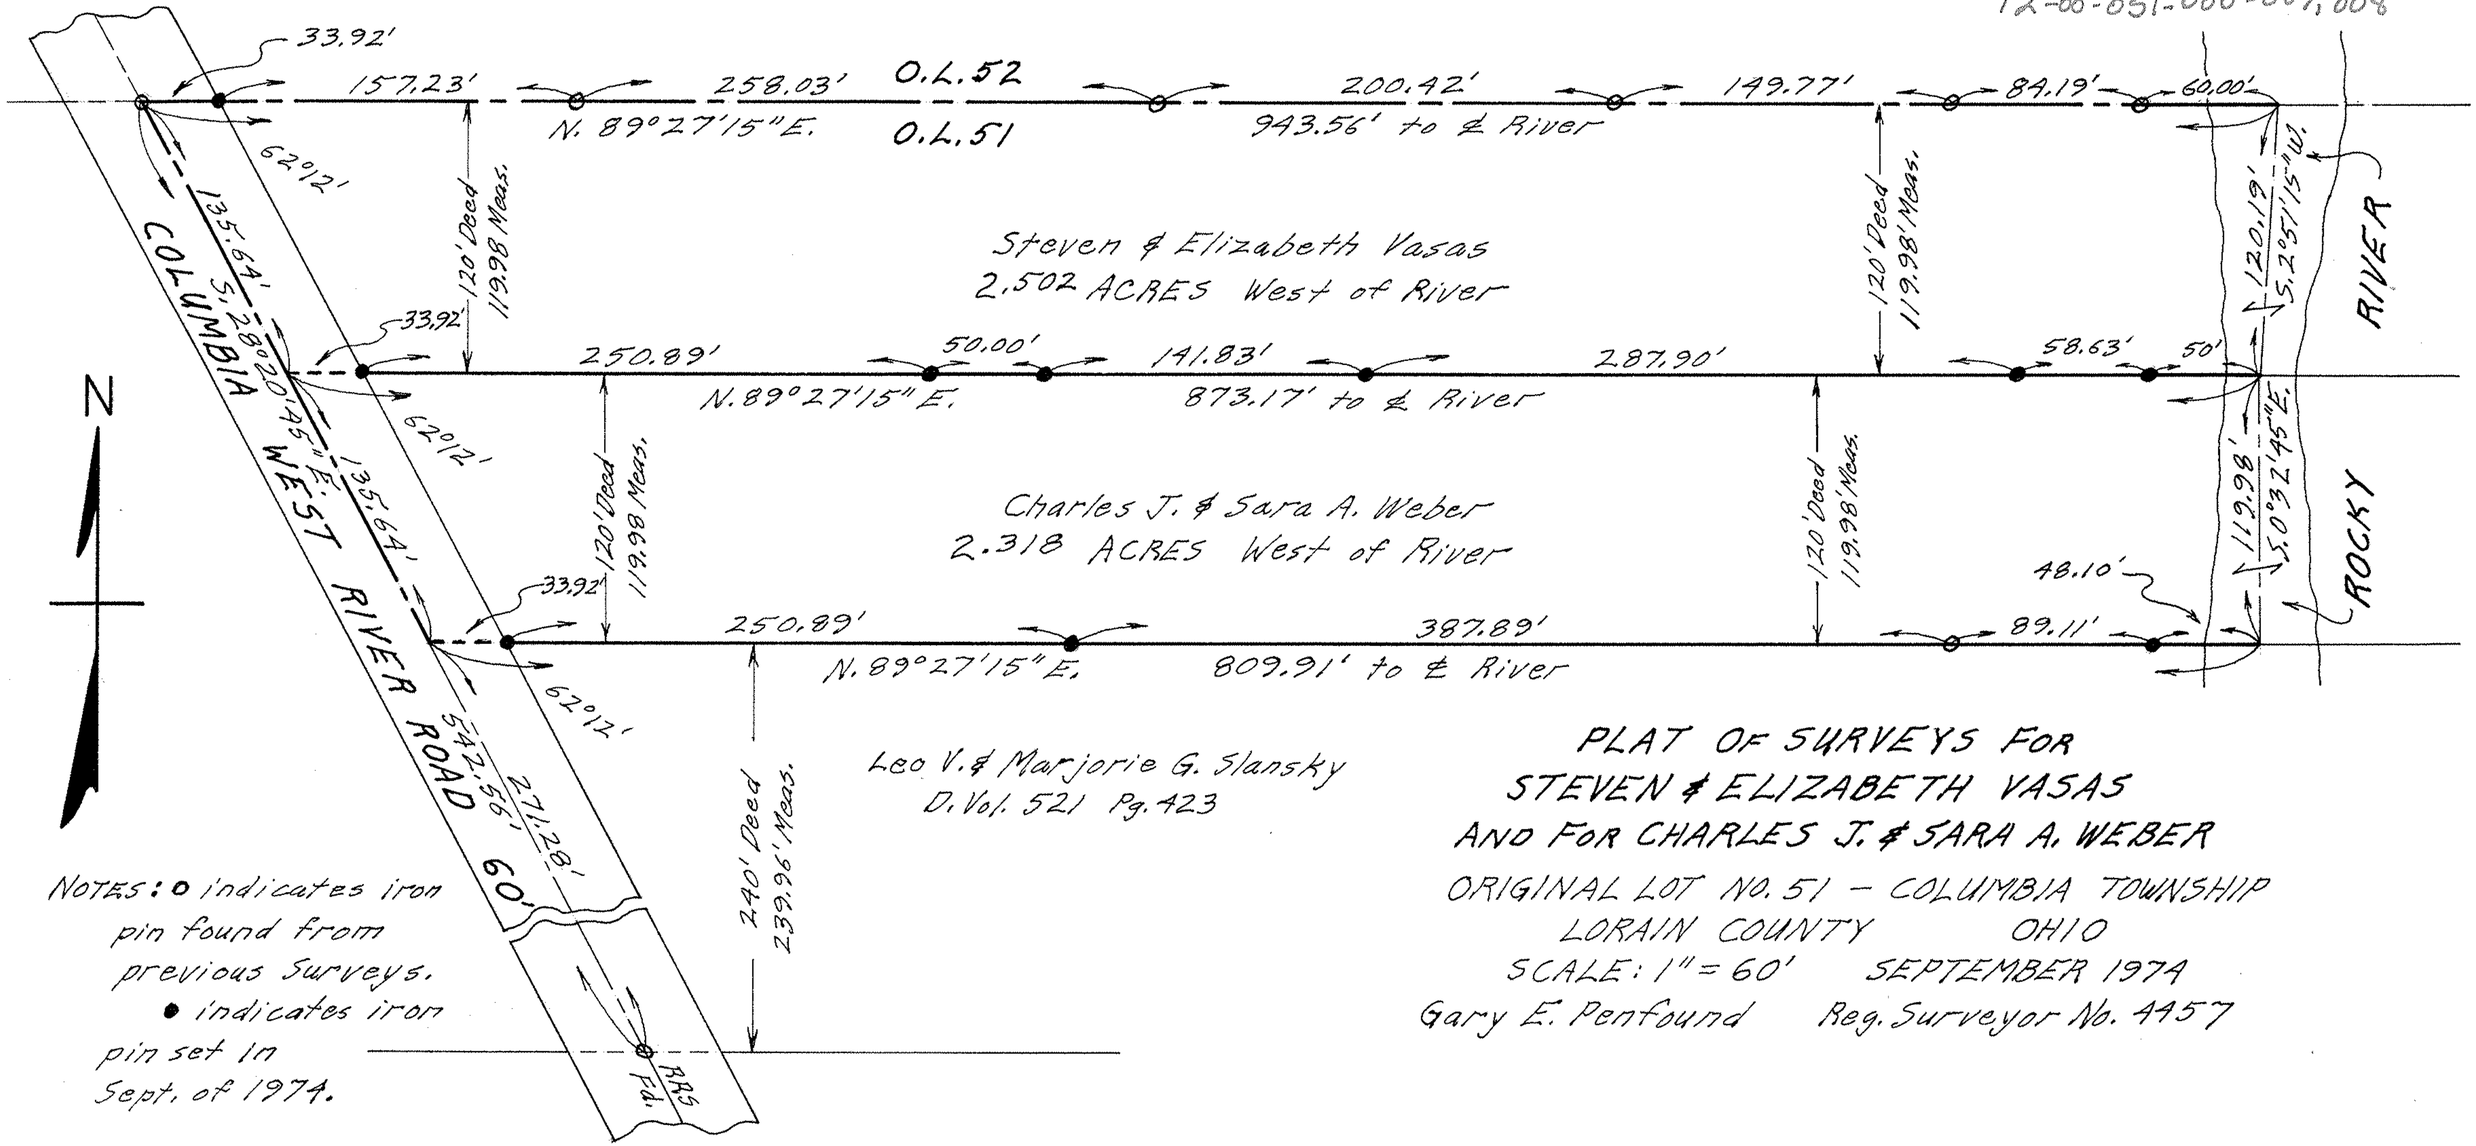

NOTES: ○ indicates iron pin found from previous surveys.
● indicates iron pin set in Sept. of 1974.

PLAT OF SURVEYS FOR STEVEN & ELIZABETH VASAS AND FOR CHARLES J. & SARA A. WEBER

ORIGINAL LOT NO. 51 – COLUMBIA TOWNSHIP
LORAIN COUNTY OHIO
SCALE: 1" = 60' SEPTEMBER 1974
Gary E. Penfound Reg. Surveyor No. 4457

12-00-051