(8) 10-00-011-101-???
10-A

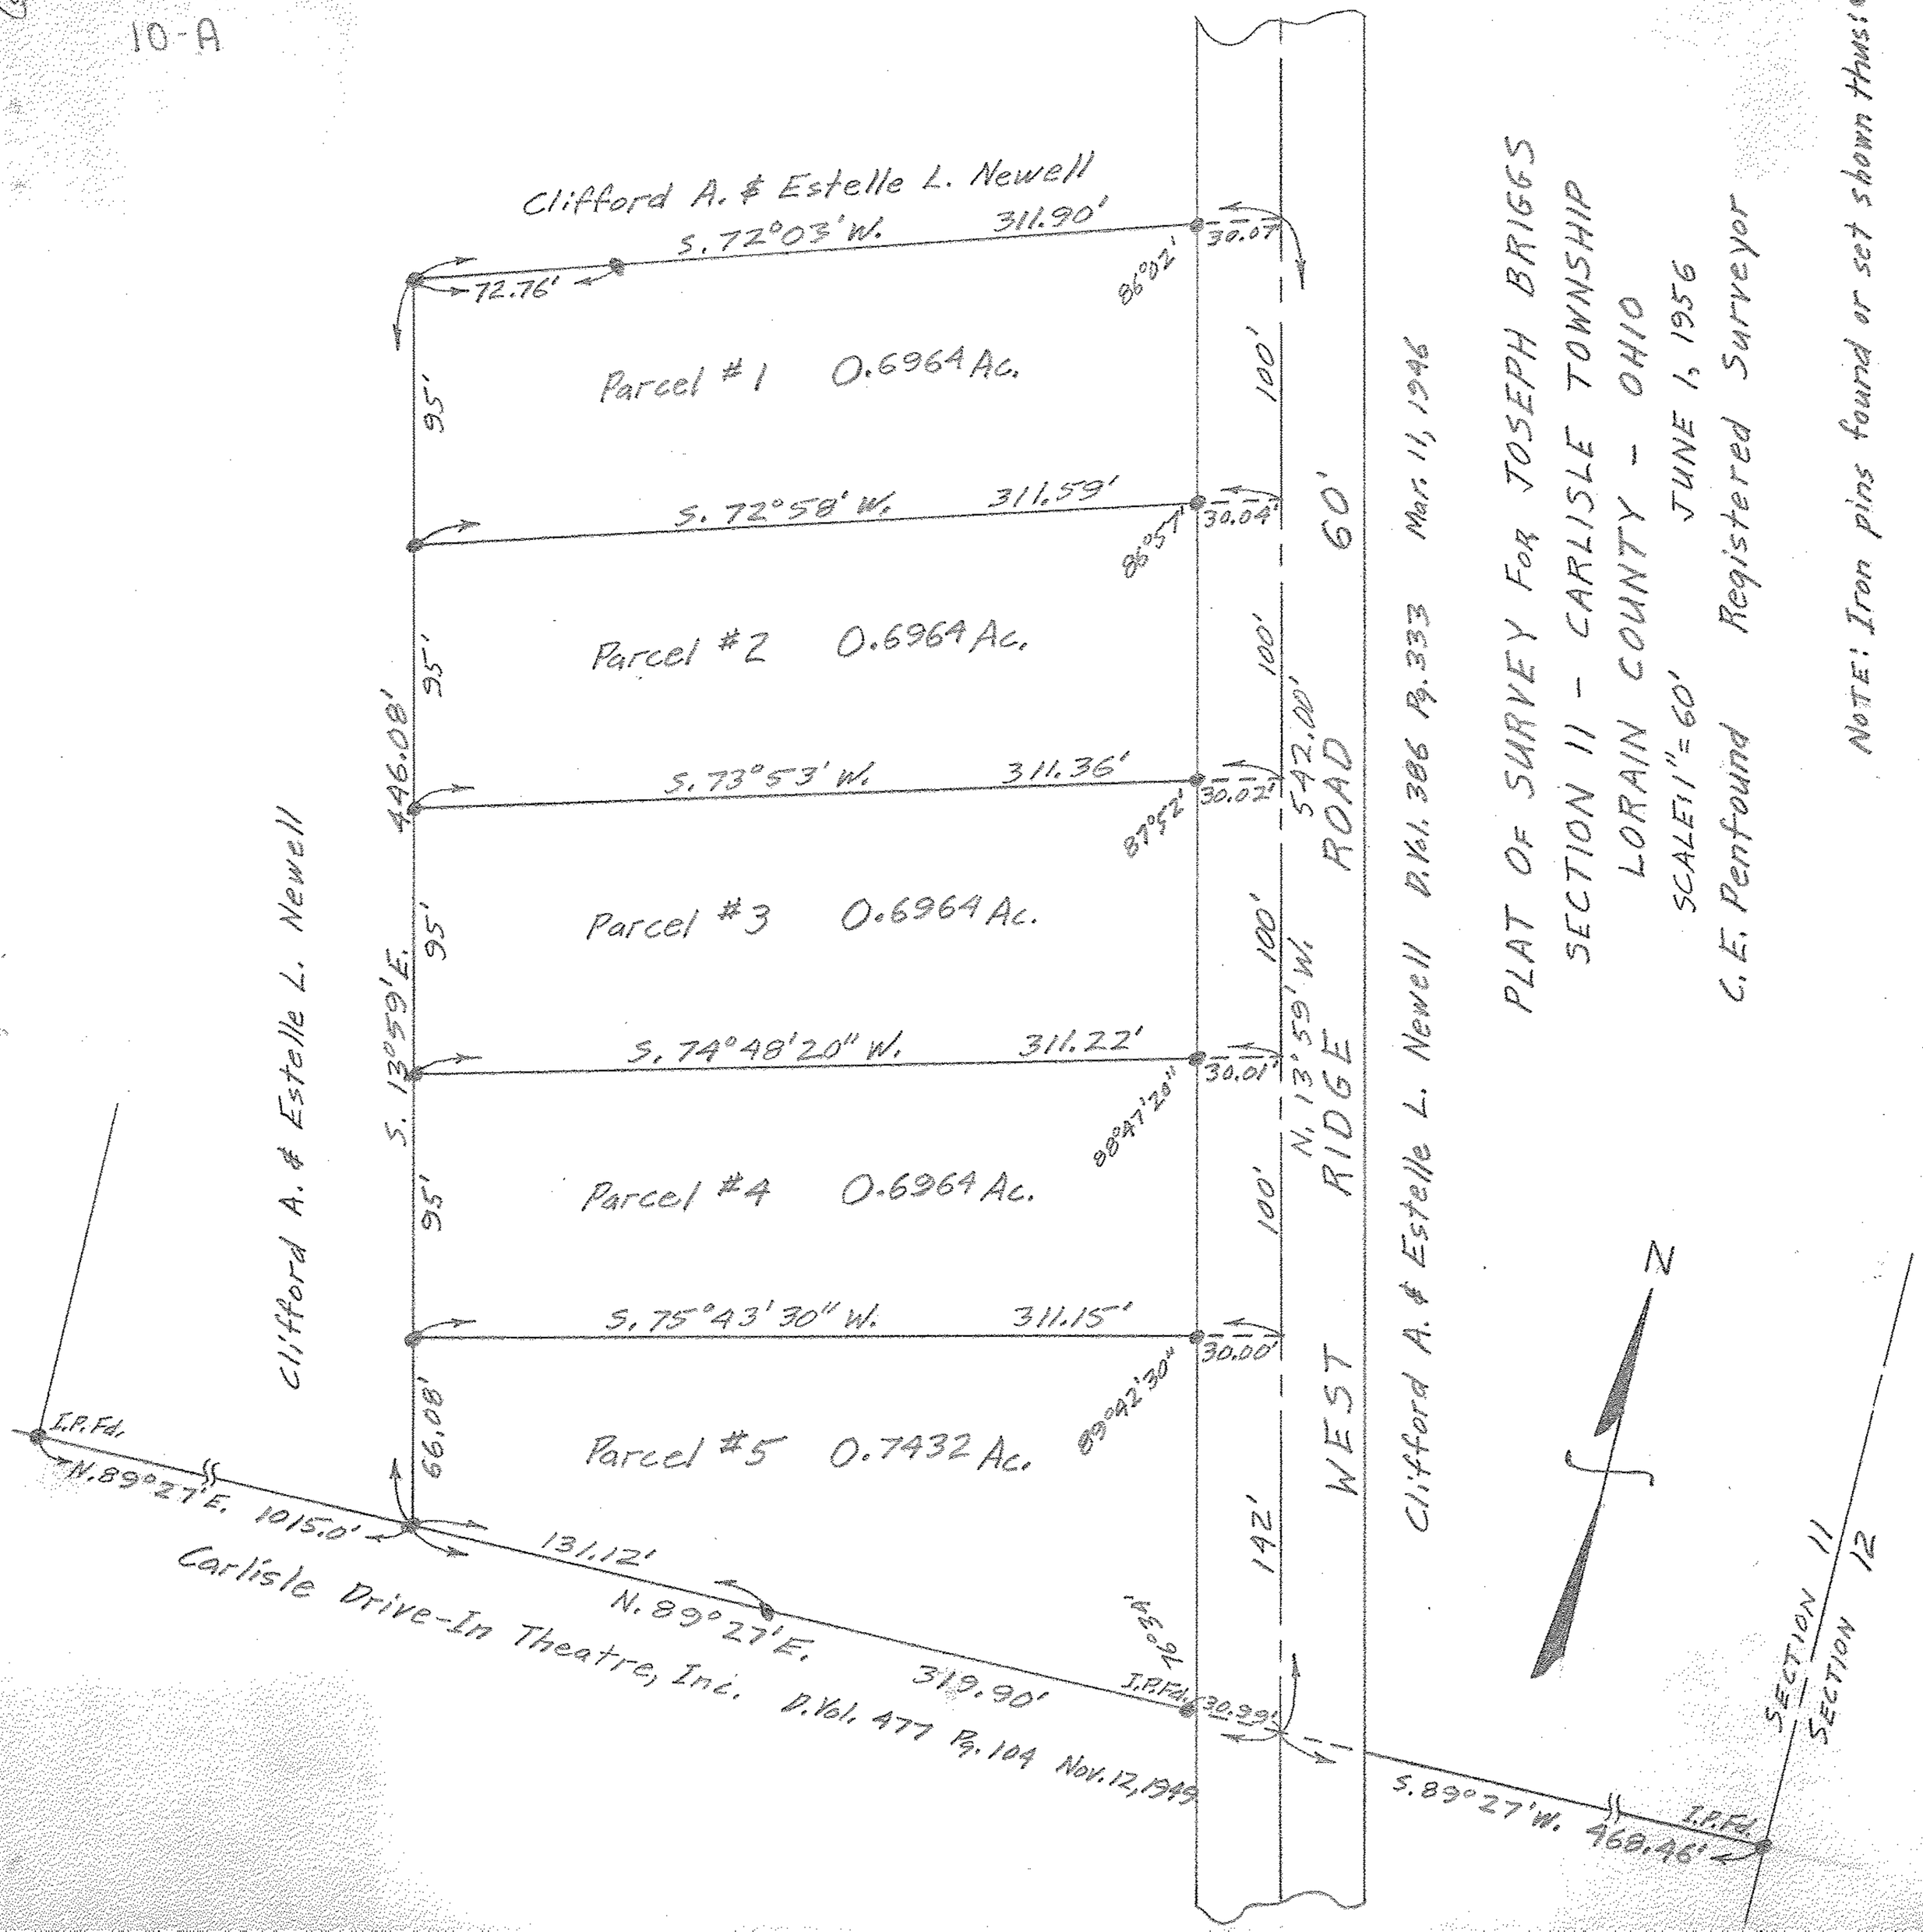

PLAT OF SURVEY FOR JOSEPH BRIGGS
SECTION 11 - CARLISLE TOWNSHIP
LORAIN COUNTY - OHIO
SCALE: 1" = 60' JUNE 1, 1956
C. E. Penfound Registered Surveyor

NOTE: Iron pins found or set shown thus: ●

10-00-011