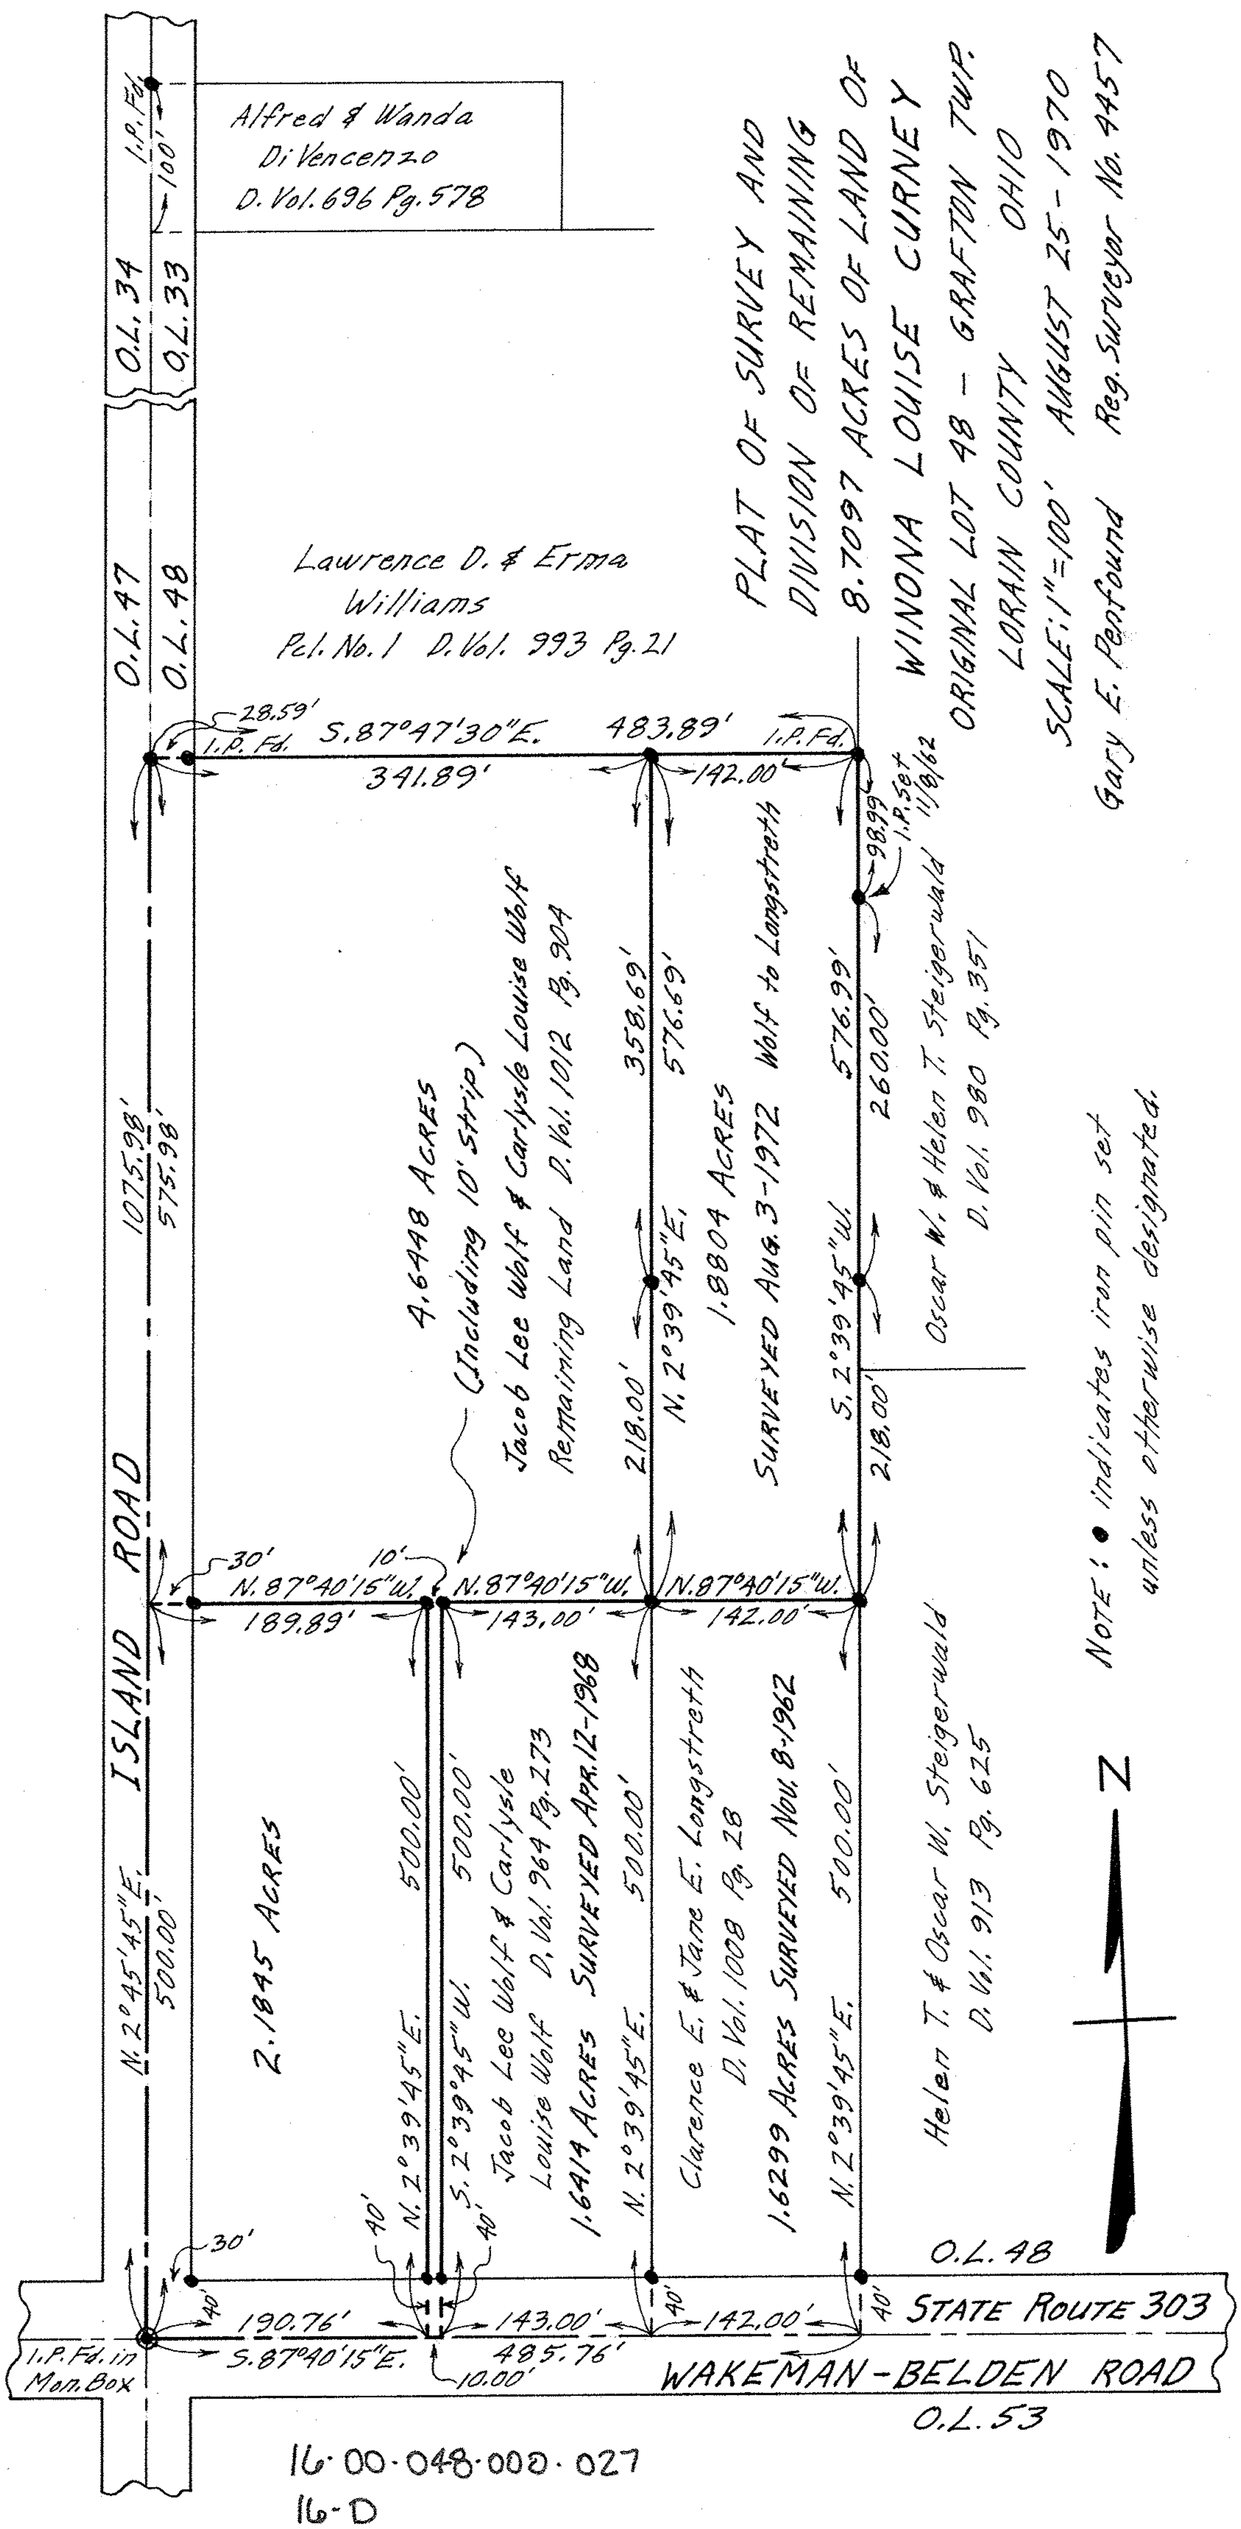
16-00-048
PLAT OF SURVEY AND DIVISION OF REMAINING 8.7097 ACRES OF LAND OF WINONA LOUISE CURNEY
ORIGINAL LOT 48 - GRAFTON TWP.
LORAIN COUNTY OHIO
SCALE: 1"=100' AUGUST 25-1970
Gary E. Penfound Reg. Surveyor No. 4457
Alfred & Wanda DiVencenzo D. Vol. 696 Pg. 578
Lawrence D. & Erma Williams Pcl. No. 1 D. Vol. 993 Pg. 21
O.L. 34
O.L. 33
O.L. 47
O.L. 48
O.L. 53
ISLAND ROAD
WAKEMAN-BELDEN ROAD
STATE ROUTE 303
I.P. Fd.
I.P. Fd. in Mon. Box
I.P. Set 11/8/62
28.59'
S. 87°47'30"E.
341.89'
483.89'
142.00'
98.99'
1075.98'
575.98'
358.69'
576.69'
576.99'
260.00'
4.6448 ACRES (Including 10' strip.)
Jacob Lee Wolf & Carlysle Louise Wolf Remaining Land D. Vol. 1012 Pg. 904
1.8804 ACRES SURVEYED AUG. 3-1972
Wolf to Longstreth
Oscar W. & Helen T. Steigerwald D. Vol. 980 Pg. 351
218.00'
N. 2°39'45"E.
S. 2°39'45"W.
30'
10'
N. 87°40'15"W.
189.89'
143.00'
142.00'
2.1845 ACRES
500.00'
N. 2°45'45"E.
1.6414 ACRES SURVEYED APR. 12-1968
Jacob Lee Wolf & Carlysle Louise Wolf D. Vol. 964 Pg. 273
1.6299 ACRES SURVEYED NOV. 8-1962
Clarence E. & Jane E. Longstreth D. Vol. 1008 Pg. 28
Helen T. & Oscar W. Steigerwald D. Vol. 913 Pg. 625
40'
190.76'
485.76'
10.00'
S. 87°40'15"E.
NOTE: ● indicates iron pin set unless otherwise designated.
N
16-00-048-000-027
16-D