02-03-001-B
02-03-001-102-012
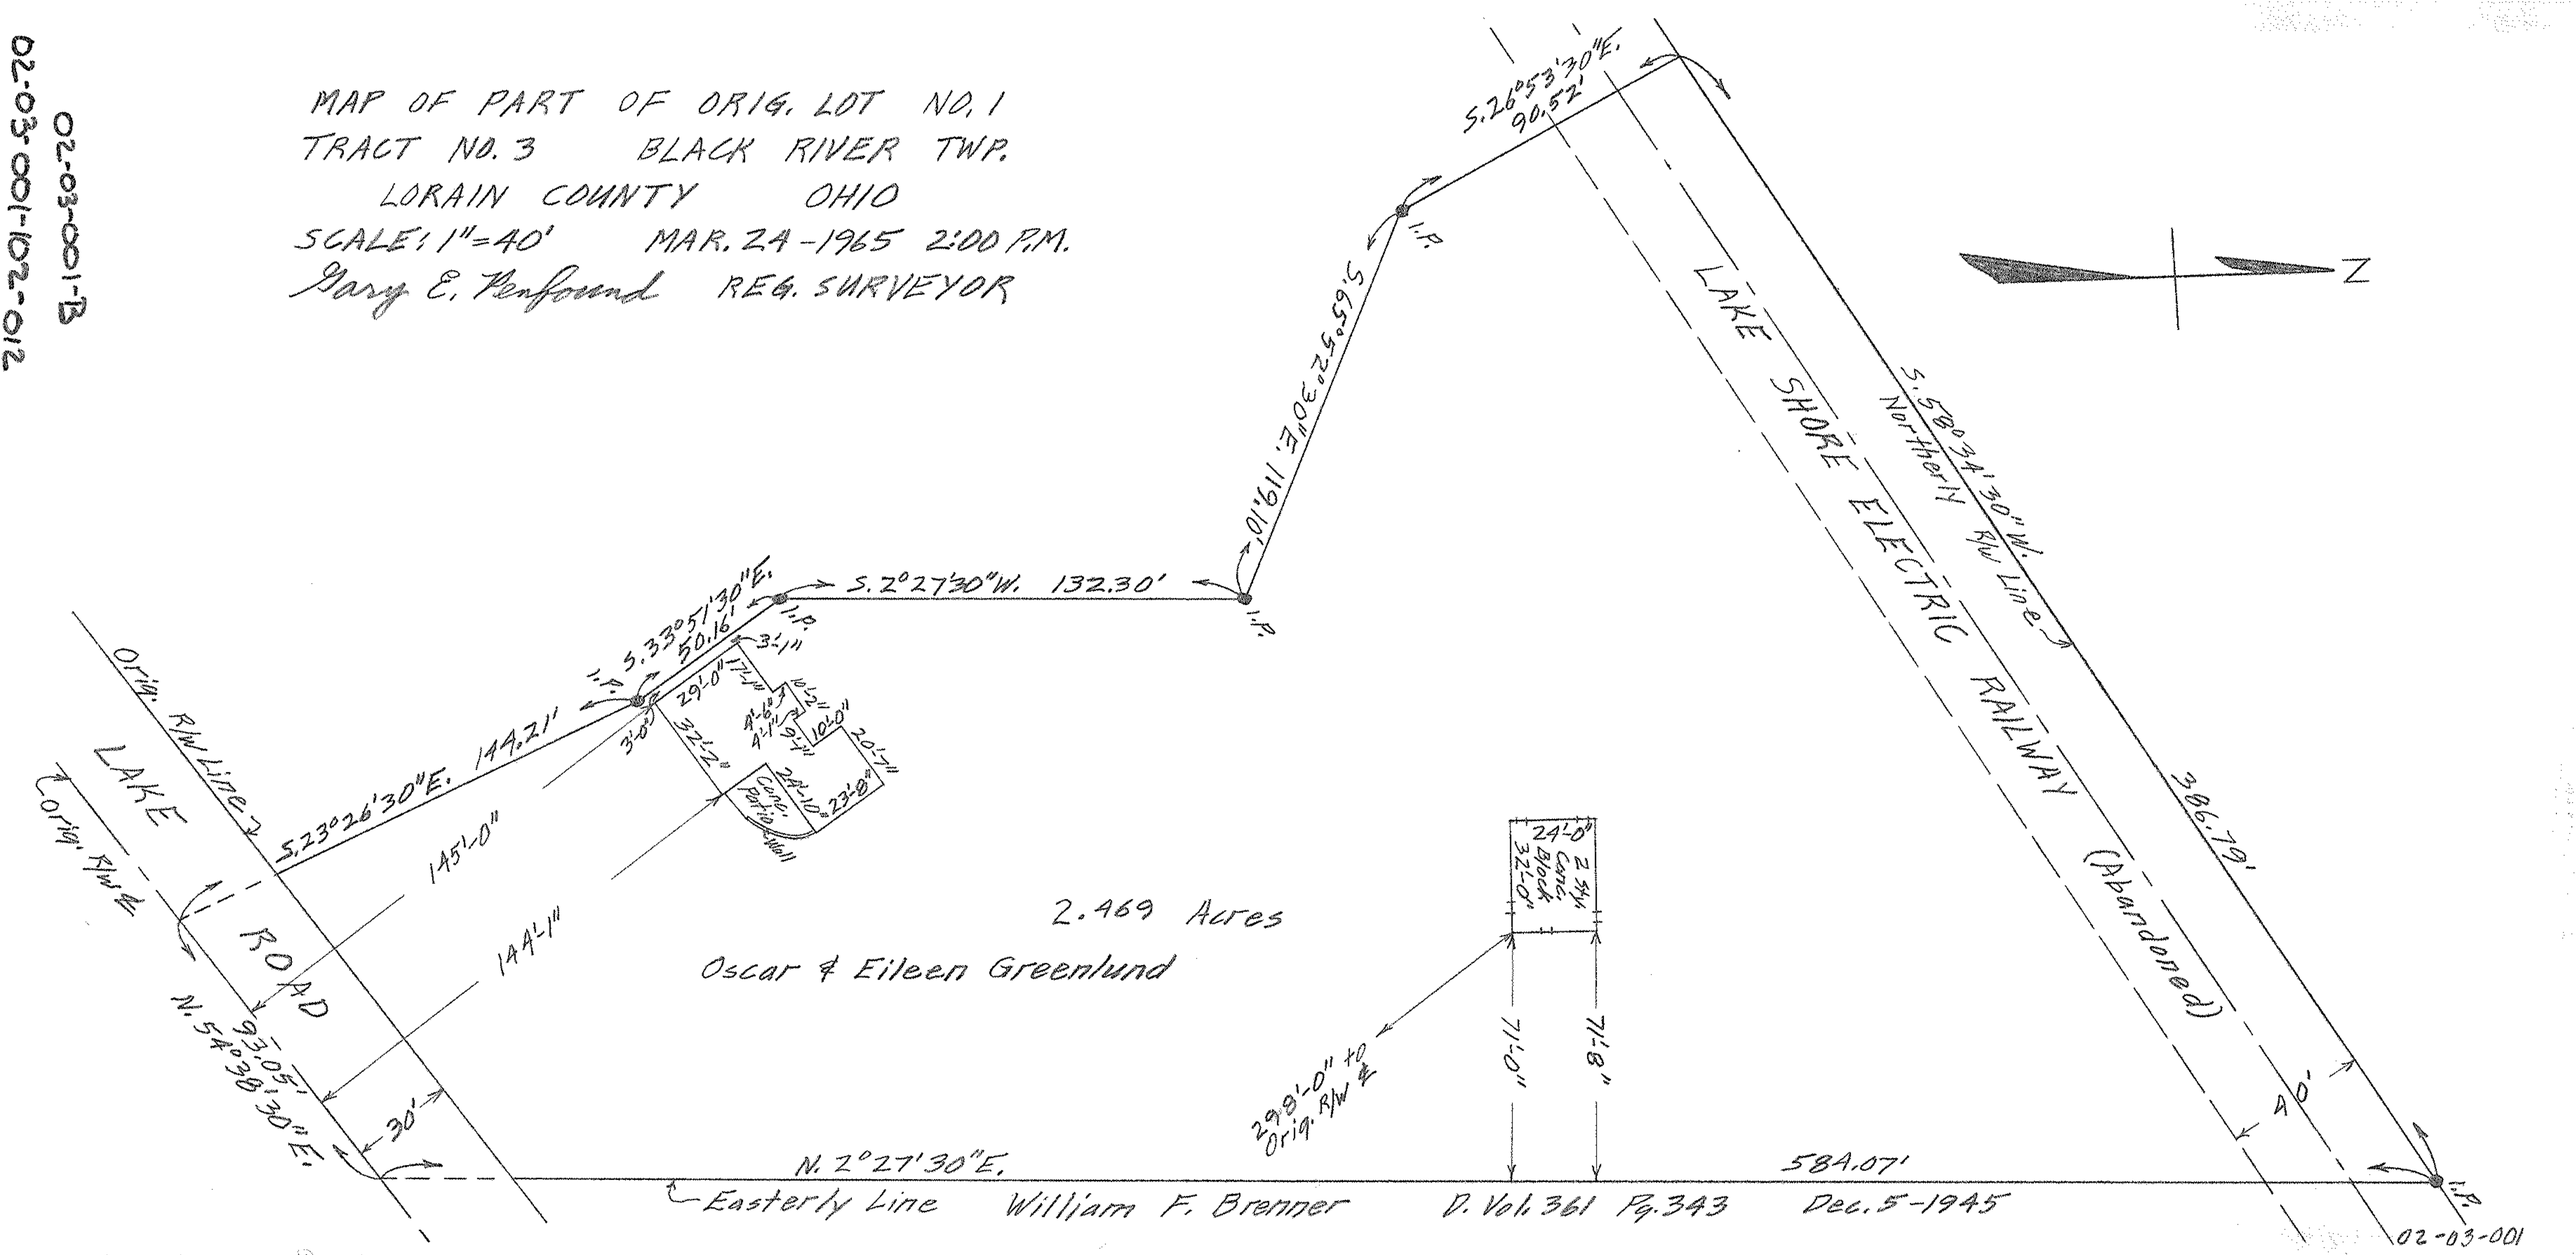
MAP OF PART OF ORIG. LOT NO. 1
TRACT NO. 3 BLACK RIVER TWP.
LORAIN COUNTY OHIO
SCALE: 1"=40' MAR. 24-1965 2:00 P.M.
Gary E. Penfound REG. SURVEYOR