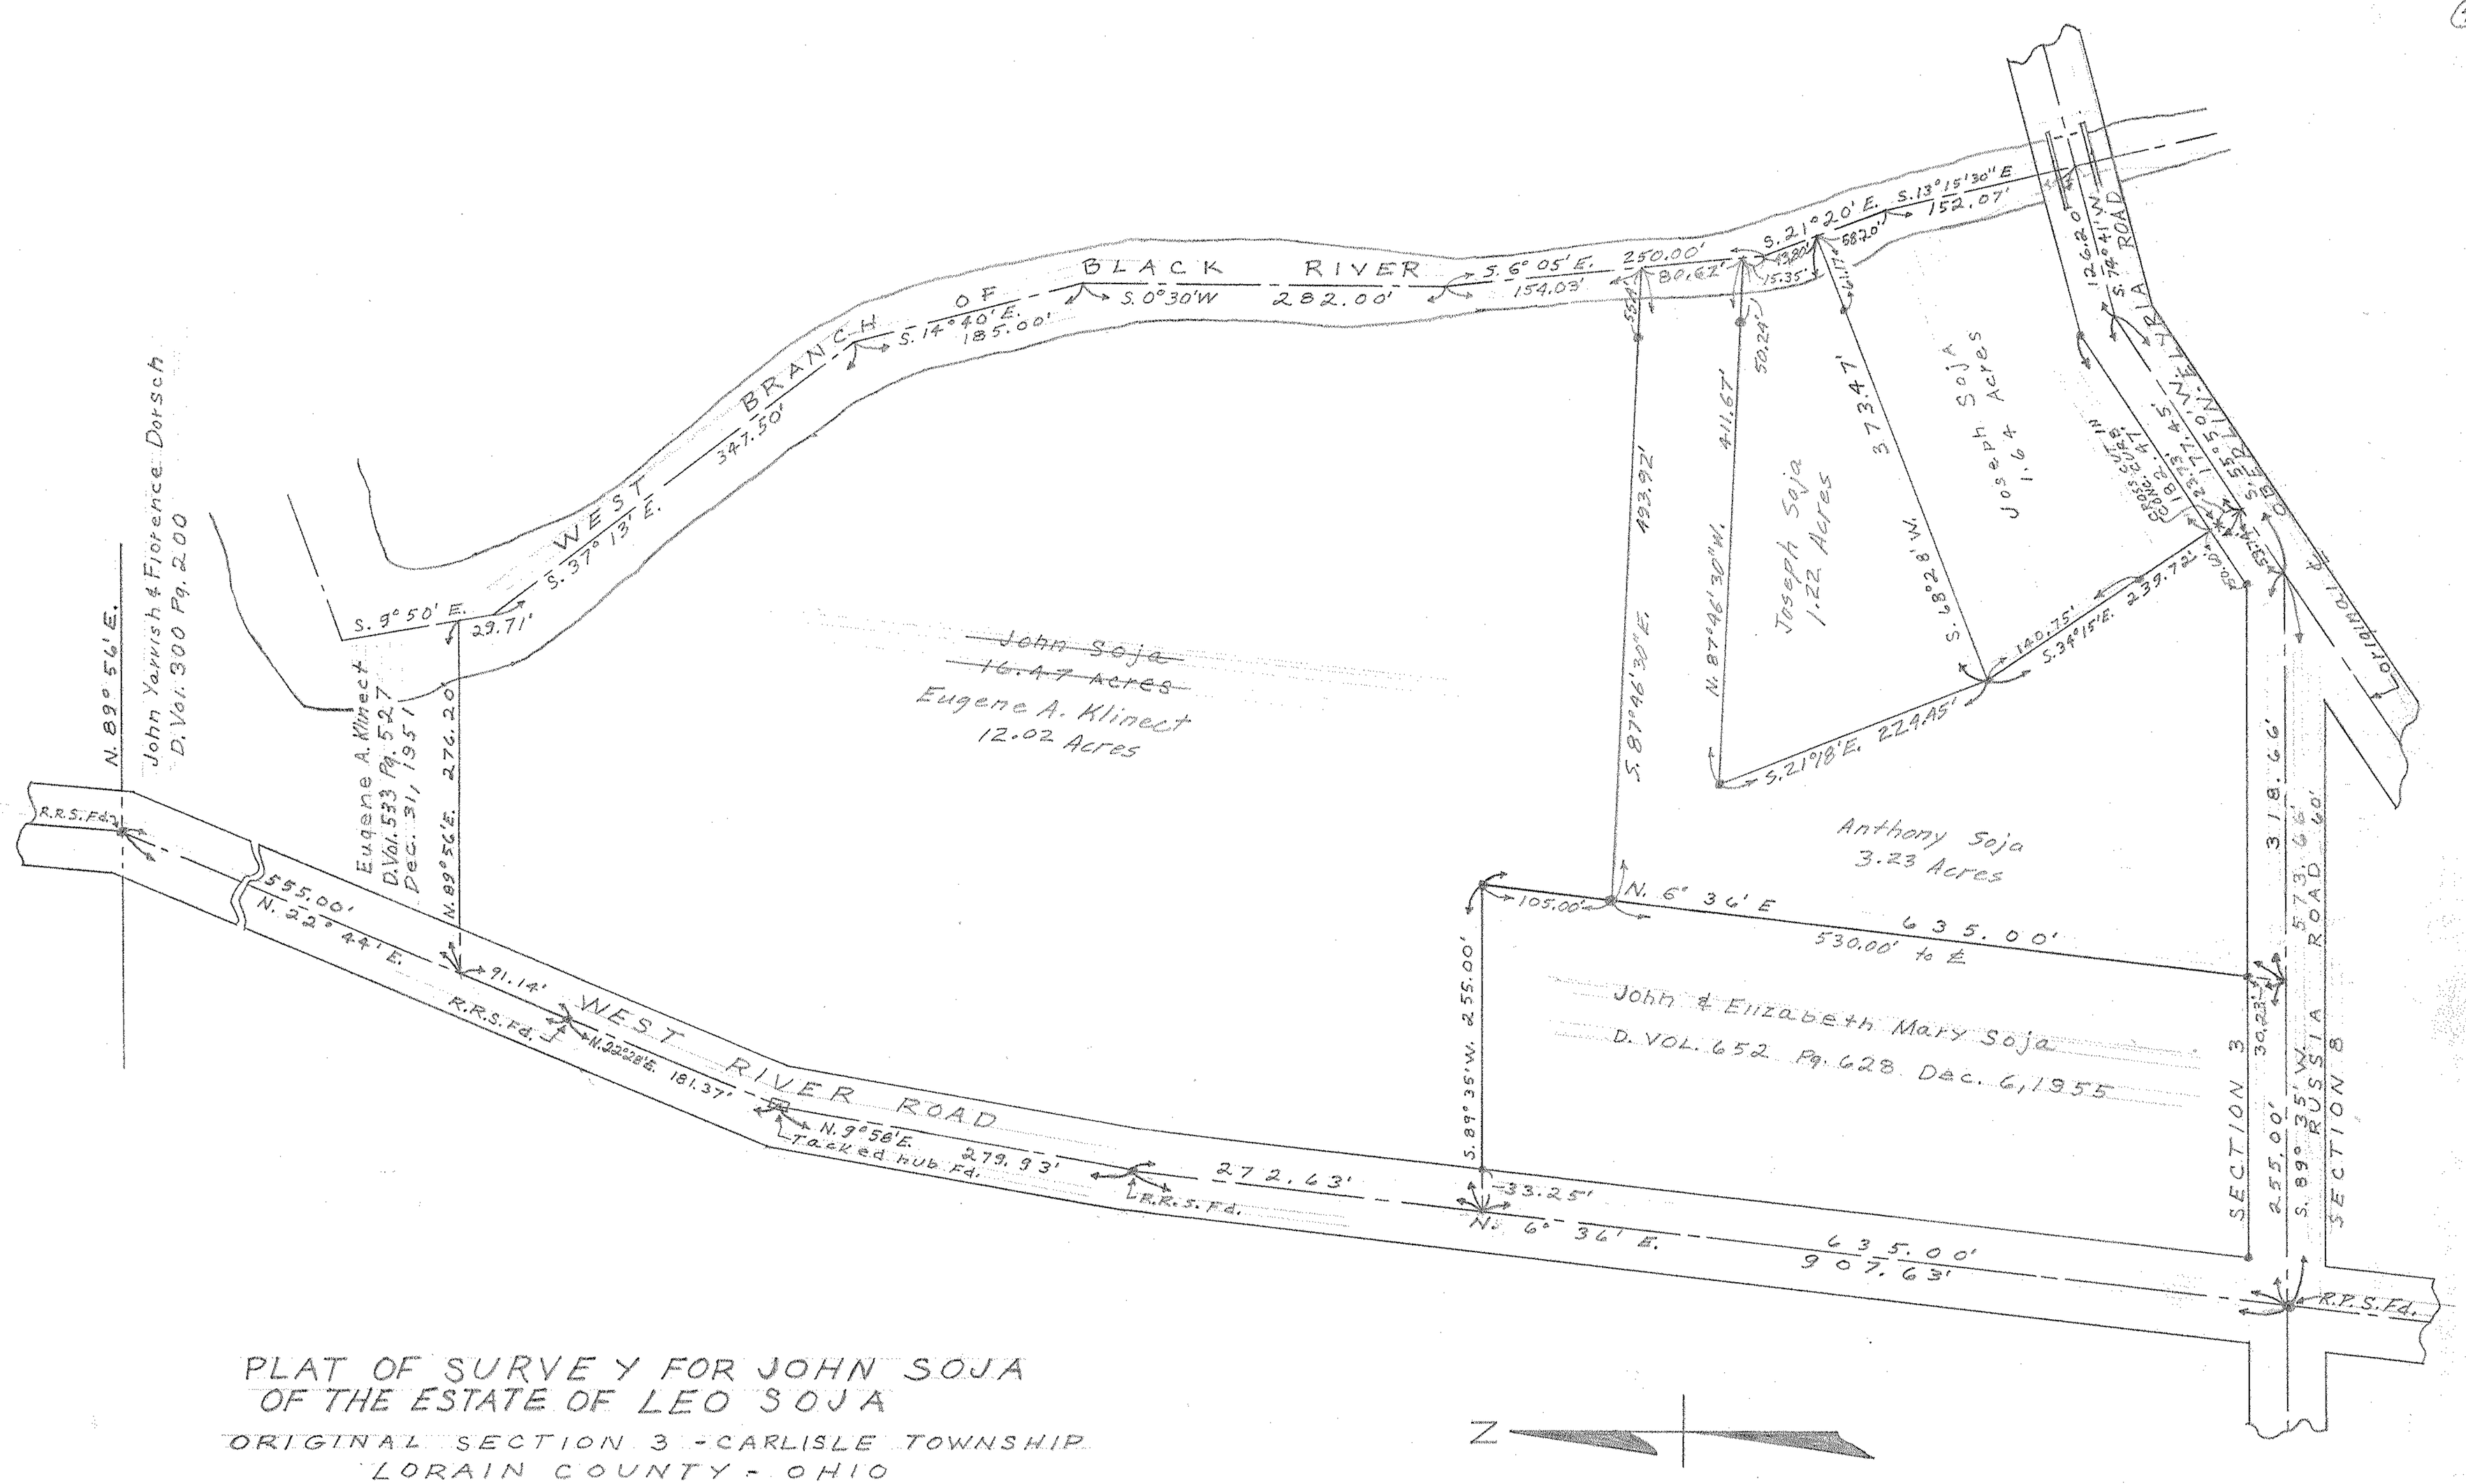

PLAT OF SURVEY FOR JOHN SOJA OF THE ESTATE OF LEO SOJA

ORIGINAL SECTION 3 - CARLISLE TOWNSHIP
LORAIN COUNTY - OHIO

SCALE 1" = 100' JULY, 1957

C.E. Penfound Registered Surveyor

NOTE: Iron pins found or set shown thus: ●

10-00-003-F

10-00-003-122 - ???