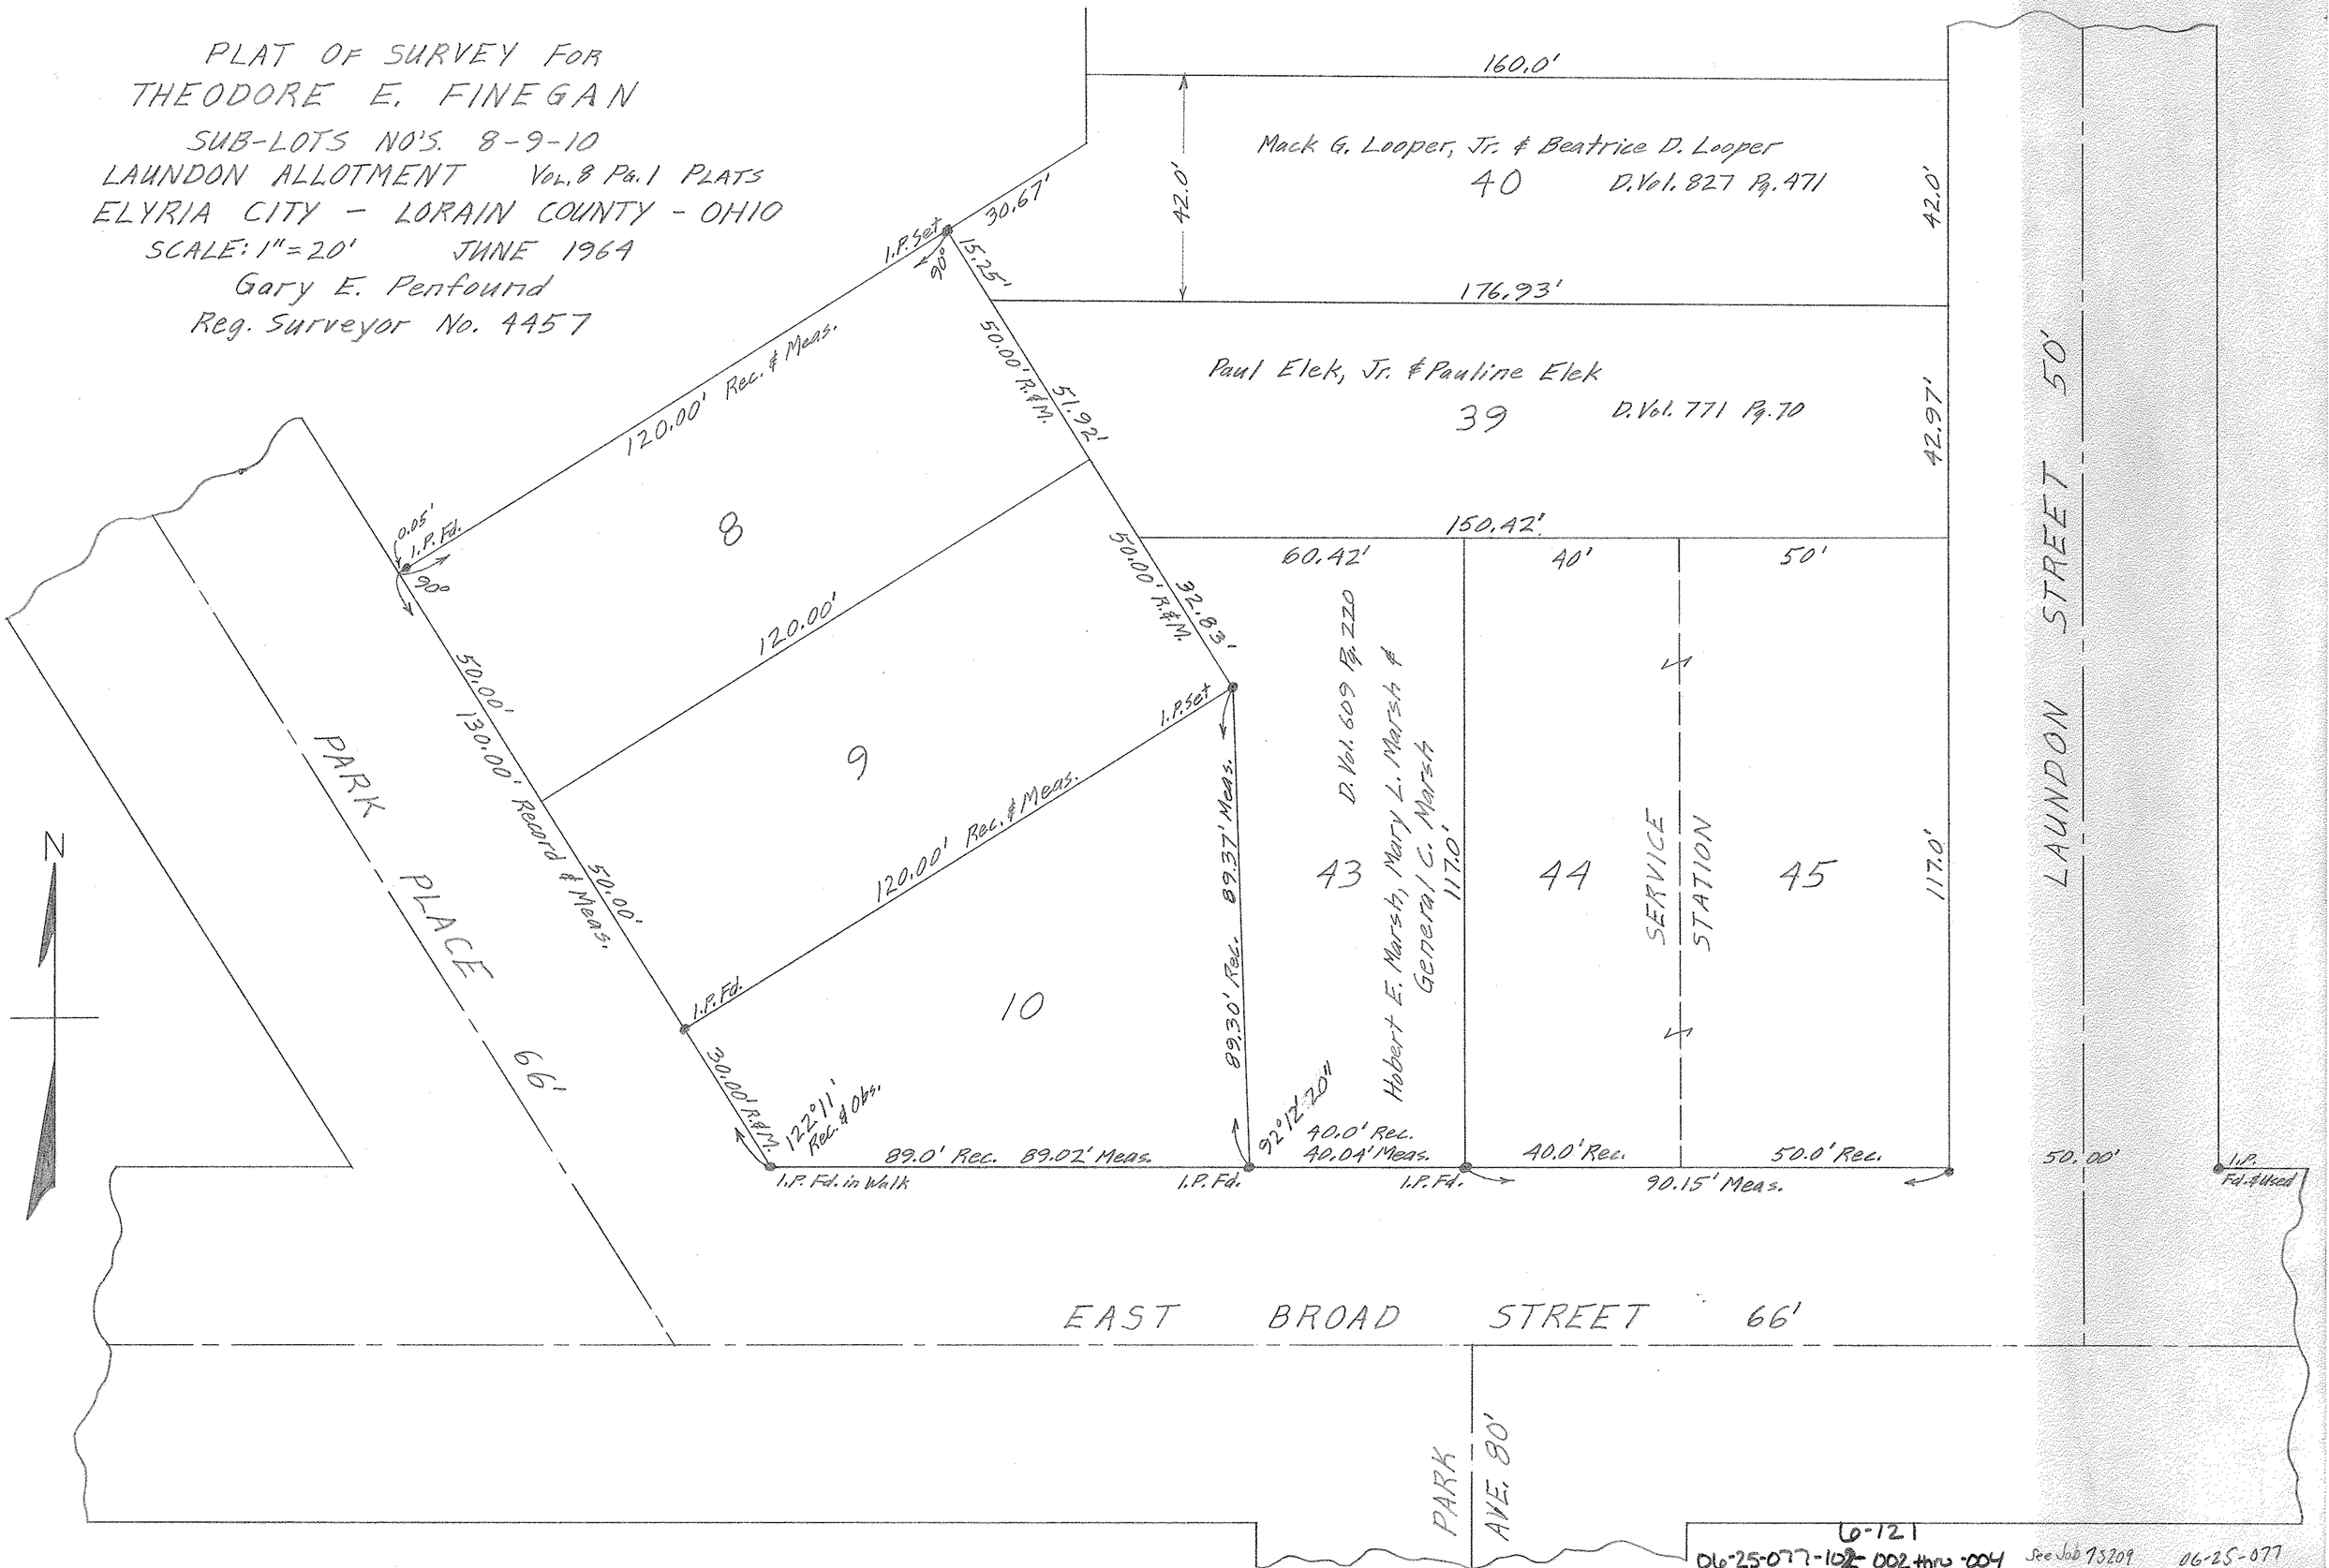
PLAT OF SURVEY FOR
THEODORE E. FINEGAN
SUB-LOTS NO'S. 8-9-10
LAUNDON ALLOTMENT VOL. 8 PG. 1 PLATS
ELYRIA CITY - LORAIN COUNTY - OHIO
SCALE: 1" = 20' JUNE 1964
Gary E. Penfound
Reg. Surveyor No. 4457
160.0'
Mack G. Looper, Jr. & Beatrice D. Looper
40
D. Vol. 827 Pg. 471
42.0'
176.93'
Paul Elek, Jr. & Pauline Elek
39
D. Vol. 771 Pg. 70
42.97'
150.42'
60.42'
40'
50'
30.67'
I.P. Set
90°
15.25'
120.00' Rec. & Meas.
50.00' R.&M.
51.92'
8
0.05'
I.P. Fd.
90°
120.00'
50.00' R.&M.
32.83'
9
I.P. Set
120.00' Rec. & Meas.
50.00'
130.00' Record & Meas.
PARK PLACE 66'
N
I.P. Fd.
10
30.00' R.&M.
122°11' Rec. & Obs.
89.0' Rec. 89.02' Meas.
I.P. Fd. in Walk
I.P. Fd.
89.30' Rec. 89.37' Meas.
92°12'20"
40.0' Rec.
40.04' Meas.
I.P. Fd.
D. Vol. 609 Pg. 220
Hobert E. Marsh, Mary L. Marsh & General C. Marsh
117.0'
43
44
45
SERVICE STATION
40.0' Rec.
50.0' Rec.
90.15' Meas.
117.0'
LAUNDON STREET 50'
50.00'
I.P. Fd. & Used
EAST BROAD STREET 66'
PARK AVE. 80'
6-121
06-25-077-102-002 thru -004
See Job 75209
06-25-077