PLAT OF SURVEY FOR
GEORGE & MARGARET GROSIK

ORIGINAL LOT NO. 13 – RIDGEVILLE TOWNSHIP
NORTH RIDGEVILLE CITY – LORAIN COUNTY – OHIO
SCALE: 1" = 100' JUNE 1975
Gary E. Penfound Reg. Surveyor No. 4457

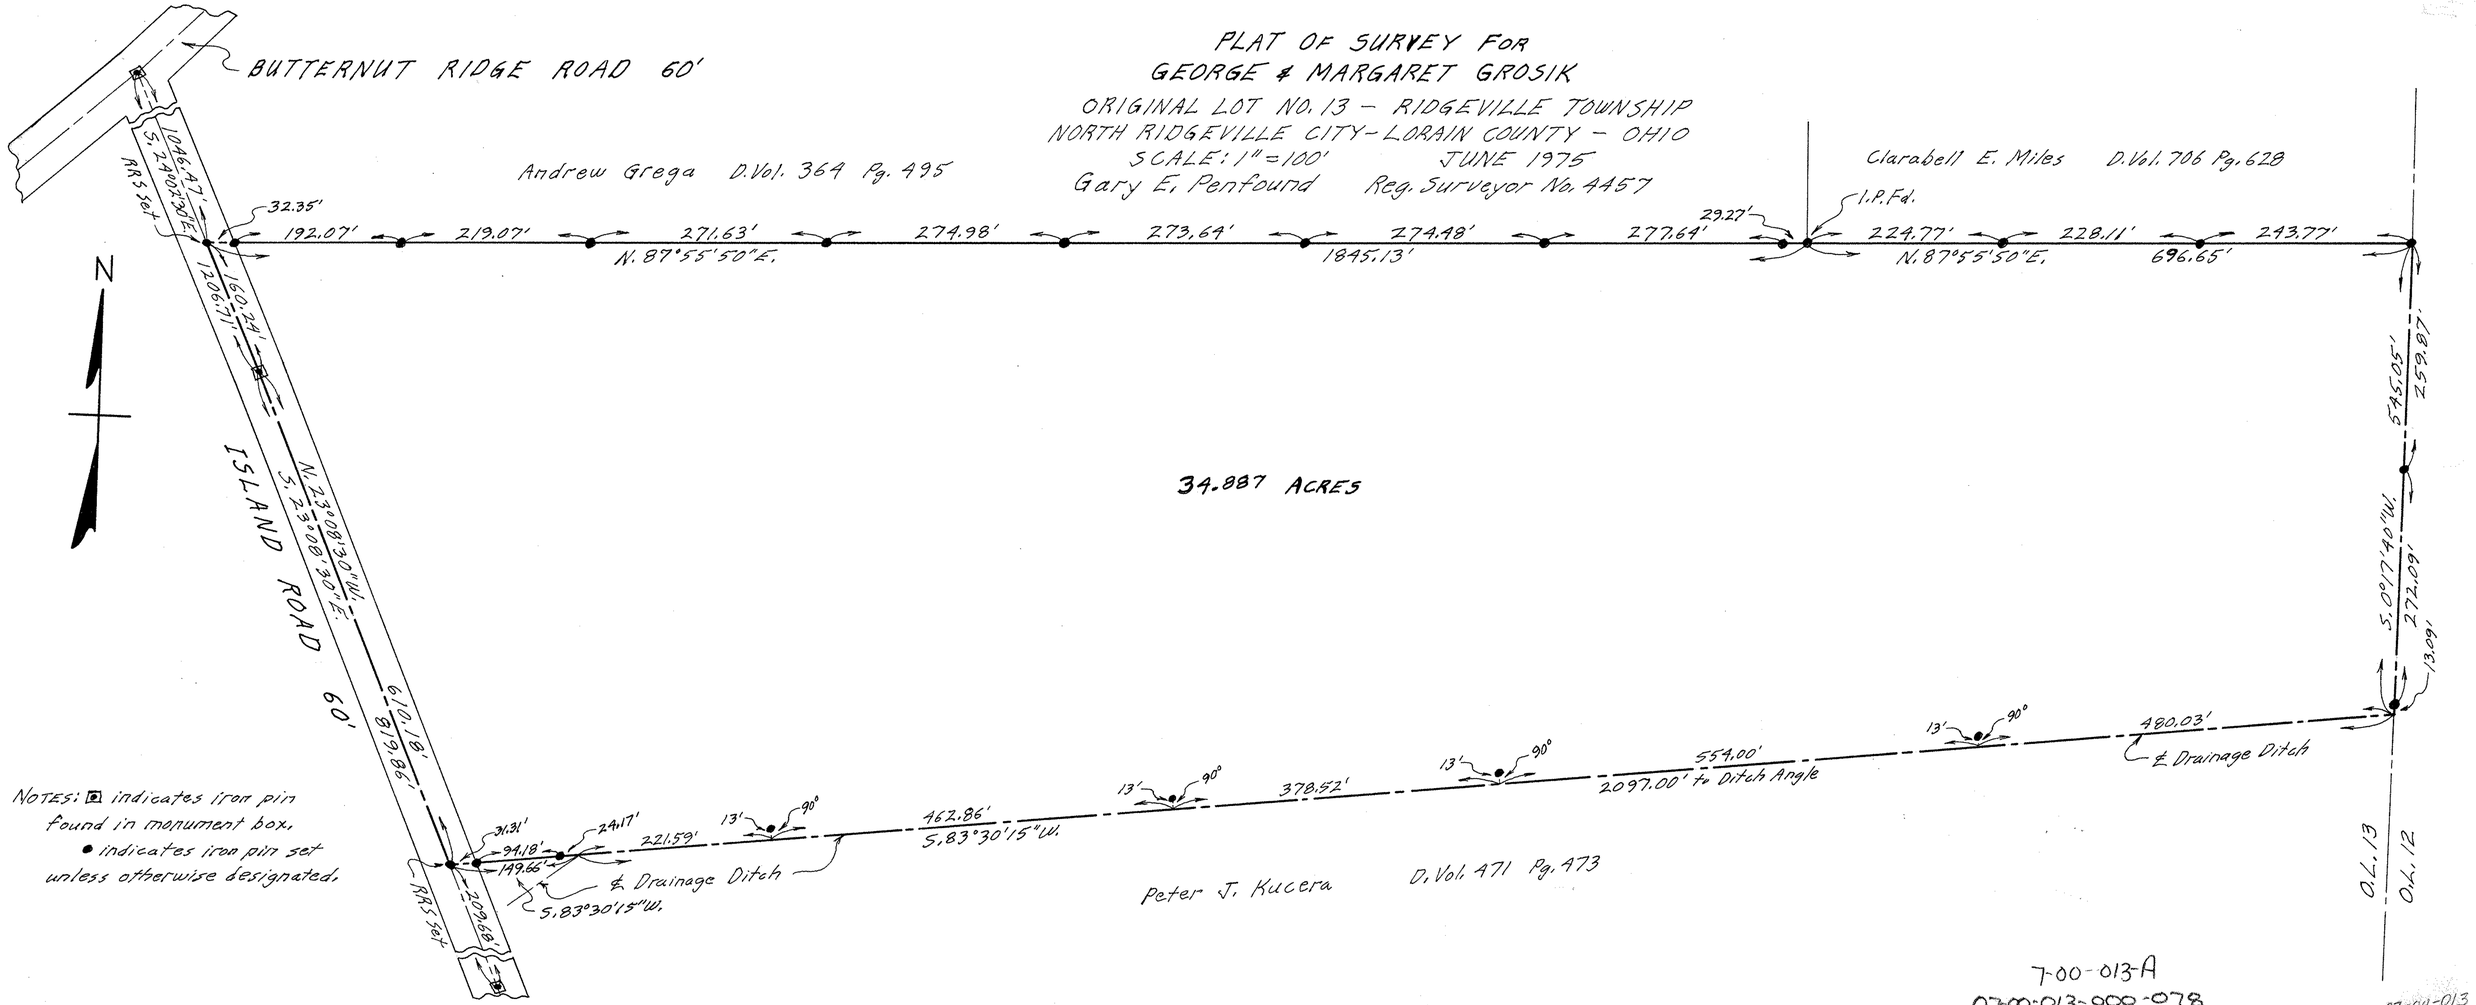

NOTES: ▣ indicates iron pin found in monument box.
● indicates iron pin set unless otherwise designated.

7-00-013-A
07-00-013-000-078

07-00-013