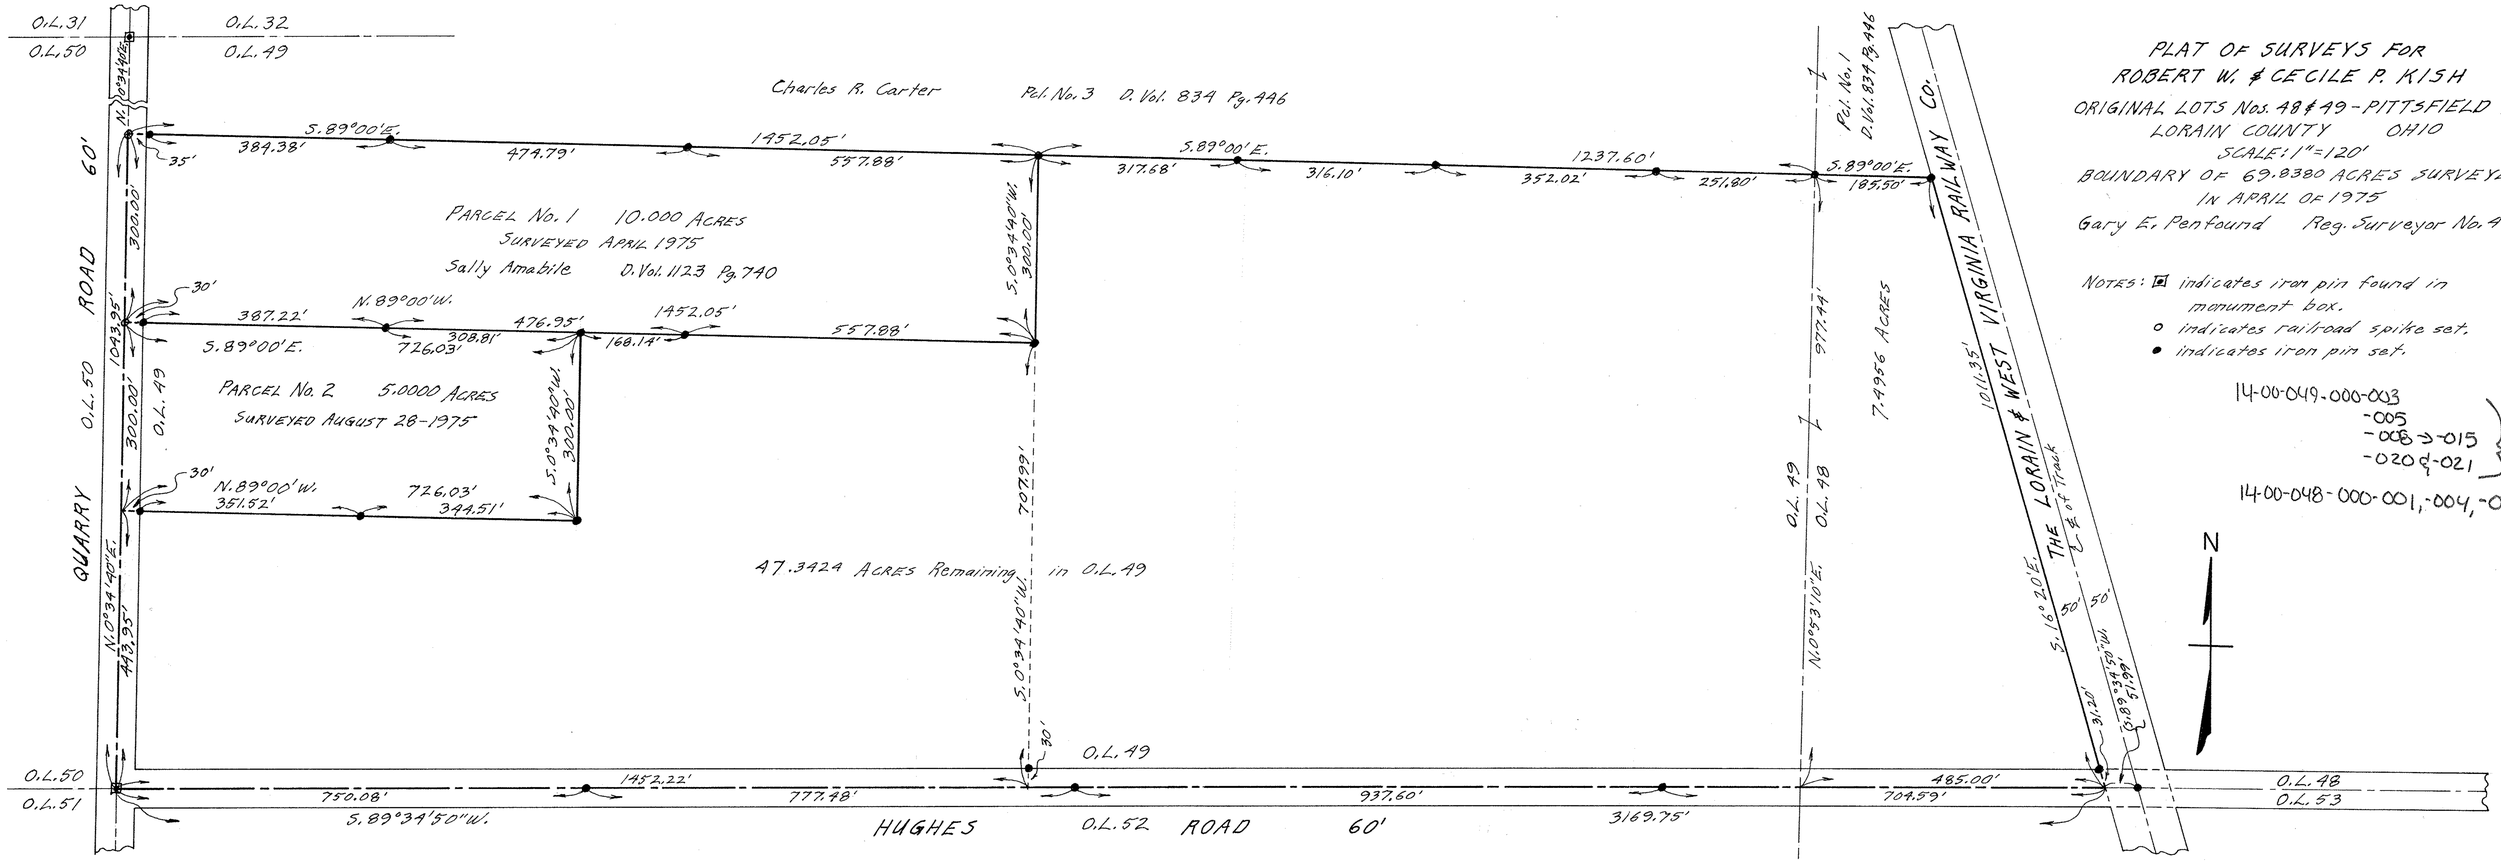
PLAT OF SURVEYS FOR
ROBERT W. & CECILE P. KISH
ORIGINAL LOTS Nos. 48 & 49 - PITTSFIELD TWP.
LORAIN COUNTY OHIO
SCALE: 1" = 120'
BOUNDARY OF 69.8380 ACRES SURVEYED
IN APRIL OF 1975
Gary E. Pentound Reg. Surveyor No. 4957
NOTES: ▣ indicates iron pin found in monument box.
o indicates railroad spike set.
• indicates iron pin set.
14-00-049-000-003
-005
-008 > -015
-020 & -021
14-A
14-00-048-000-001, -004, -005
N
Charles R. Carter Pcl. No. 3 D. Vol. 834 Pg. 496
Pcl. No. 1 D. Vol. 834 Pg. 496
PARCEL No. 1 10.000 ACRES
SURVEYED APRIL 1975
Sally Amabile D. Vol. 1123 Pg. 740
PARCEL No. 2 5.0000 ACRES
SURVEYED AUGUST 28-1975
7.4956 ACRES
47.3424 ACRES Remaining in O.L. 49
THE LORAIN & WEST VIRGINIA RAILWAY CO.
℄ of Track
QUARRY ROAD 60'
HUGHES ROAD 60'
O.L. 31
O.L. 32
O.L. 50
O.L. 49
O.L. 48
O.L. 51
O.L. 52
O.L. 53
S. 89°00'E.
N. 89°00'W.
S. 0°34'40"W.
N. 0°34'40"E.
S. 89°34'50"W.
N. 0°53'10"E.
S. 16°20'E.
1452.05'
1452.22'
1237.60'
3169.75'
937.60'
777.48'
750.08'
485.00'
704.59'
977.49'
1011.35'
1043.95'
300.00'
707.99'
14-00-048,049