PLAT OF SURVEYS FOR

ROSALIA LINDEN

LORAIN COUNTY CARLISLE TOWNSHIP

SECTION NO. 23 OHIO

SCALE: 1" = 60' JUNE 5-1966

Gary E. Penfound Reg. Surveyor No. 4457

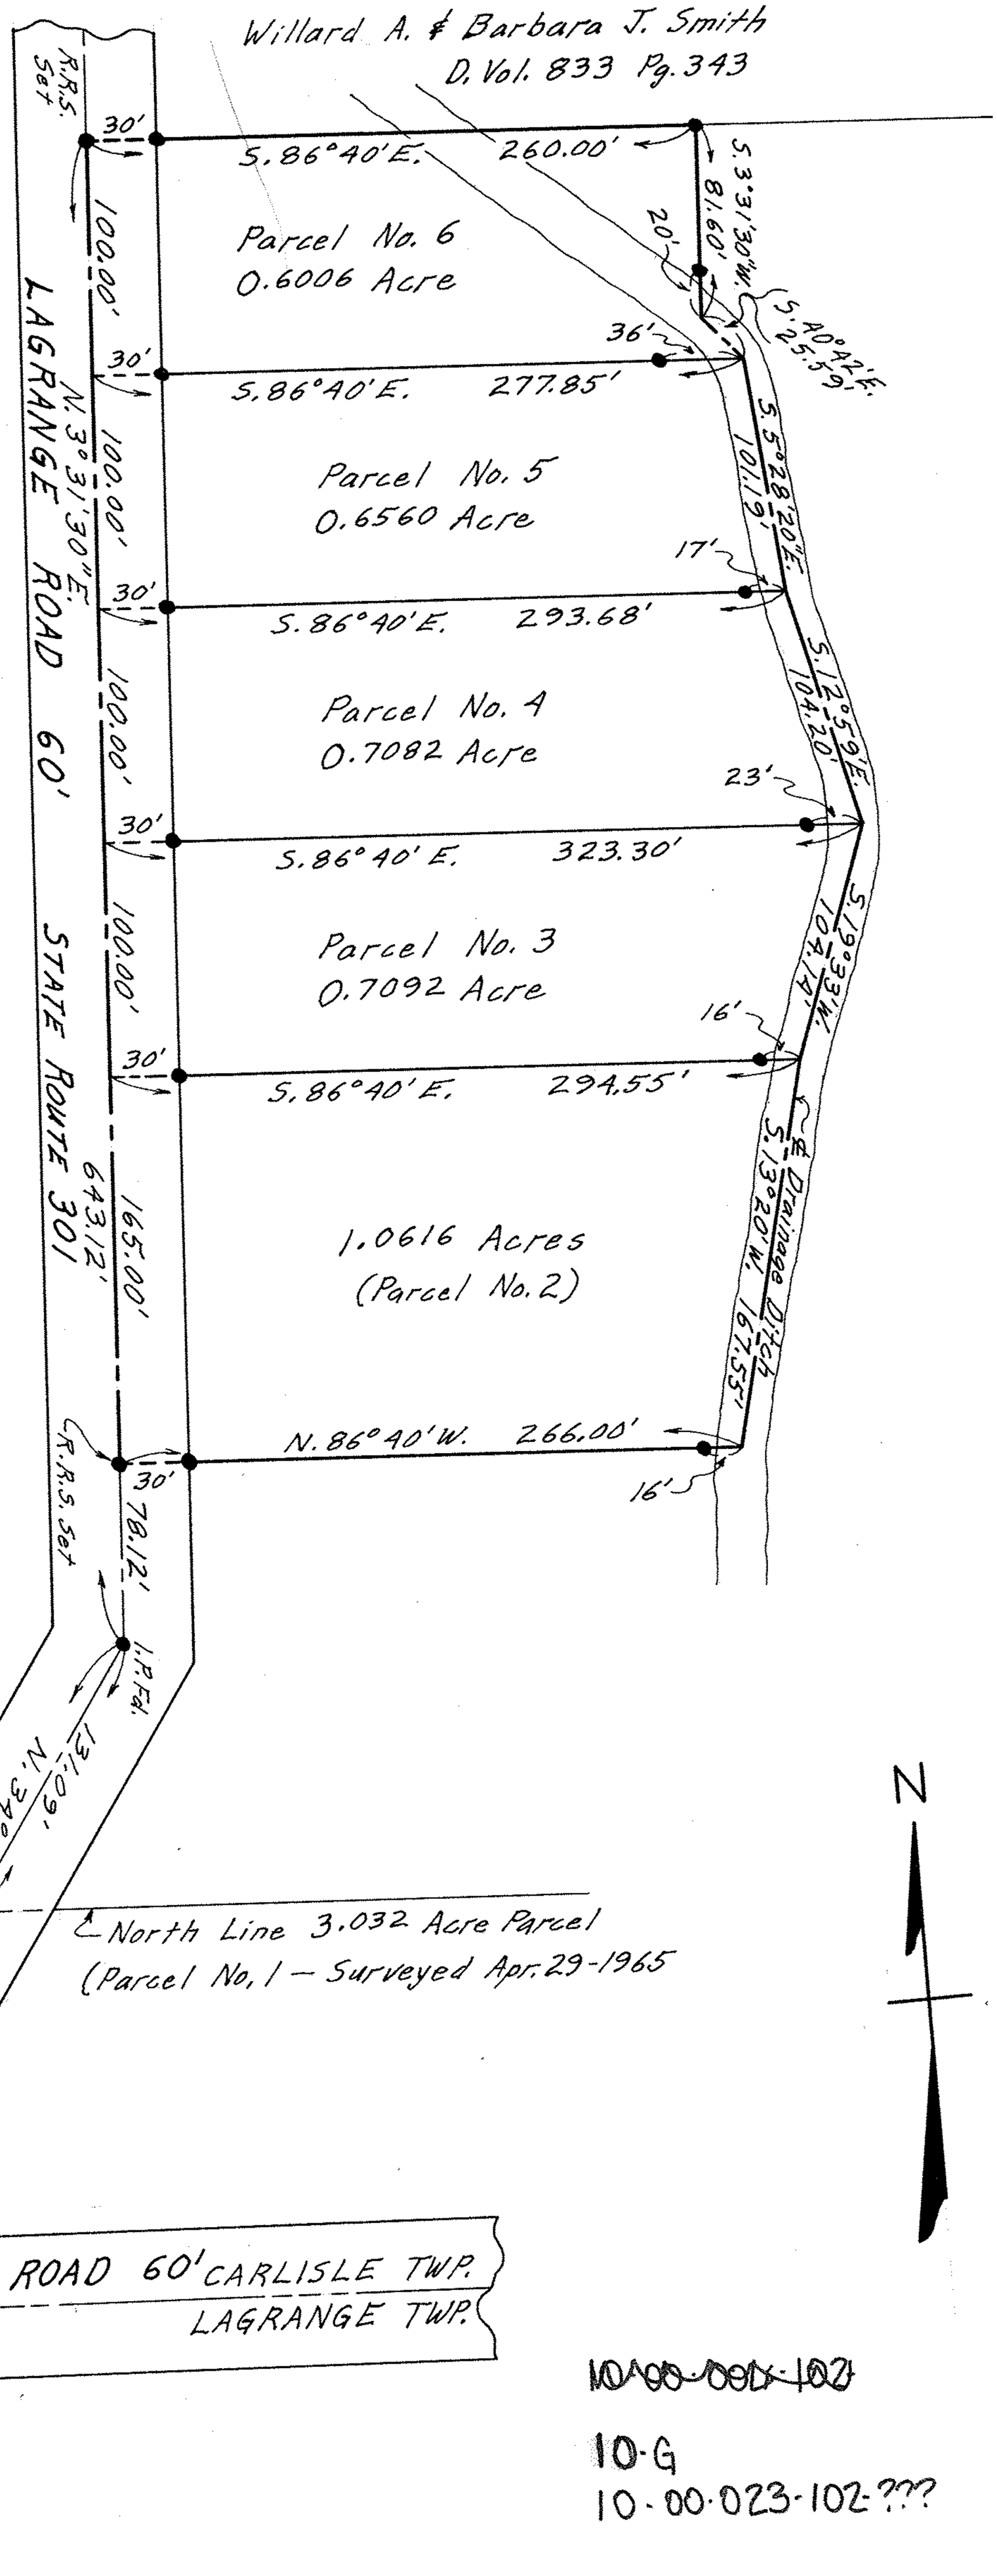

NOTE: • indicates iron pin set unless otherwise designated.

10-00-023

10-00-023-102

10-G

10-00-023-102-???