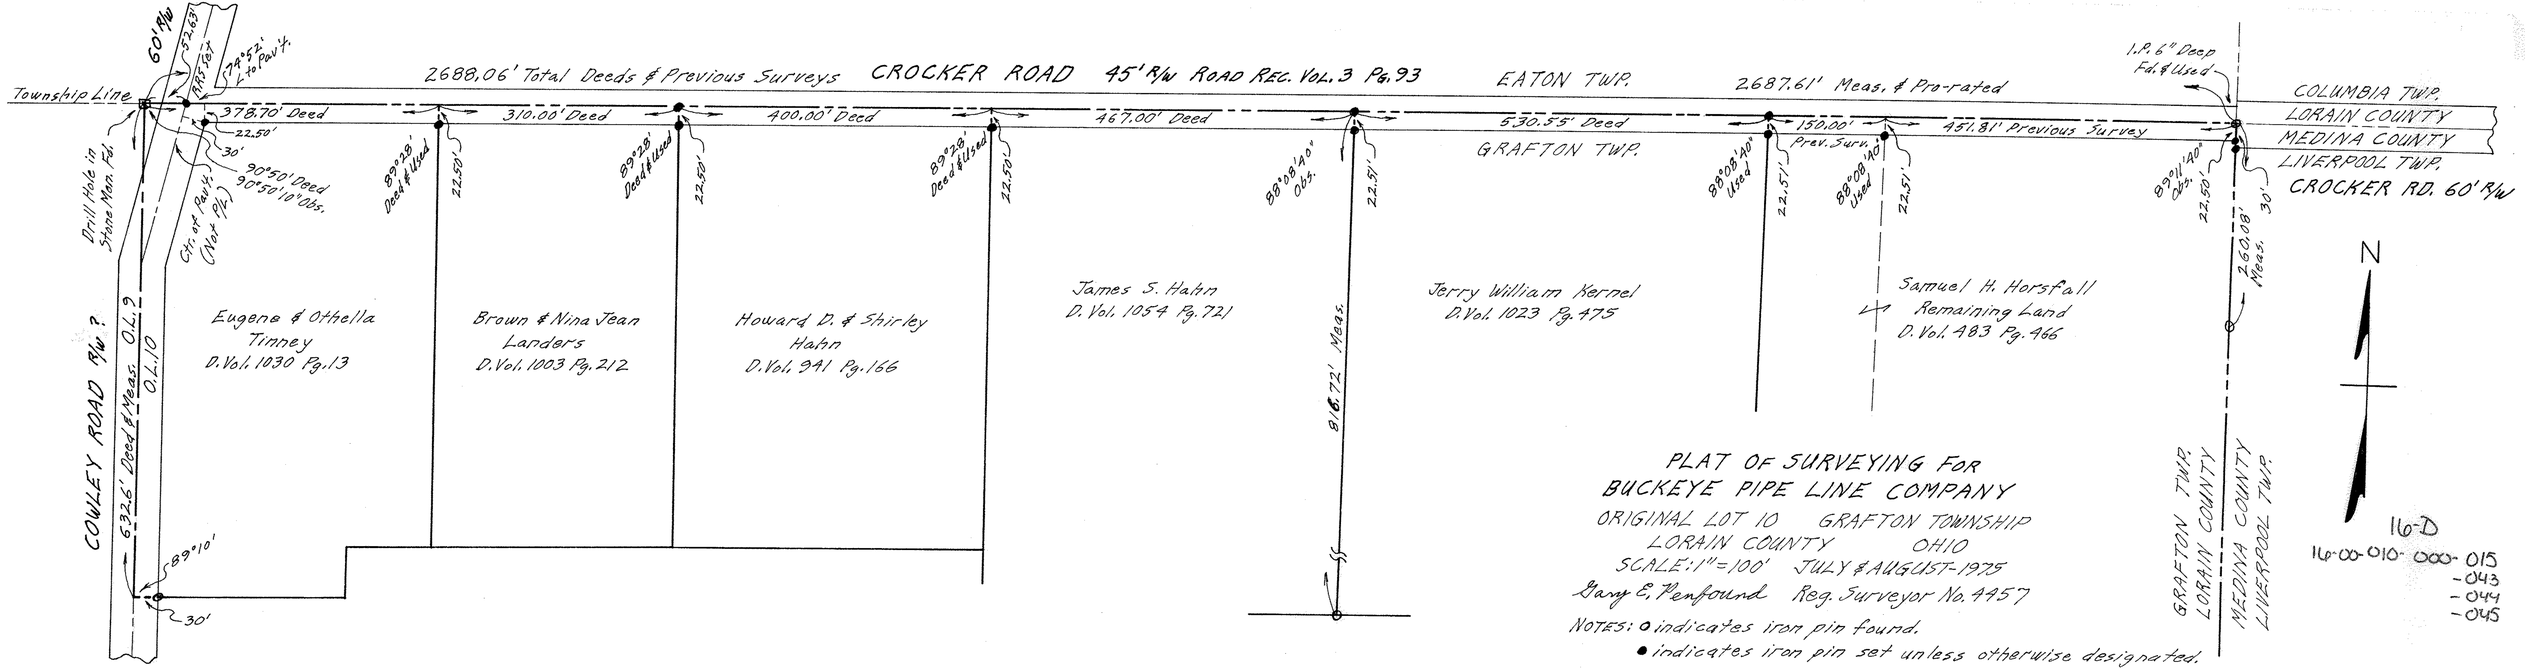

PLAT OF SURVEYING FOR
BUCKEYE PIPE LINE COMPANY

ORIGINAL LOT 10 GRAFTON TOWNSHIP
LORAIN COUNTY OHIO
SCALE: 1" = 100' JULY & AUGUST - 1975
Gary E. Penfound Reg. Surveyor No. 4457

NOTES: ○ indicates iron pin found.
● indicates iron pin set unless otherwise designated.