


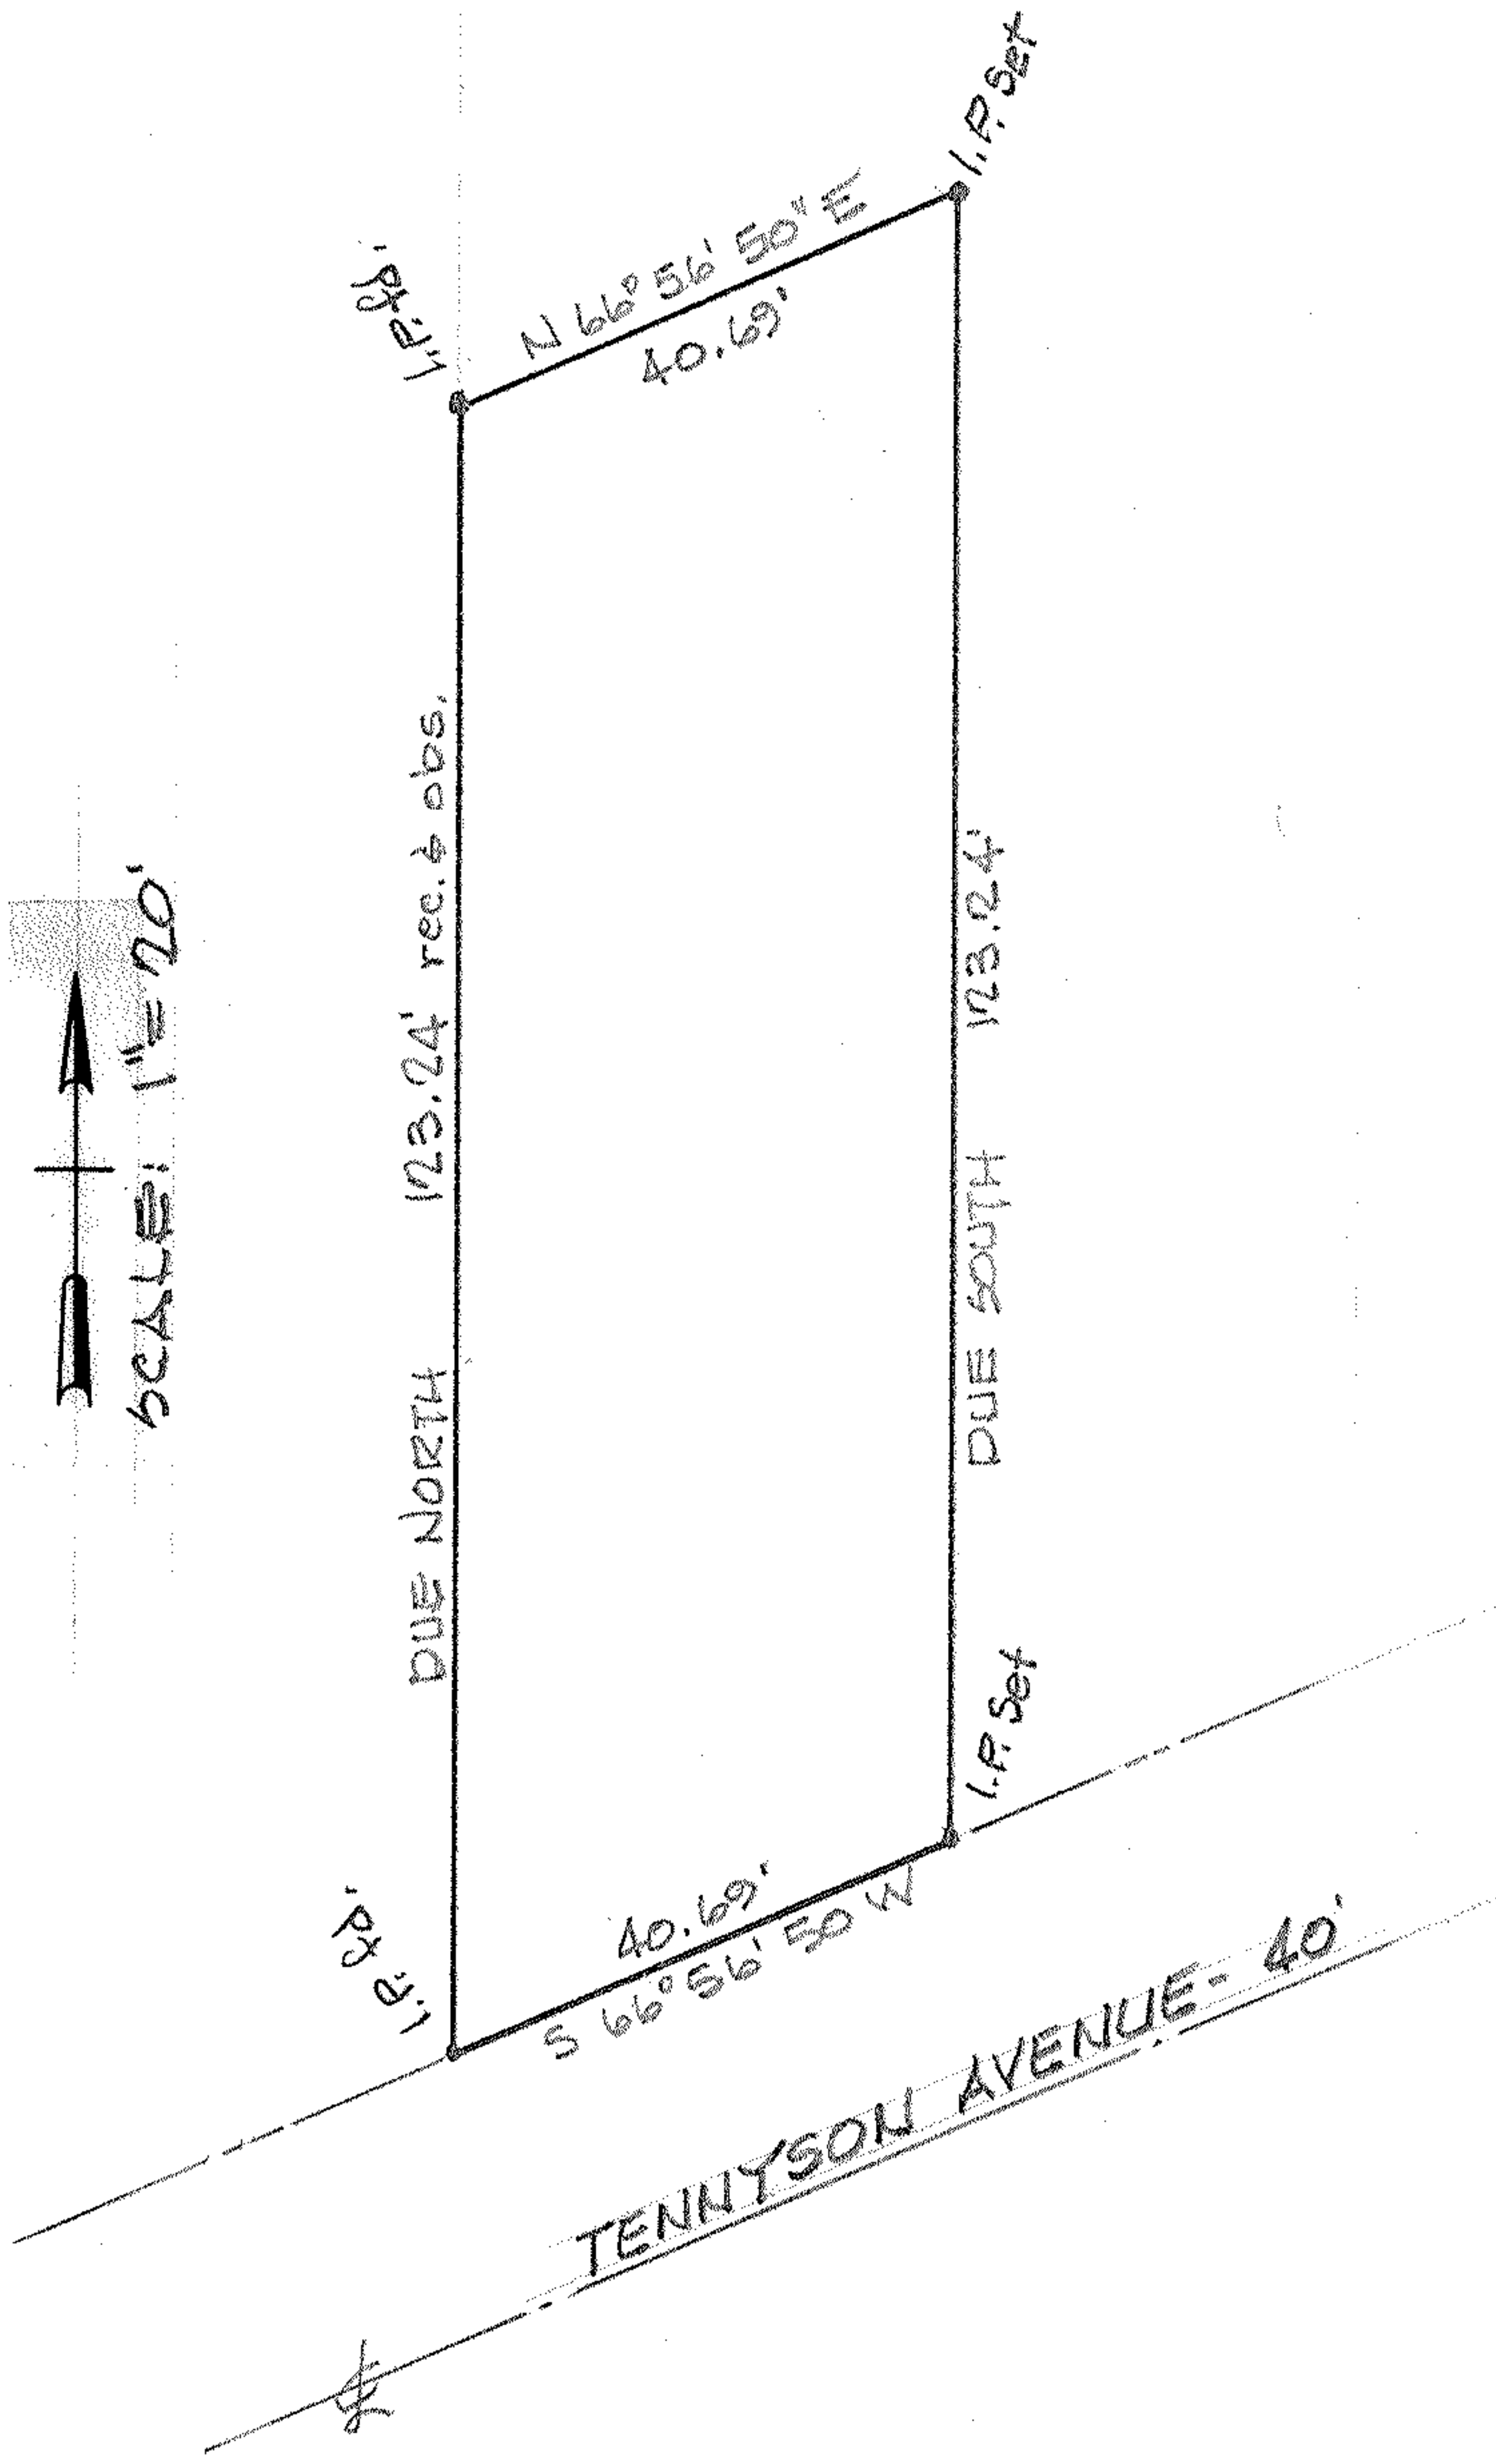




MAP of SURVEY

PREPARED FOR FRANK SNEZEK

SUBLOT 673 of LAKE BREEZE ALLOTMENT

PART of ORIG. SHEFFIELD TWP. LOT No. 42

CITY of SHEFFIELD LAKE, LOZAIN CO., OHIO

McGLINCHY & ASSOC., INC

EUZRIA OHIO

MAY, 1977 #195290

03-00-042-104-025

3-00-042-A