05-00-037-B

05-00-037-104-001

05-00-037-105-001 thru 011

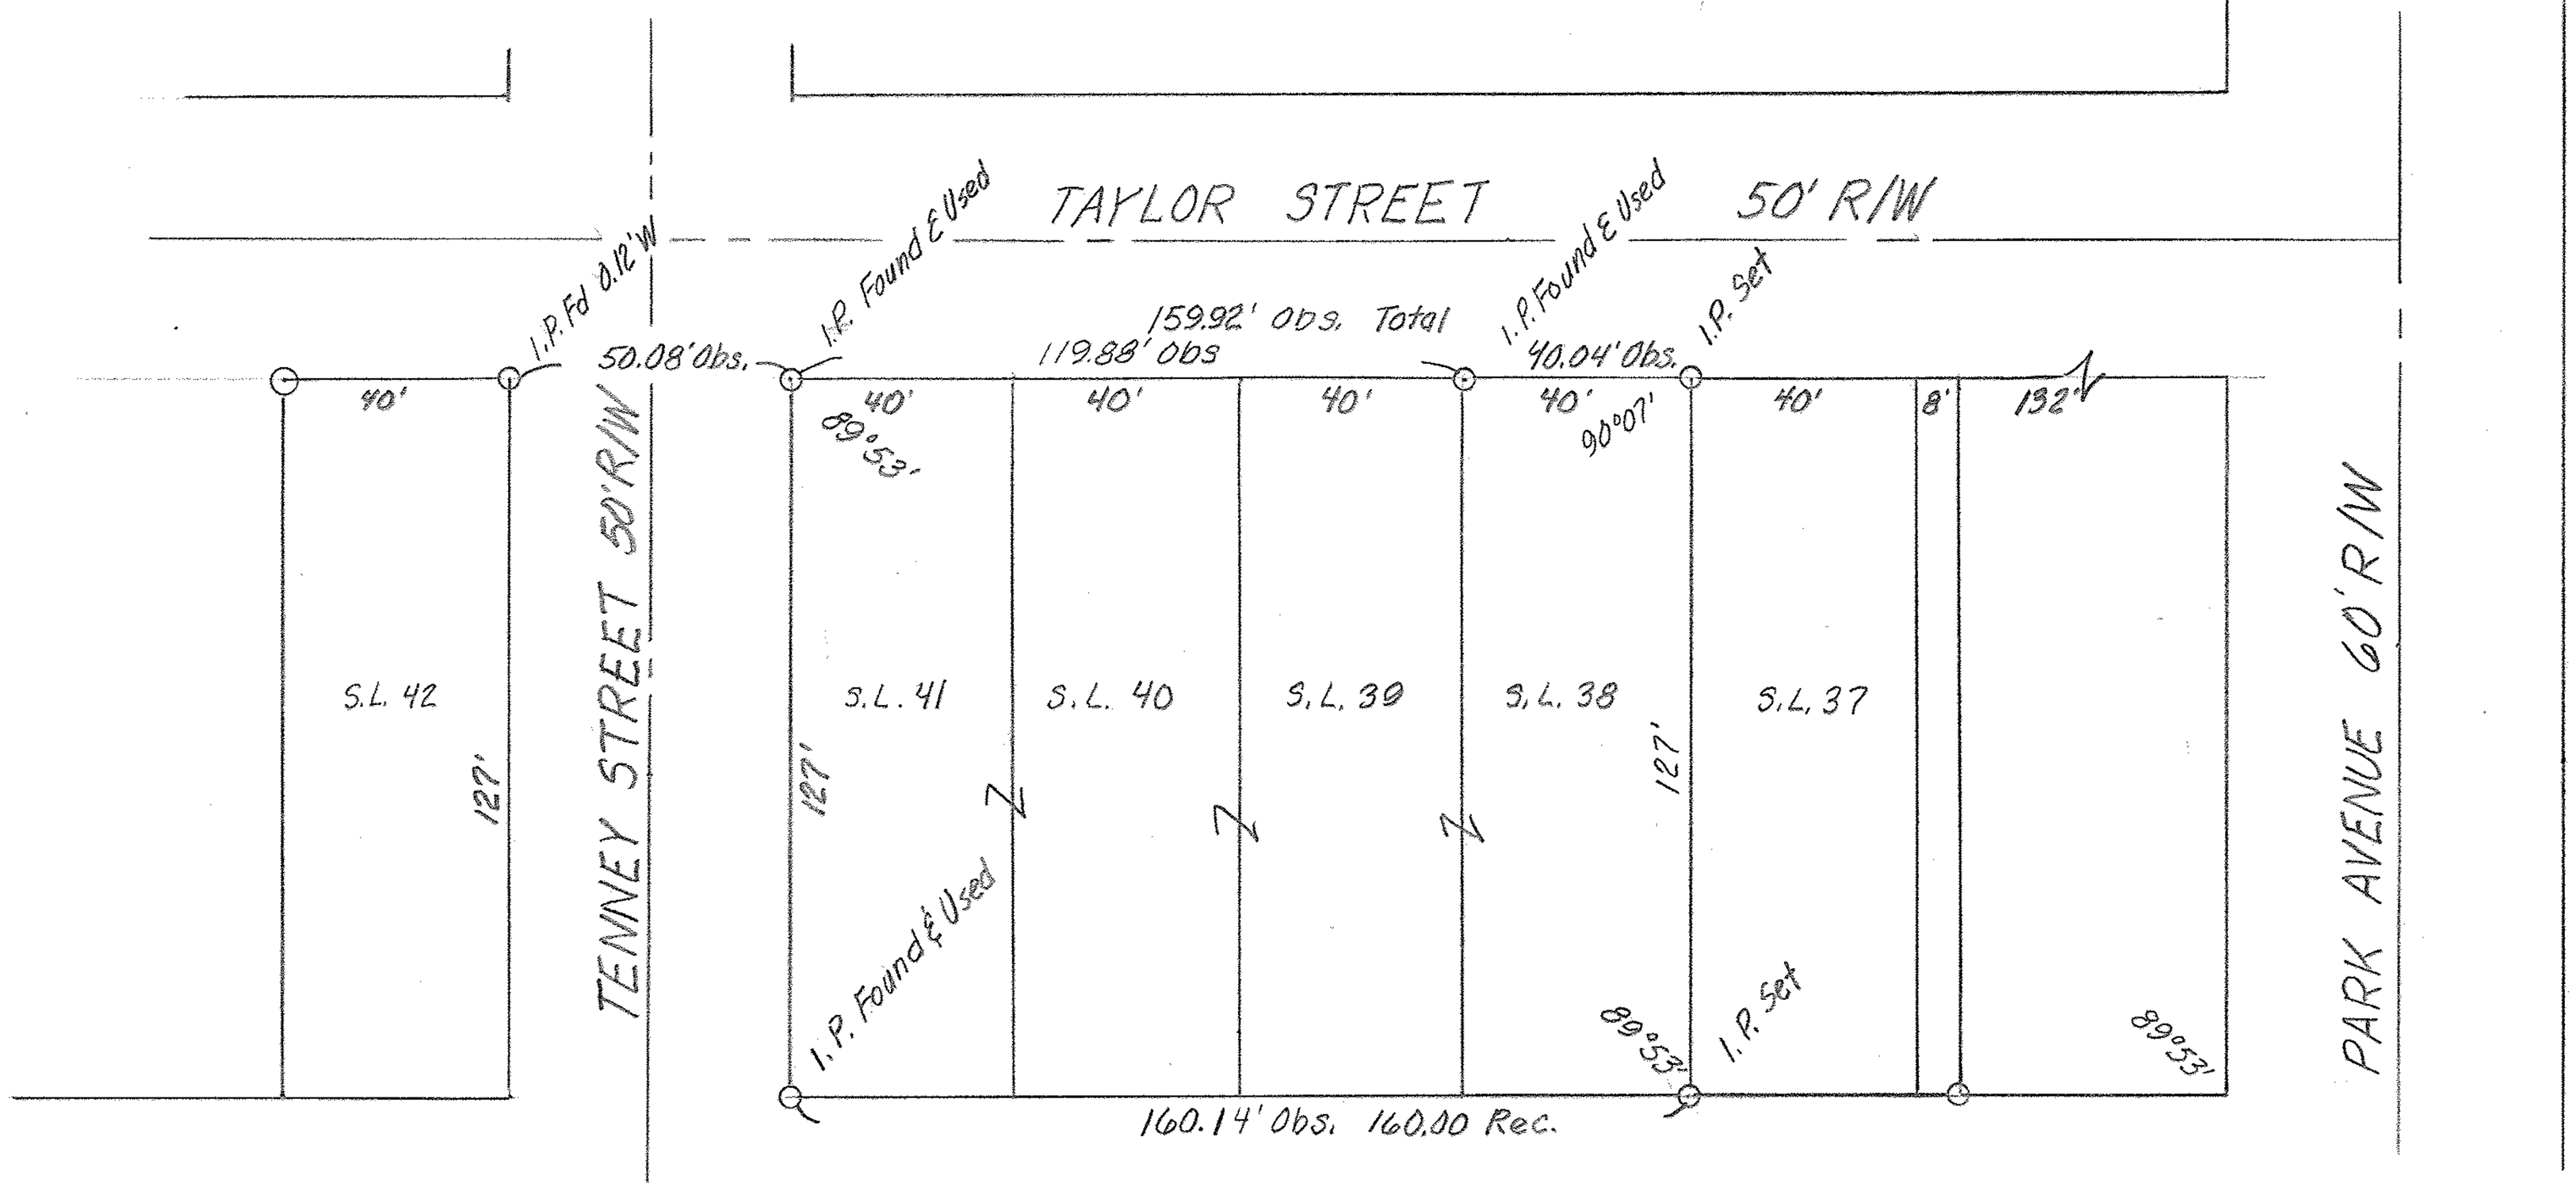

PLAT OF SURVEY FOR
ROBERTA & GREG HOOPES

SUBLOTS 38, 39, 40, 41 B.E. TAYLOR ADD'N.
VOLUME 7, PAGE 4 LORAIN CO. PLAT RECORDS
ORIGINAL LOT 37 AMHERST TOWNSHIP
LORAIN COUNTY, OHIO

McGLINCHY AND ASSOCIATES
PROFESSIONAL ENGINEERS AND SURVEYORS
625 North Woodhill Drive Amherst, Ohio

SCALE: 1"=30' DRAWN BY: E.V. McGlinchy

DATE: 7/4/91 JOB NO: 918820