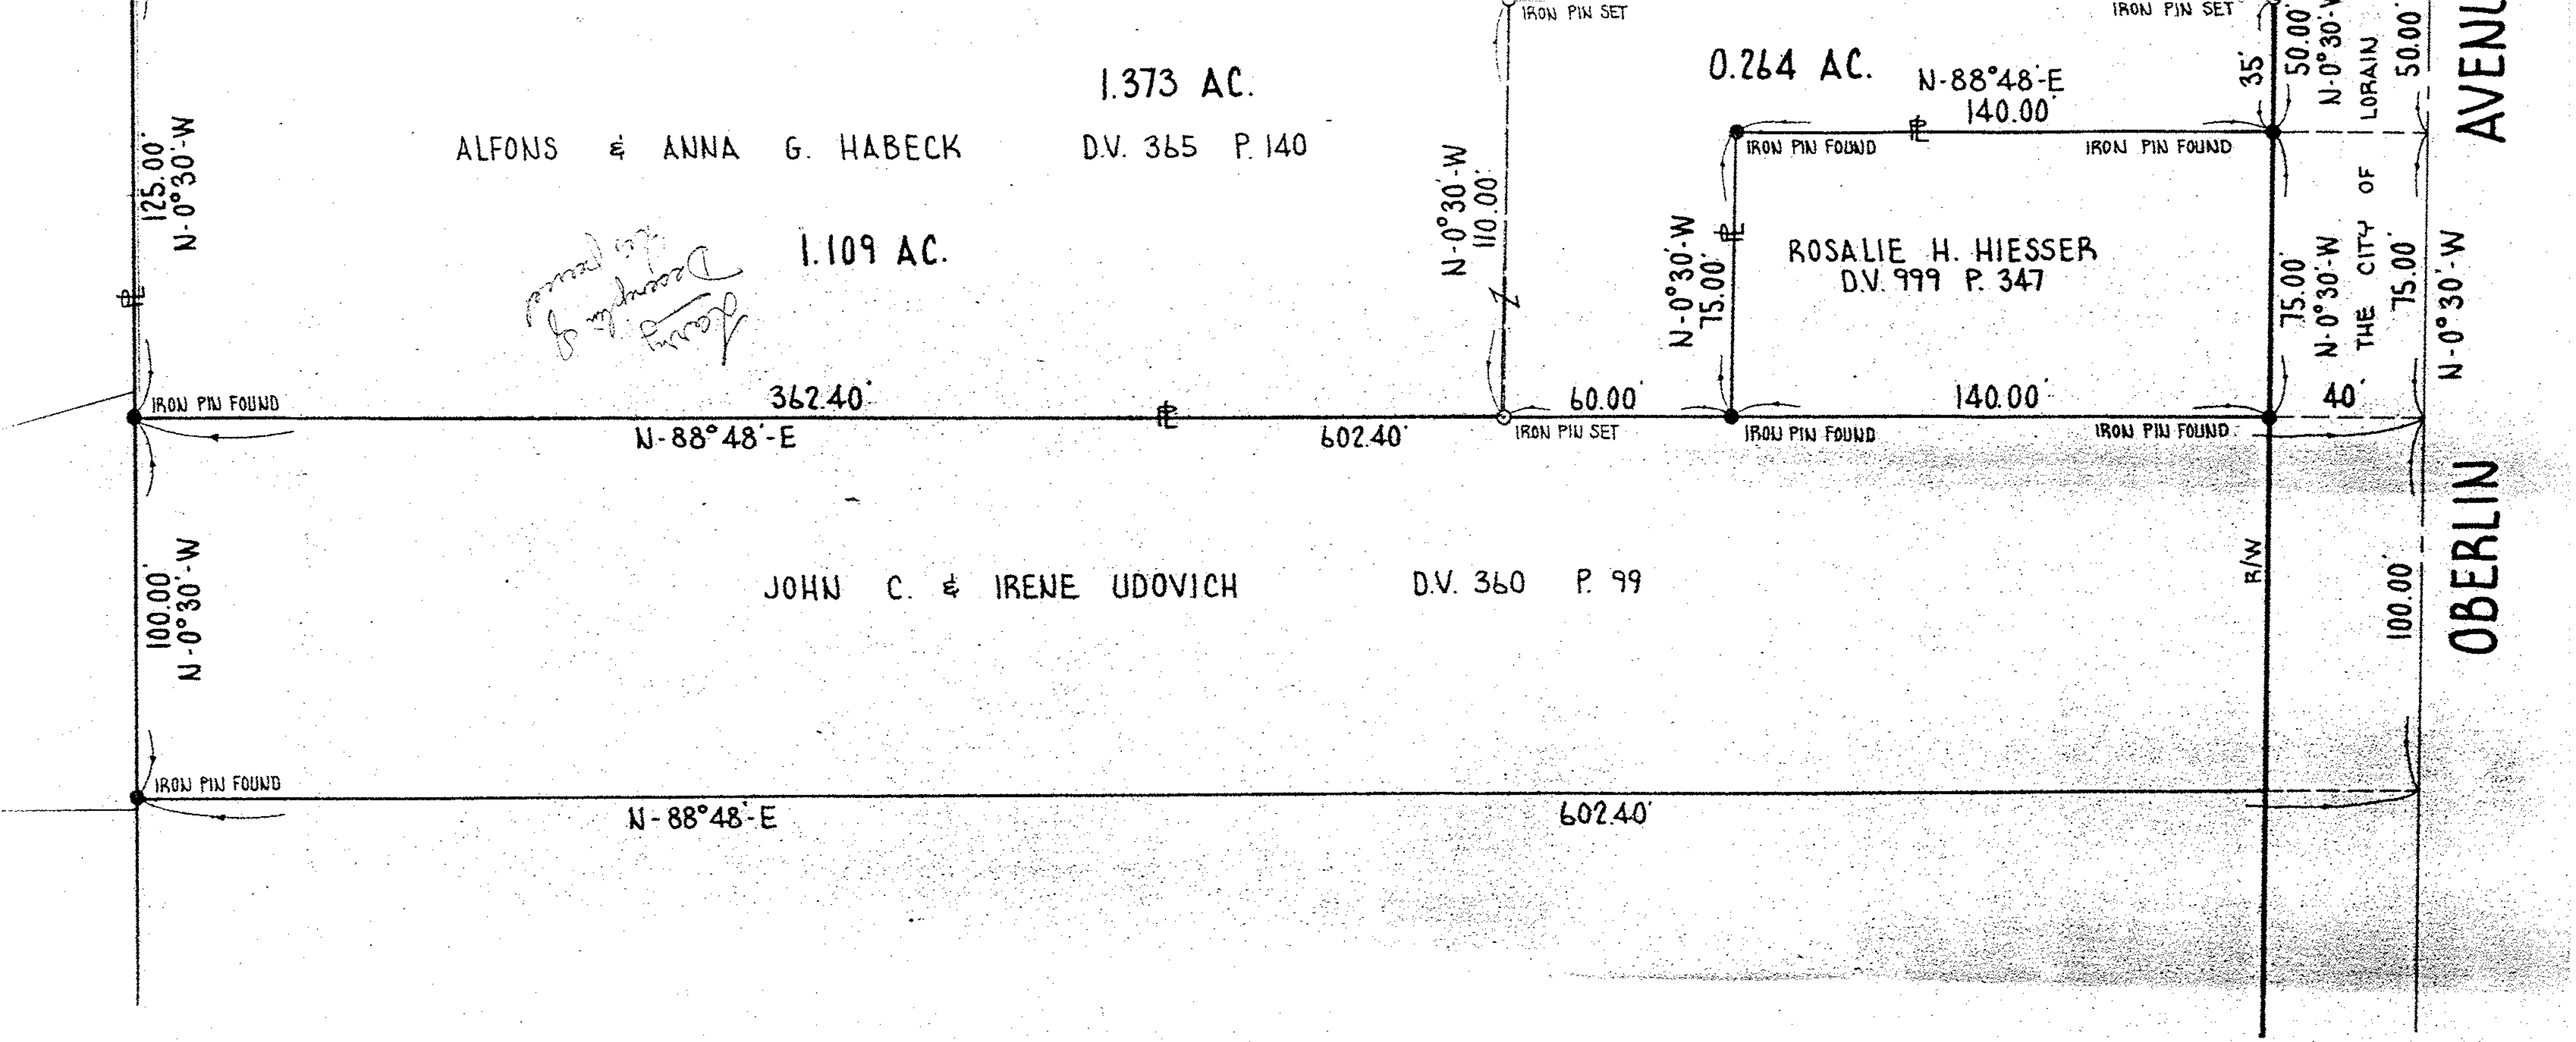

BOUNDARY SURVEY OF PART OF

BLACK RIVER TOWNSHIP ORIGINAL LOT 5 TRACT 2

CITY OF LORAIN COUNTY OF LORAIN STATE OF OHIO

SCALE: 1" = 40' JAN. 15, 1979

PREPARED BY

KLEINOEDER - SCHMIDT & ASSOCIATES

CONSULTING ENGINEERS & SURVEYORS

ELYRIA OHIO

TO CERTIFY THAT I HAVE SURVEYED
73 ACRE PARCEL AS SHOWN HEREON
LT THIS MAP IS A CORRECT REPRESEN-
THEREOF.

Robert E. Kleinoeder
REGISTERED SURVEYOR

02-02-005-108-050
02-02-005-B

JOB NO.
79-04