


05-00-015-000-020 thru-028 05-00-015-B  
 05-00-026-102-001,032,031 05-00-026-A



Note :- Iron pins found or set shown thus. •

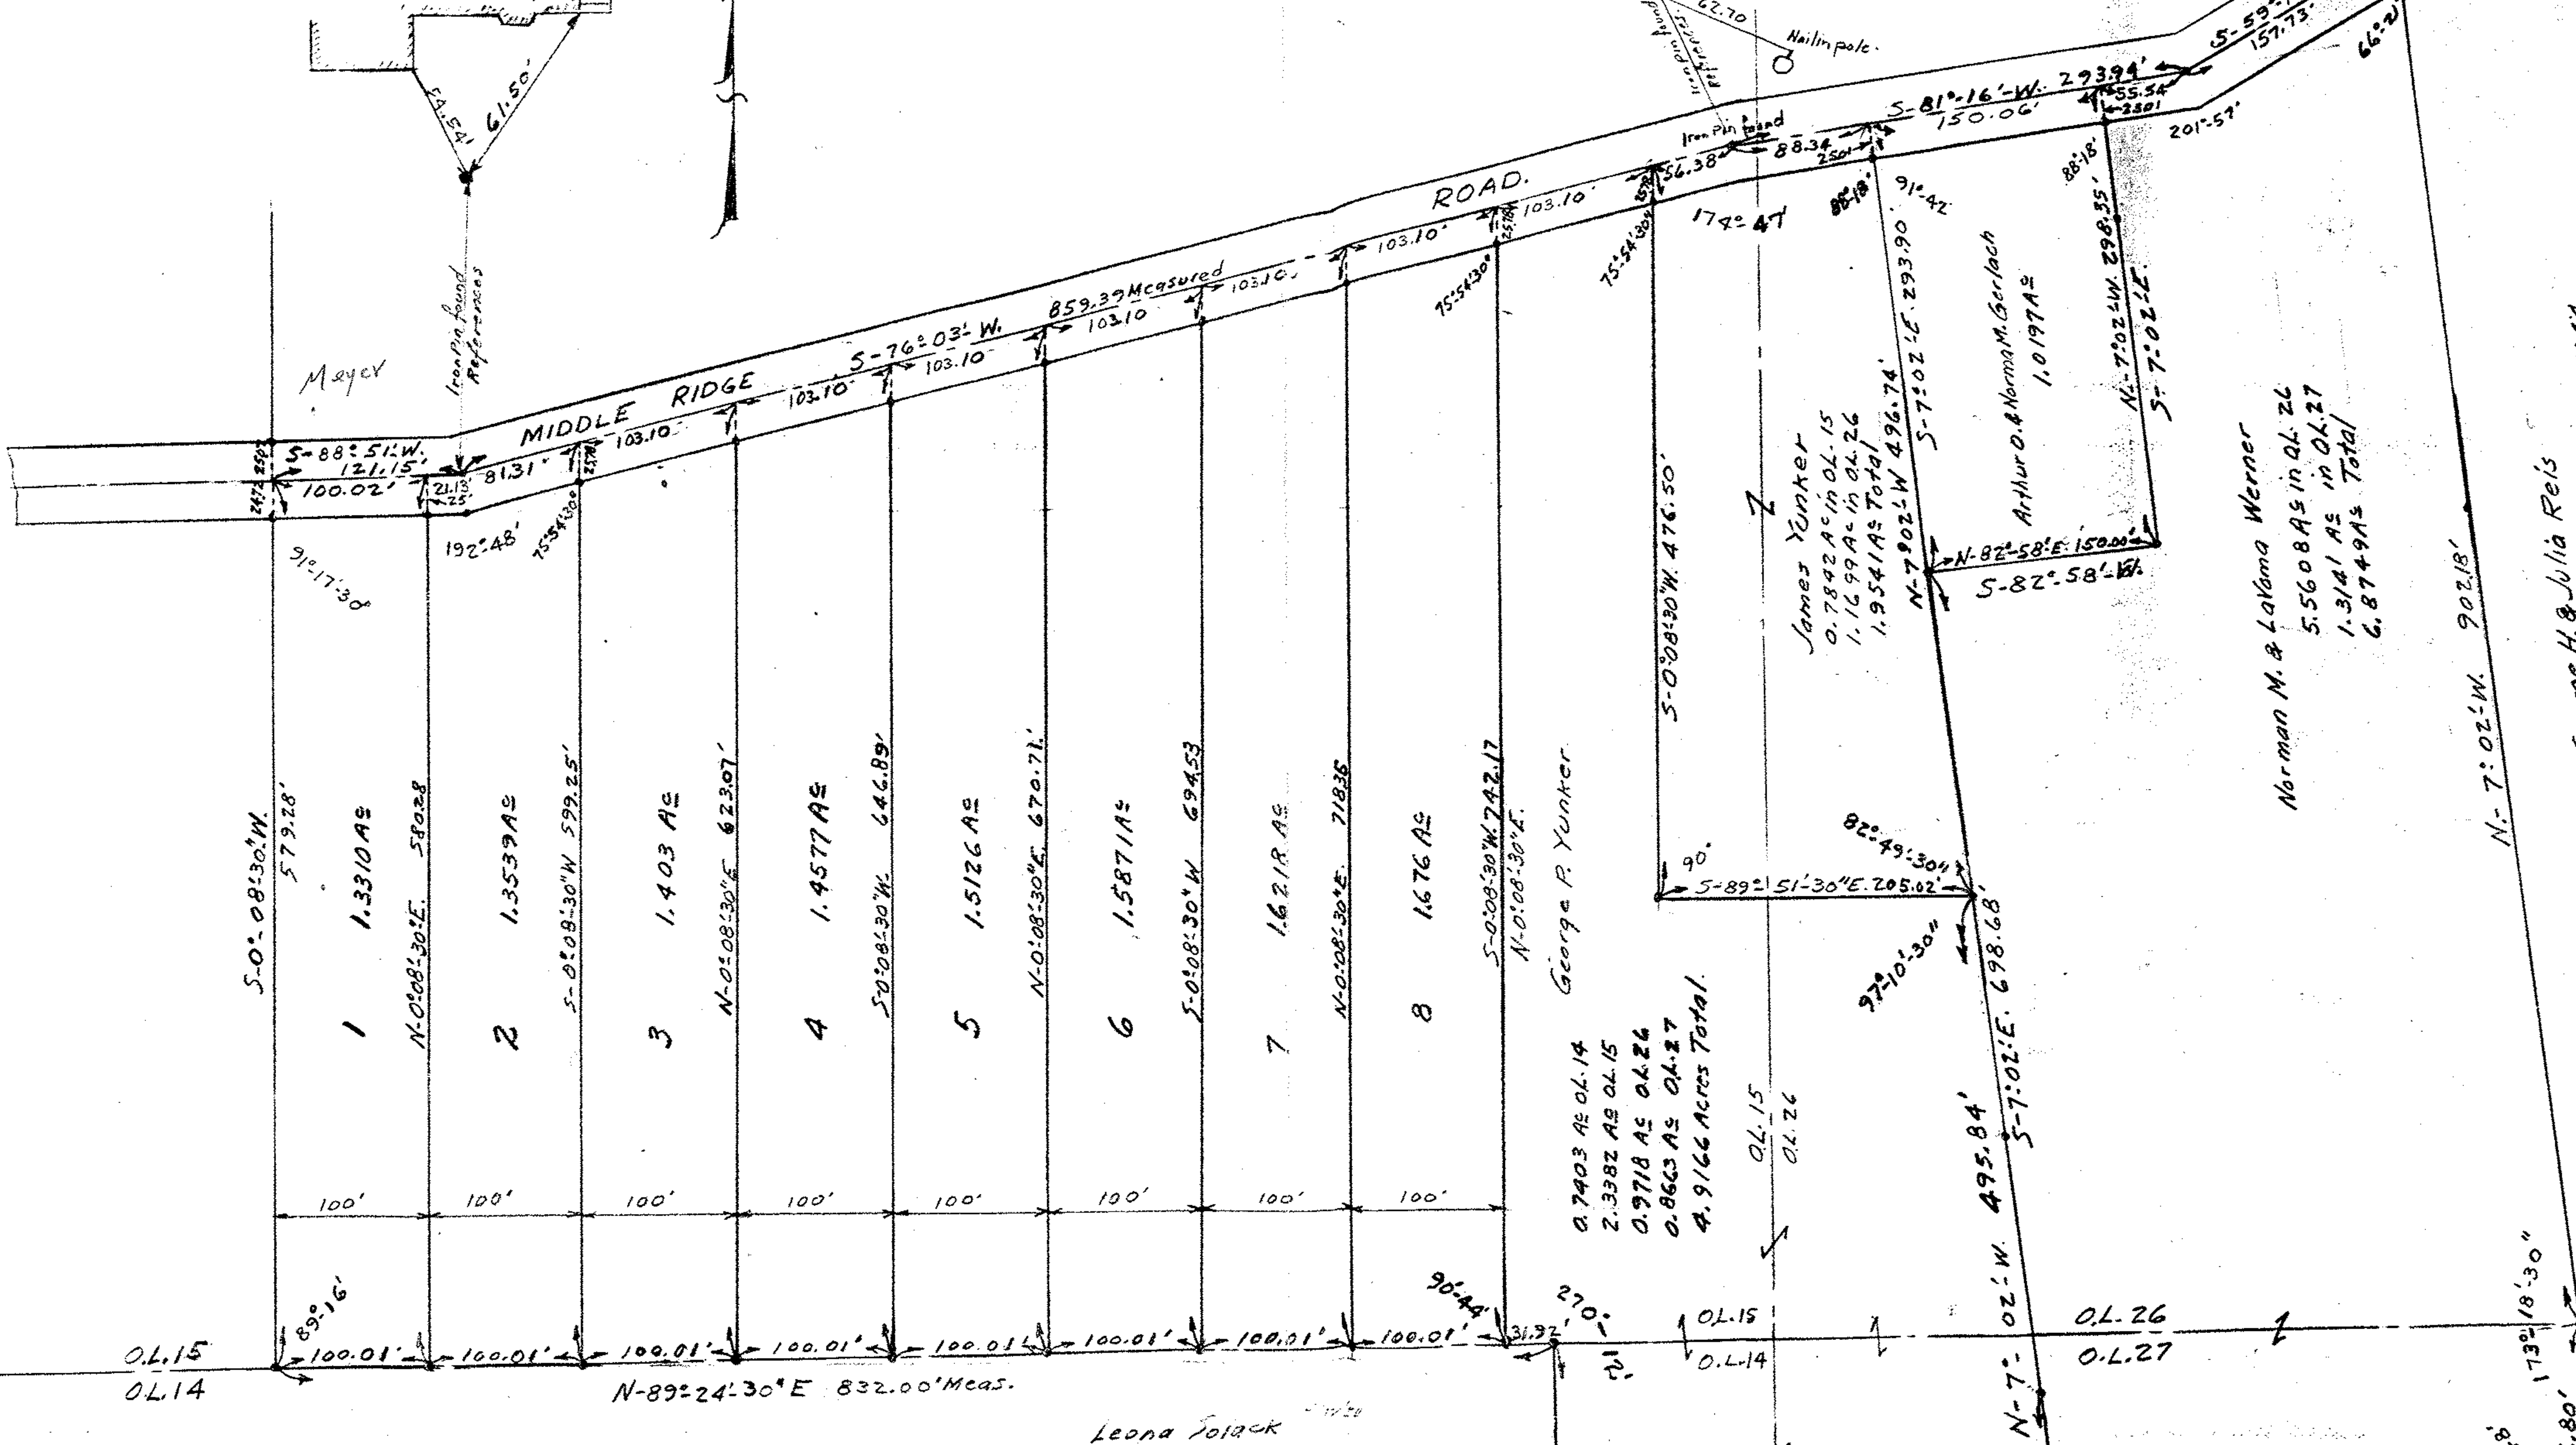

MAP OF SURVEY FOR  
 George P. YUNKER  
 OL 14-15-26-27 AMHERST TOWNSHIP

Leona Tolack

James Yunker  
 0.7842 AS in OL. 15  
 1.1699 AS in OL. 26  
 1.9541 AS Total

George P. Yunker  
 0.7403 AS OL. 14  
 2.3382 AS OL. 15  
 0.9718 AS OL. 26  
 0.8663 AS OL. 27  
 4.9166 Acres Total

Norman M. & Layama Werner  
 5.5608 AS in OL. 26  
 1.3141 AS in OL. 27  
 6.8749 AS Total

George H. & Julia Reis  
 April 21-1944