07-00-001-000-026

07-00-001-C

Karl Kiesel D. Vol. 977 Pg. 665

Mae F. Burke, Agnes Smith & Edmund Burke
Parcel No. 1 C/T Vol. 910 Pg. 97

Parcel No. 1 D. Vol. 707 Pg. 37

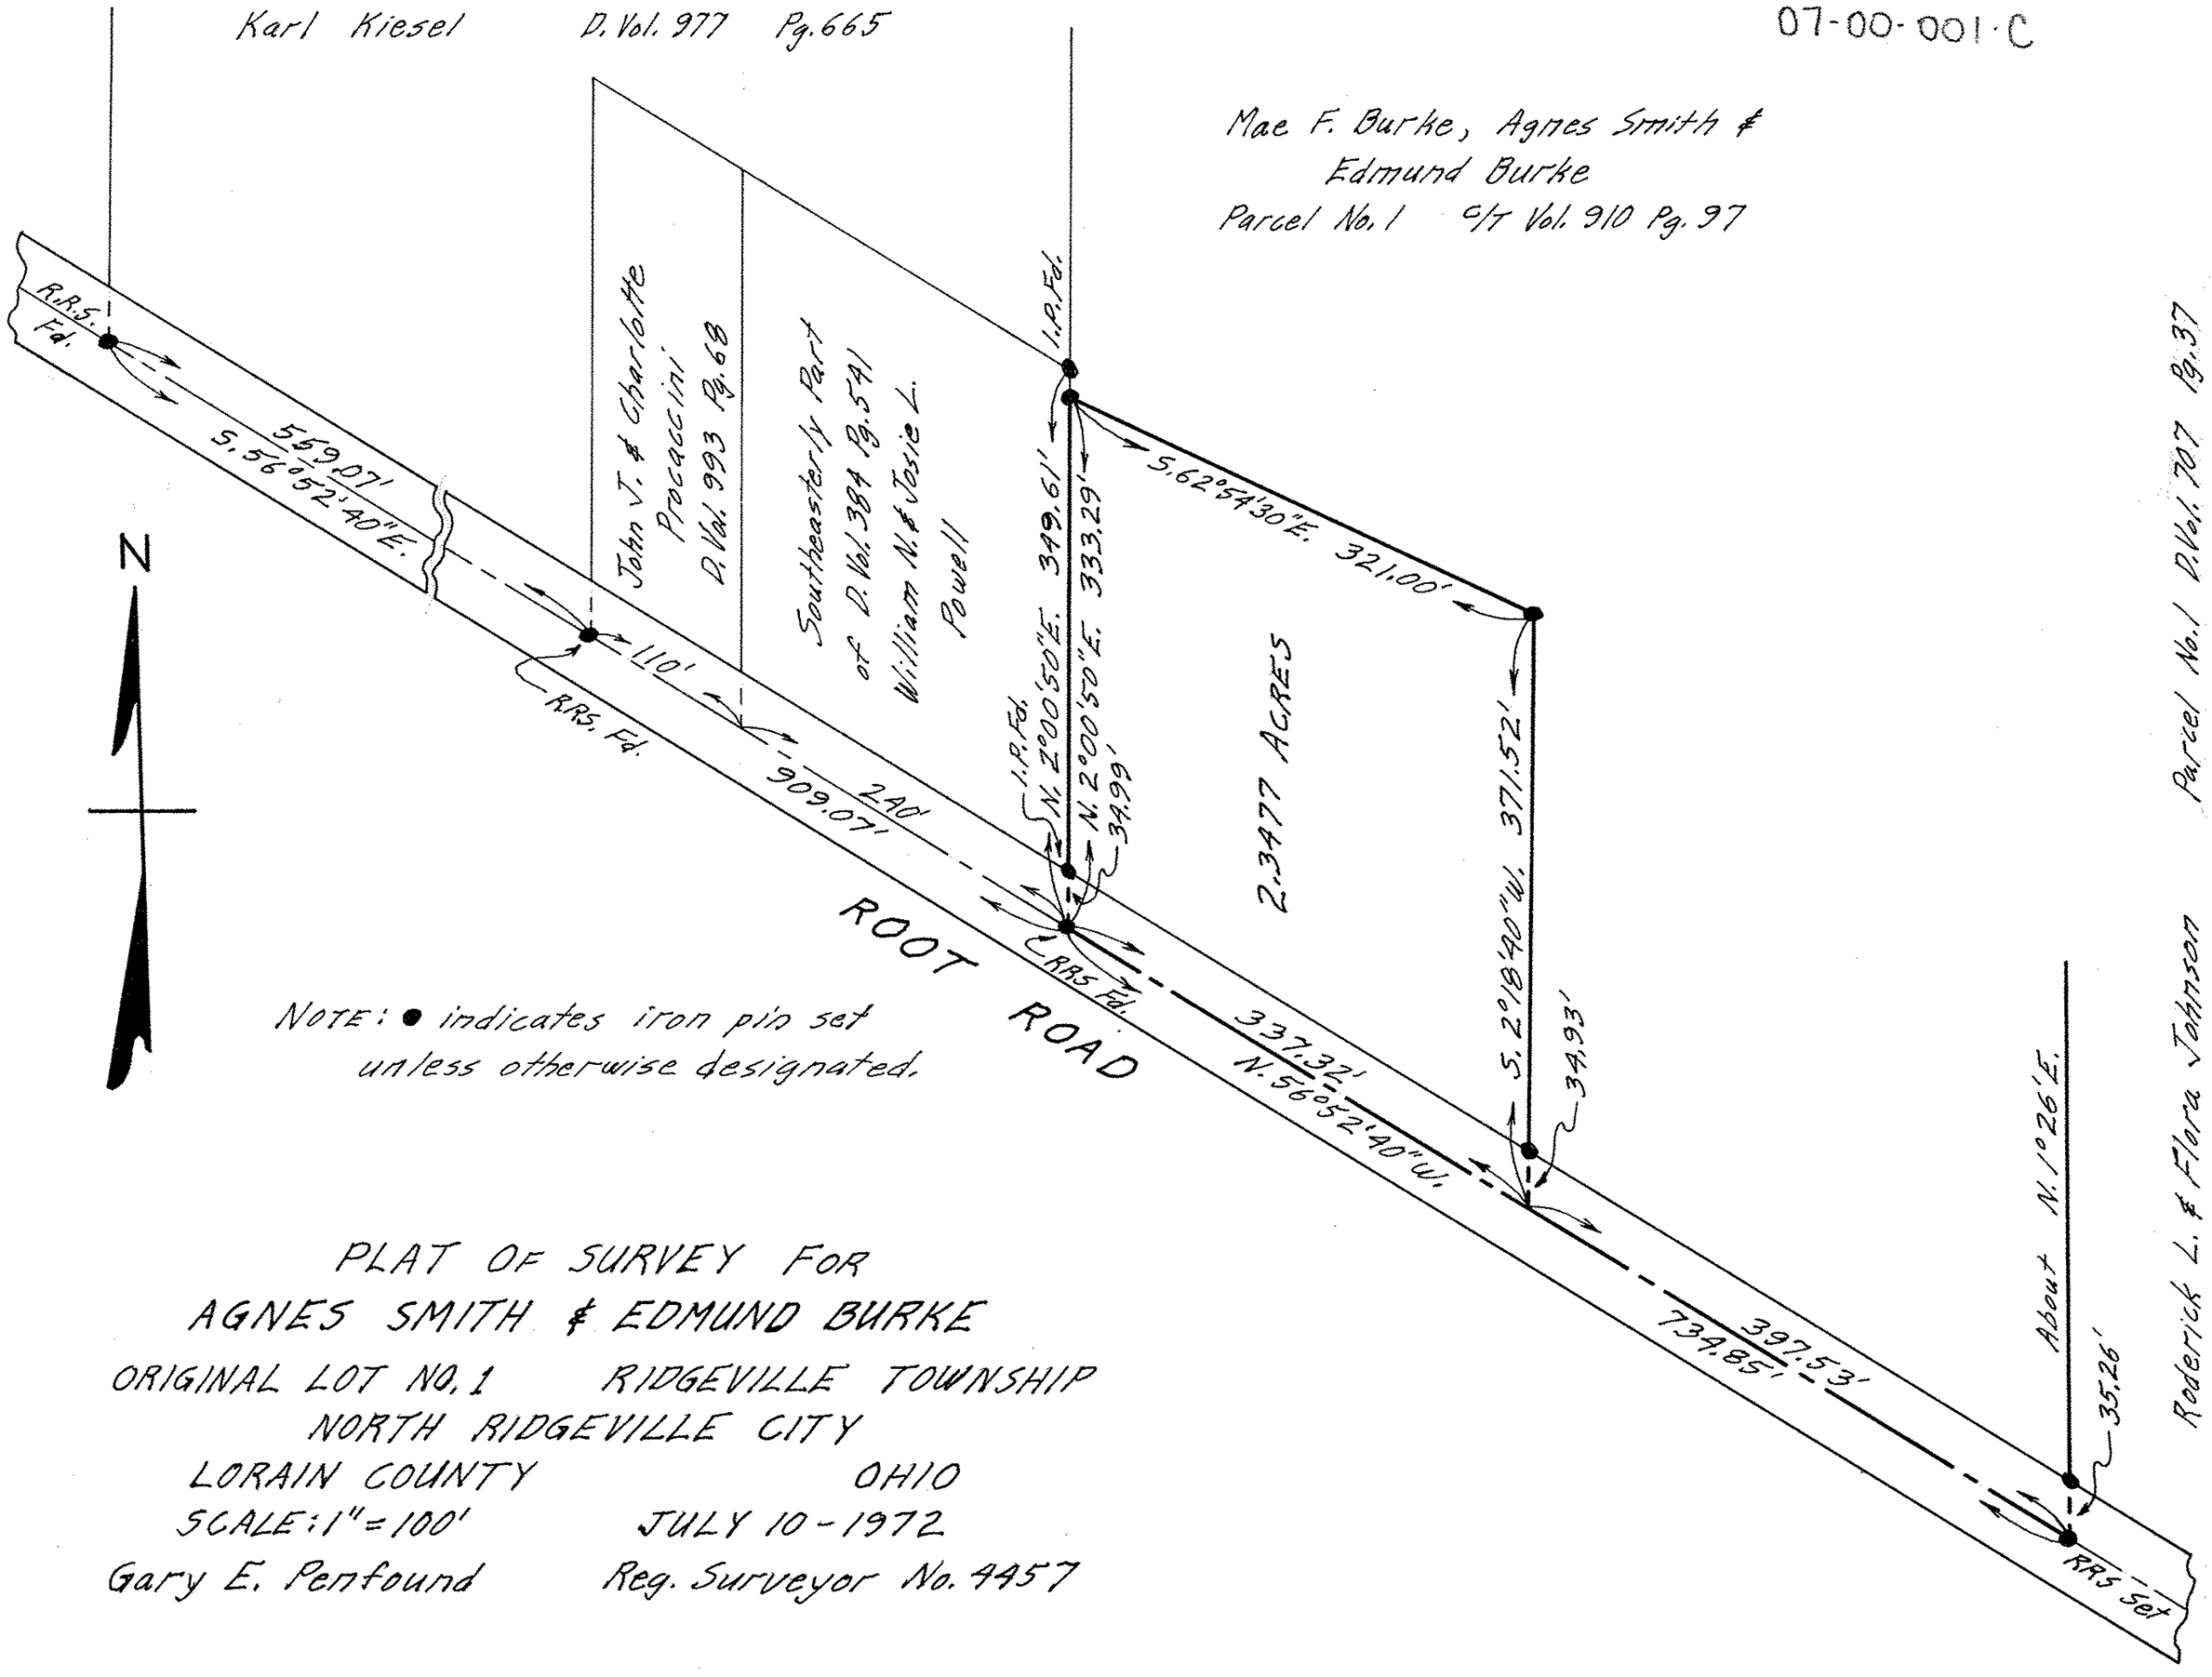

NOTE: ● indicates iron pin set unless otherwise designated.

PLAT OF SURVEY FOR
AGNES SMITH & EDMUND BURKE

ORIGINAL LOT NO. 1 RIDGEVILLE TOWNSHIP
NORTH RIDGEVILLE CITY
LORAIN COUNTY OHIO
SCALE: 1" = 100' JULY 10 - 1972
Gary E. Penfound Reg. Surveyor No. 4457

07-00-001