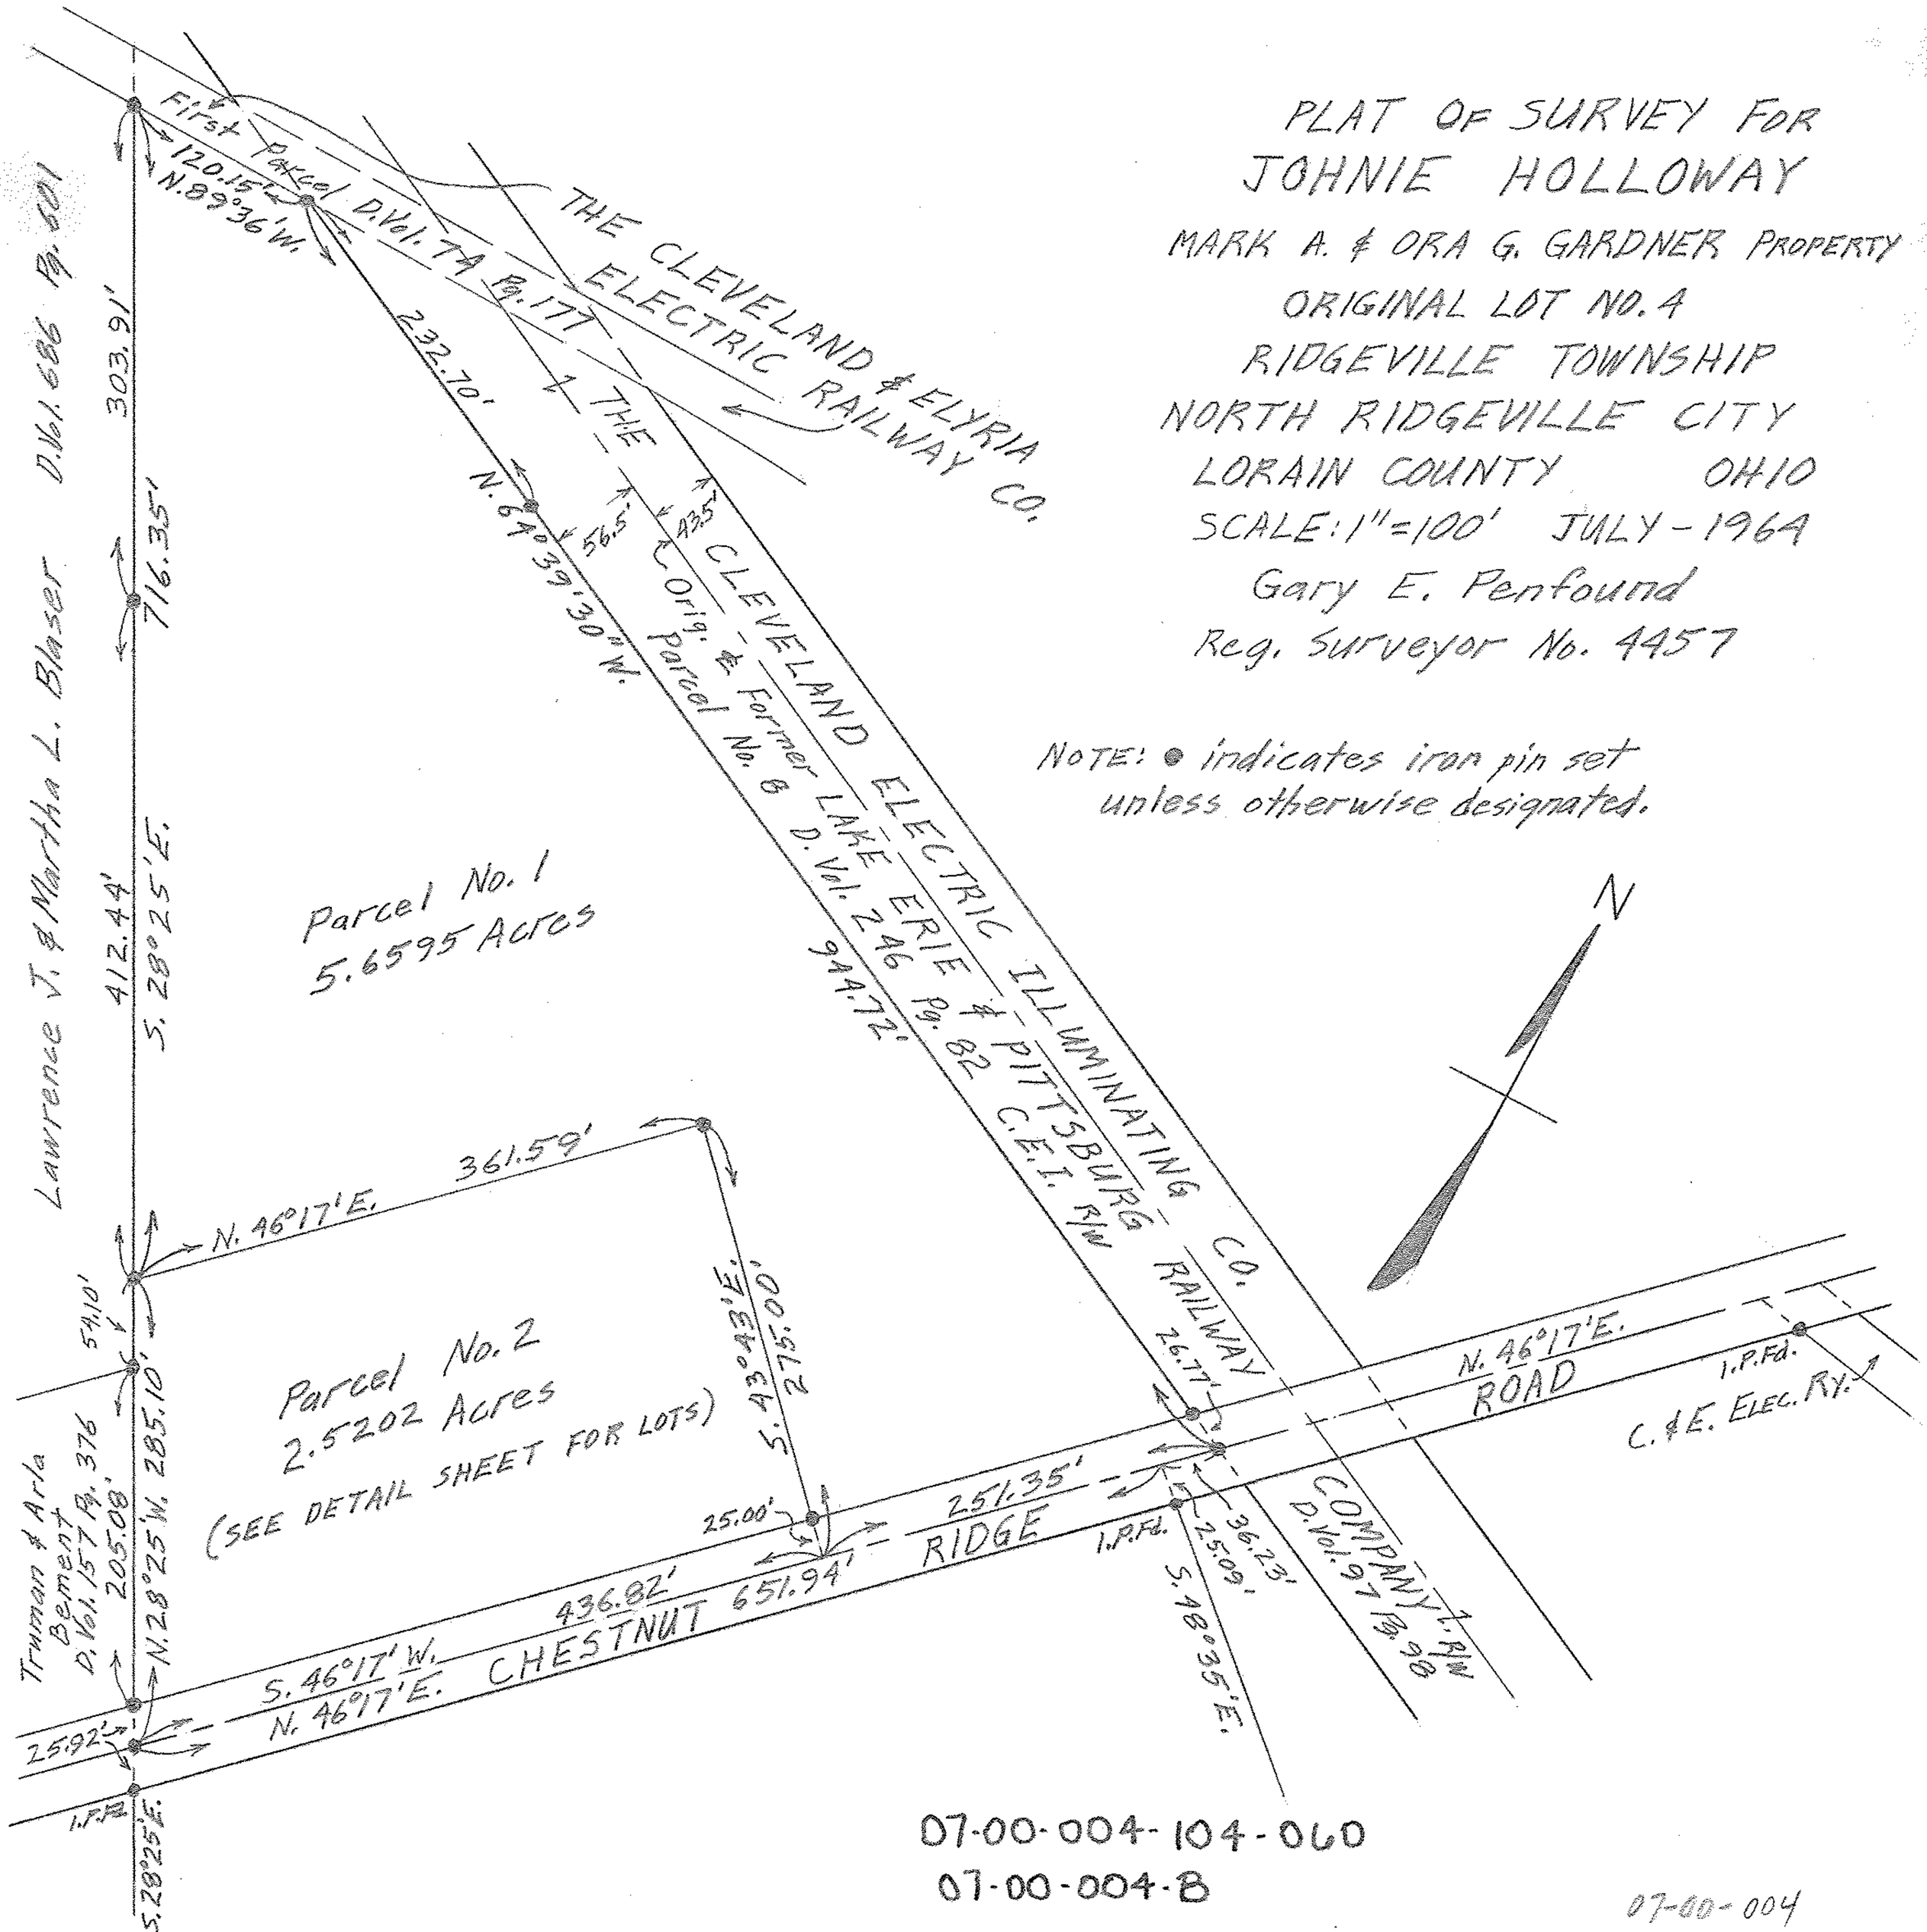
PLAT OF SURVEY FOR
JOHNIE HOLLOWAY
MARK A. & ORA G. GARDNER PROPERTY
ORIGINAL LOT NO. 4
RIDGEVILLE TOWNSHIP
NORTH RIDGEVILLE CITY
LORAIN COUNTY OHIO
SCALE: 1"=100' JULY-1964
Gary E. Penfound
Reg. Surveyor No. 4457
NOTE: ● indicates iron pin set unless otherwise designated.
N
THE CLEVELAND & ELYRIA ELECTRIC RAILWAY CO.
First Parcel D.Vol. 74 Pg. 177
120.15'
N.89°36'W.
232.70'
N.64°39'30"W.
56.5'
43.5'
THE CLEVELAND ELECTRIC ILLUMINATING CO.
Orig. & Former LAKE ERIE & PITTSBURG RAILWAY
Parcel No. 8 D. Vol. 246 Pg. 82 C.E.I. R/W
944.72'
Parcel No. 1
5.6595 Acres
Parcel No. 2
2.5202 Acres
(SEE DETAIL SHEET FOR LOTS)
Lawrence J. & Martha L. Blaser D.Vol. 686 Pg. 601
303.91'
716.35'
412.44'
S. 28°25'E.
361.59'
N. 46°17'E.
54.10'
Truman & Arla Bement D.Vol. 157 Pg. 376
205.08'
N.28°25'W. 285.10'
25.92'
I.P.Fd.
S.28°25'E.
S. 43°43'E.
275.00'
25.00'
436.82'
S. 46°17'W.
N. 46°17'E.
CHESTNUT
651.94'
251.35'
RIDGE
26.77'
I.P.Fd.
36.23'
25.09'
S. 48°35'E.
COMPANY L. R/W D.Vol. 97 Pg. 98
N. 46°17'E.
ROAD
I.P.Fd.
C. & E. ELEC. RY.
07-00-004-104-060
07-00-004-B
07-00-004