10-00-001-102-093
10-00-001-C

PLAT OF SURVEY FOR ALEX NAGY

NORTH LINE OF FARM ACCORDING TO PHYSICAL EVIDENCE
IN SECTION NO. 1 OF CARLISLE TOWNSHIP
LORAIN COUNTY OHIO
SCALE: 1" = 100' MAY - 1982
Gary E. Penfound Reg. Surveyor No. 4957

NOTES: ▣ indicates iron pin found in monument box.
○ indicates other iron pin found.
● indicates iron pin set unless otherwise designated.

NOTE: All Fence found is 6 feet to 12 feet North of Subdivision line and its extension.

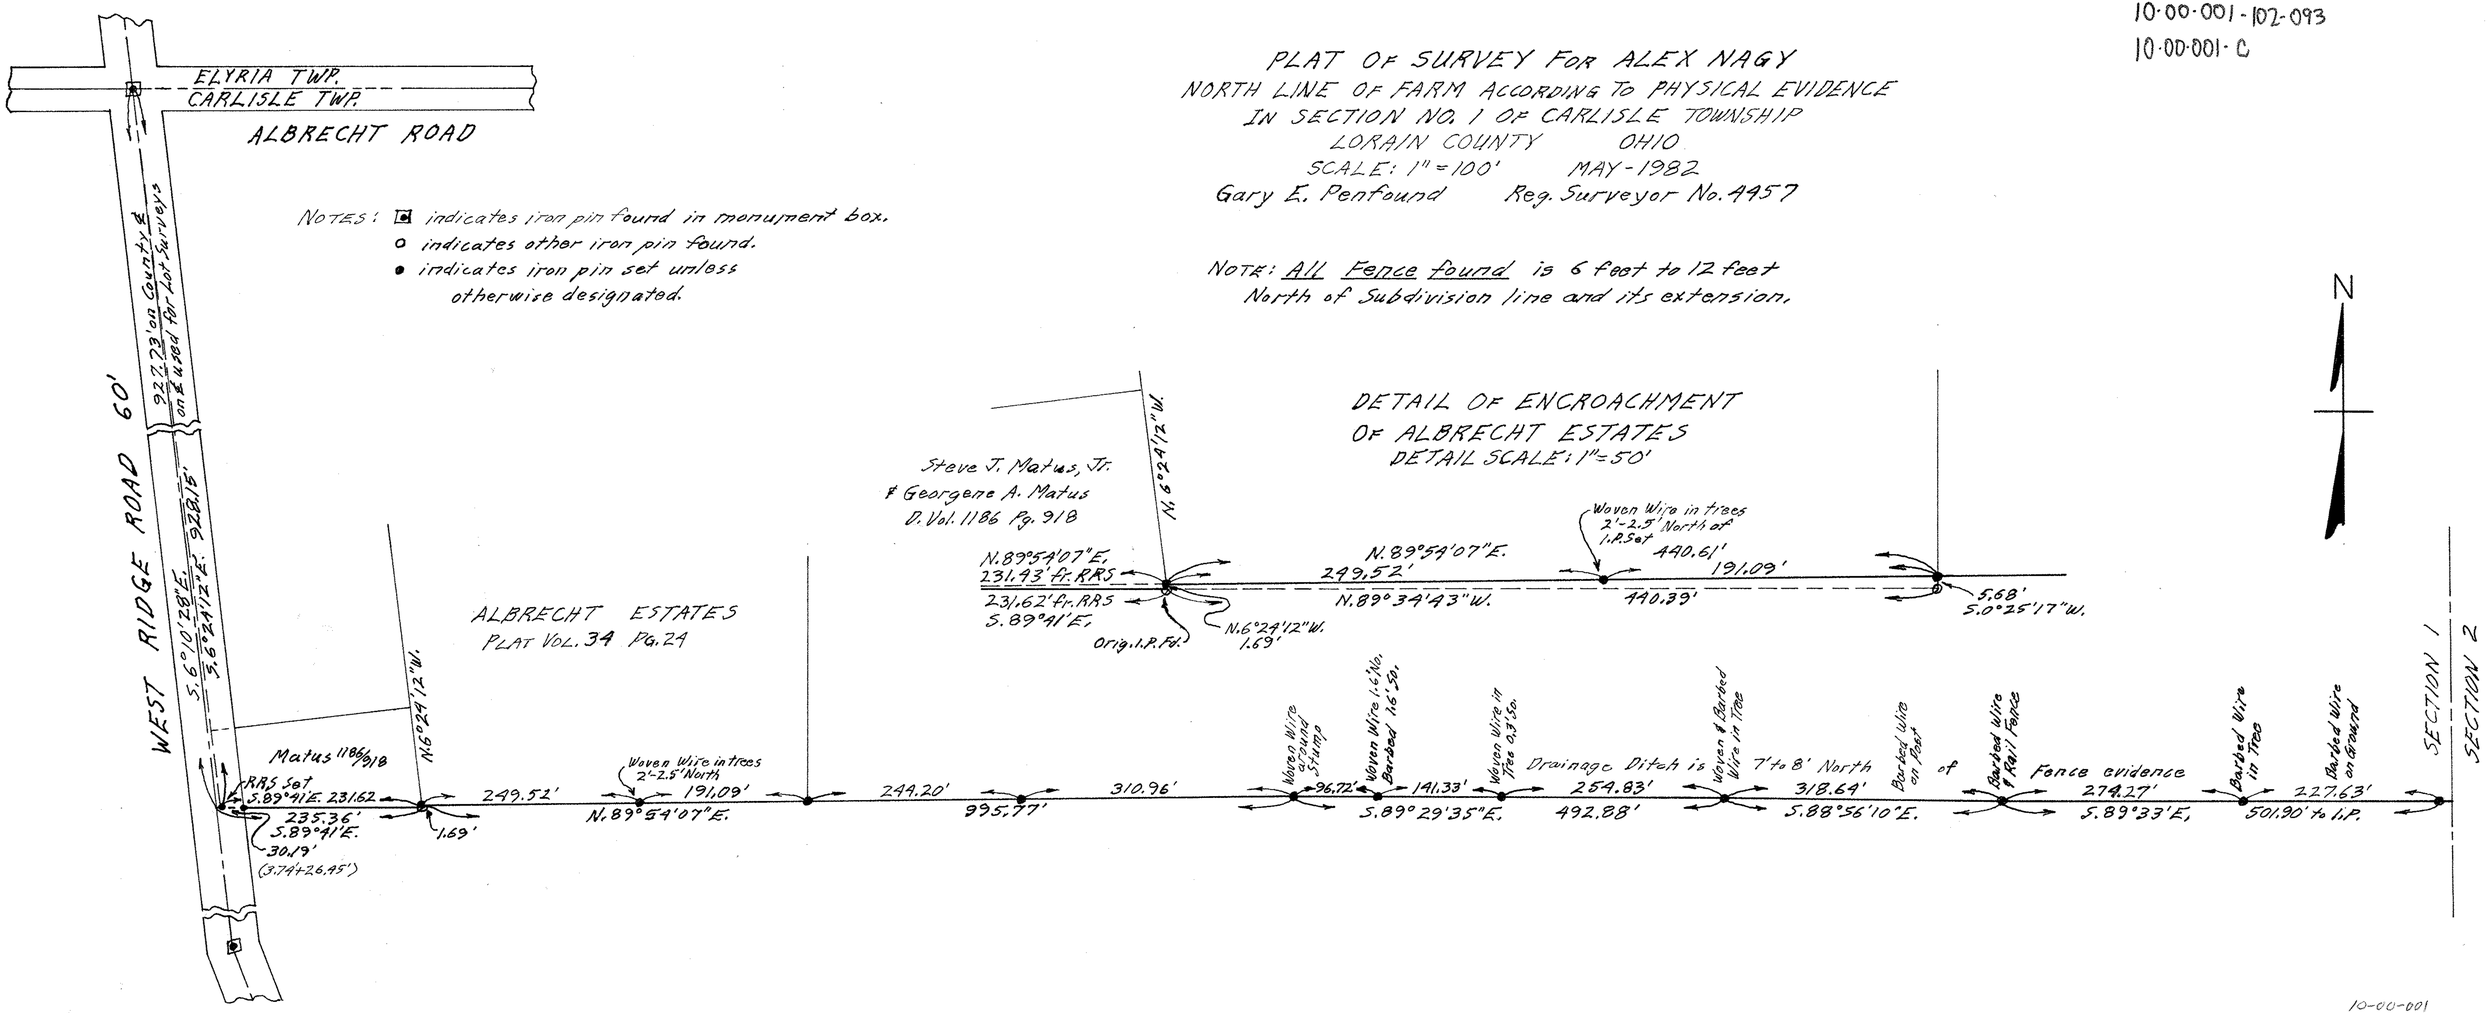

10-00-001