

NOTES: ○ indicates iron pin found.
 ● indicates iron pin set.
 + indicates reference cross cut.
 X indicates cross cut in concrete on property corner.


Gary E. Penfound Reg. Surveyor No. 4457



Southeasterly Line of CLEVELAND ST. 66' R/W

YORKSHIRE COURT 40' R/W

ABBE ROAD 66' R/W

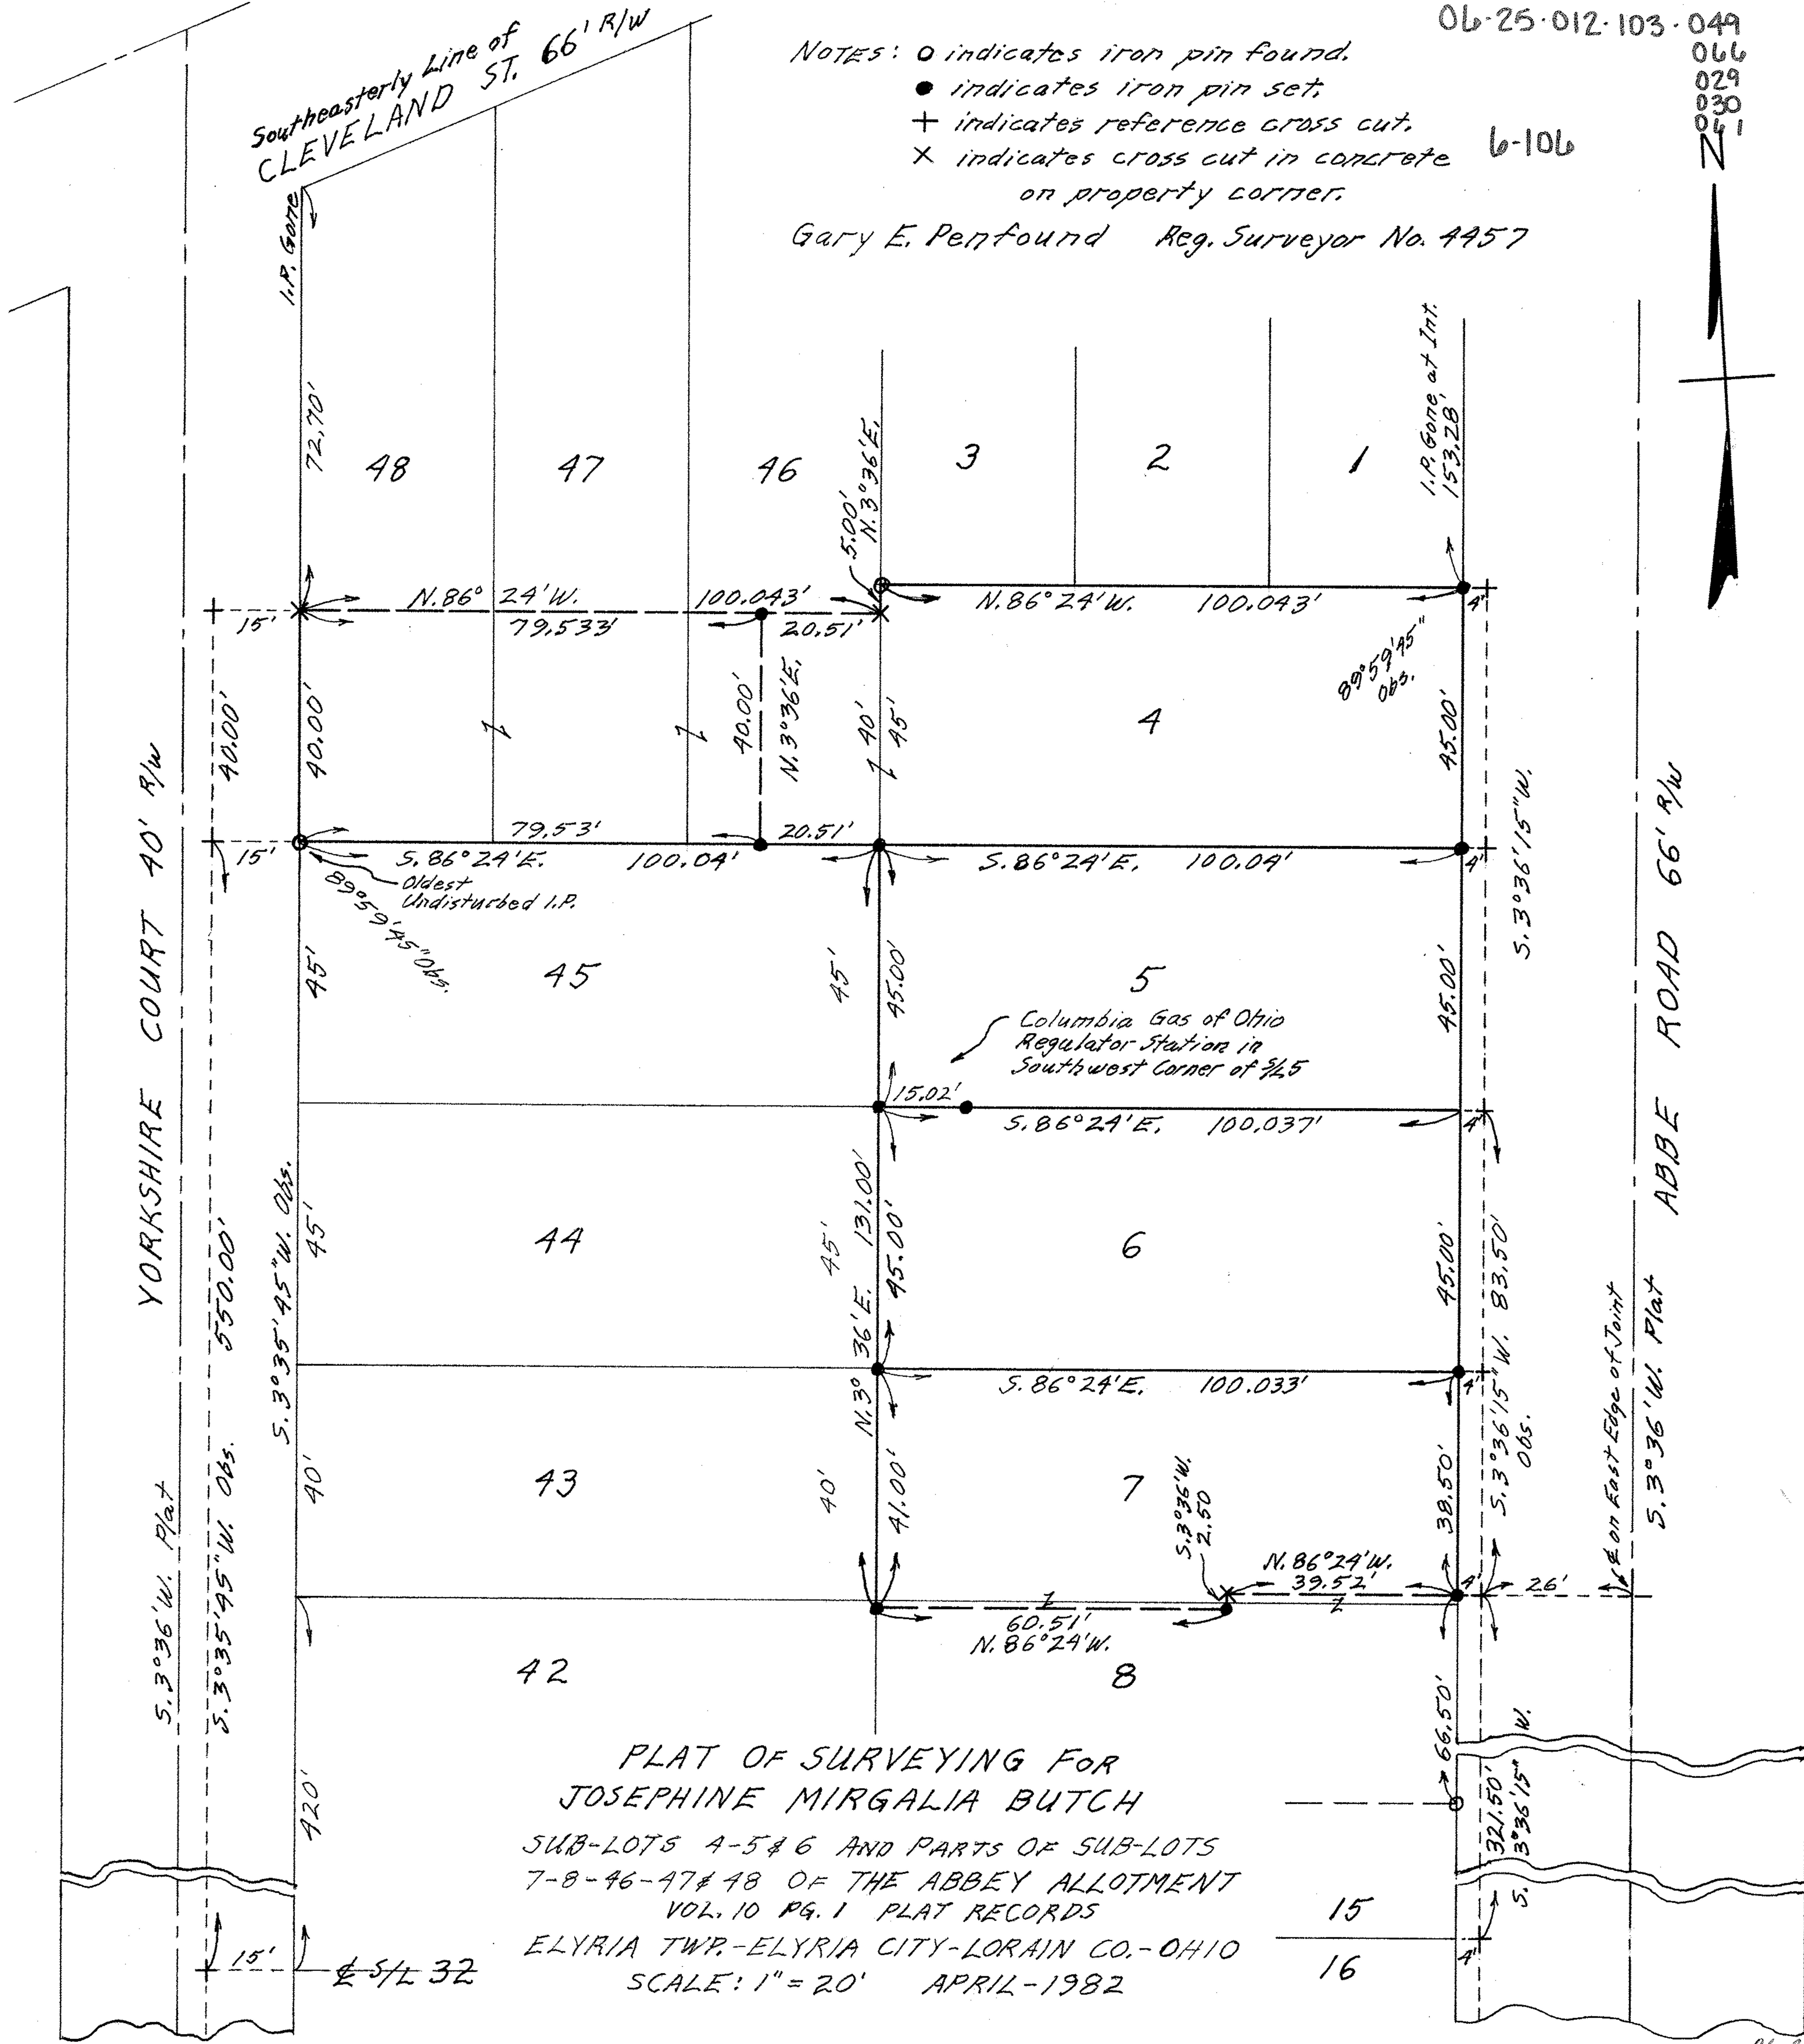

PLAT OF SURVEYING FOR
 JOSEPHINE MARGALIA BUTCH
 SUB-LOTS 4-5 & 6 AND PARTS OF SUB-LOTS
 7-8-46-47 & 48 OF THE ABBEY ALLOTMENT
 VOL. 10 PG. 1 PLAT RECORDS
 ELYRIA TWP.-ELYRIA CITY-LORAIN CO.-OHIO
 SCALE: 1" = 20' APRIL-1982

15' 1/2 S/L 32

15
16