


ROOSEVELT AVE 50'

OLIVE ST. 60'

CLEVELAND ST. 66'

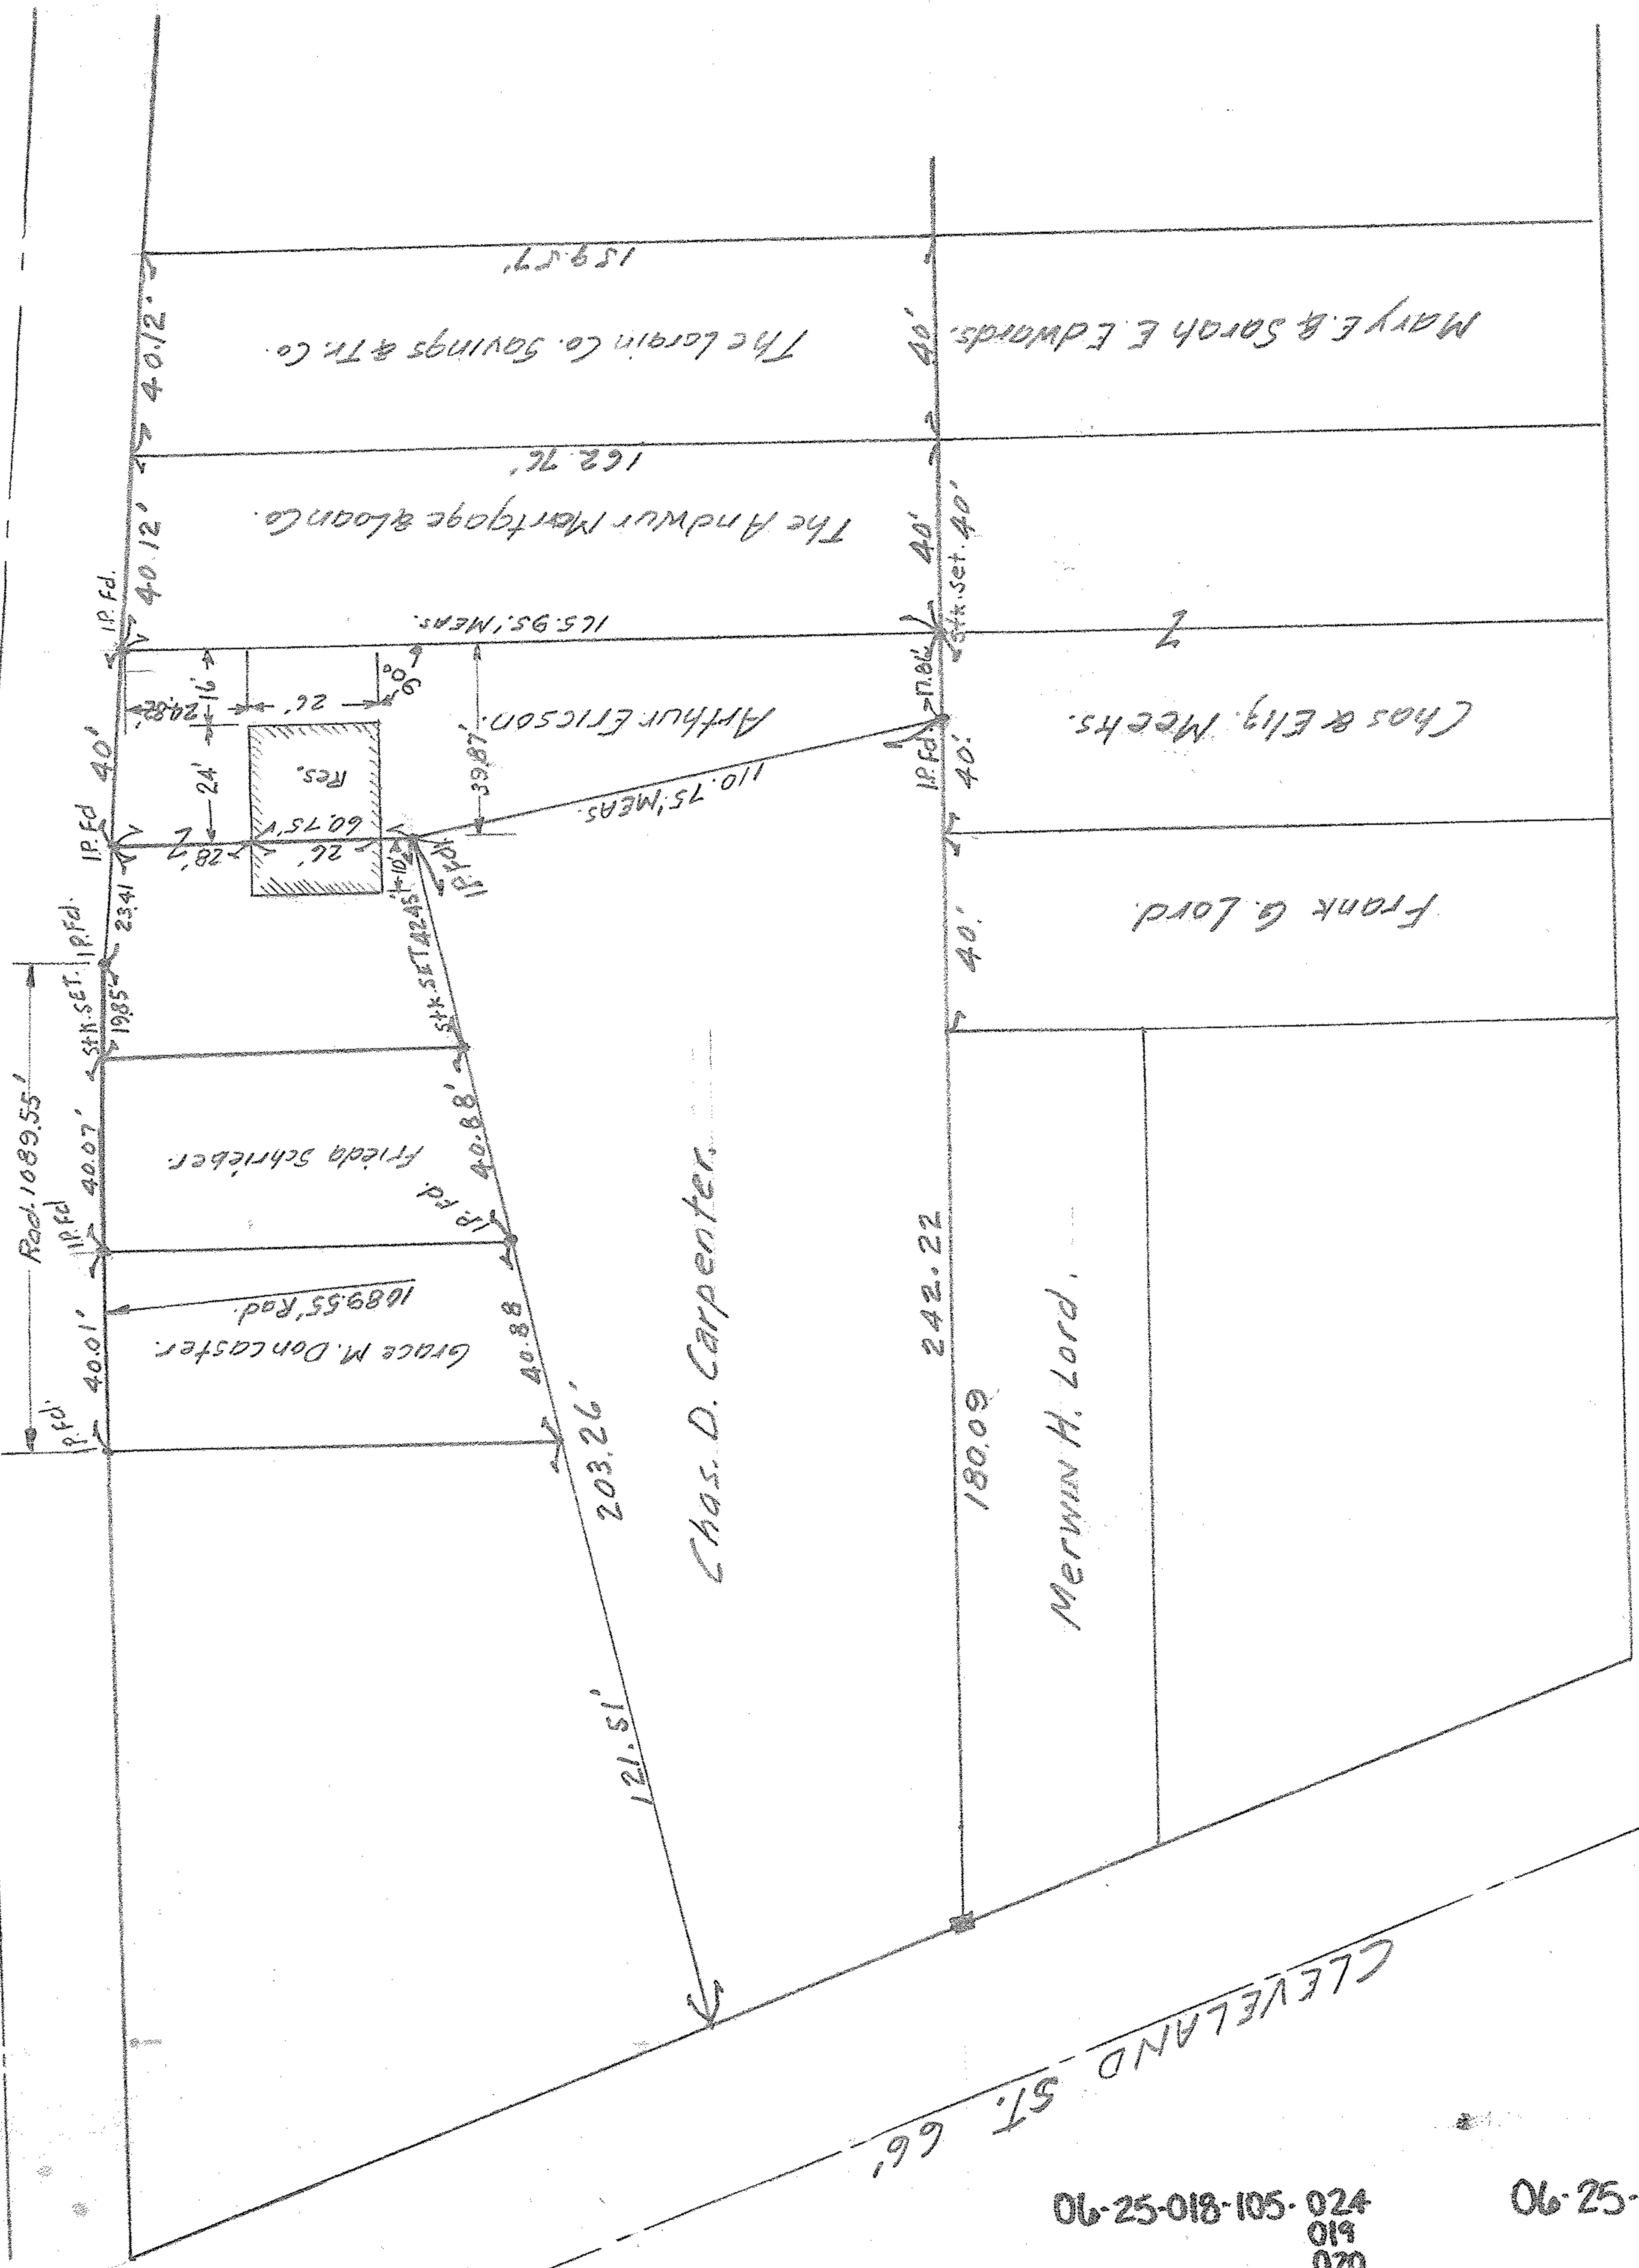

06-25-018-105-024  
 010  
 020  



