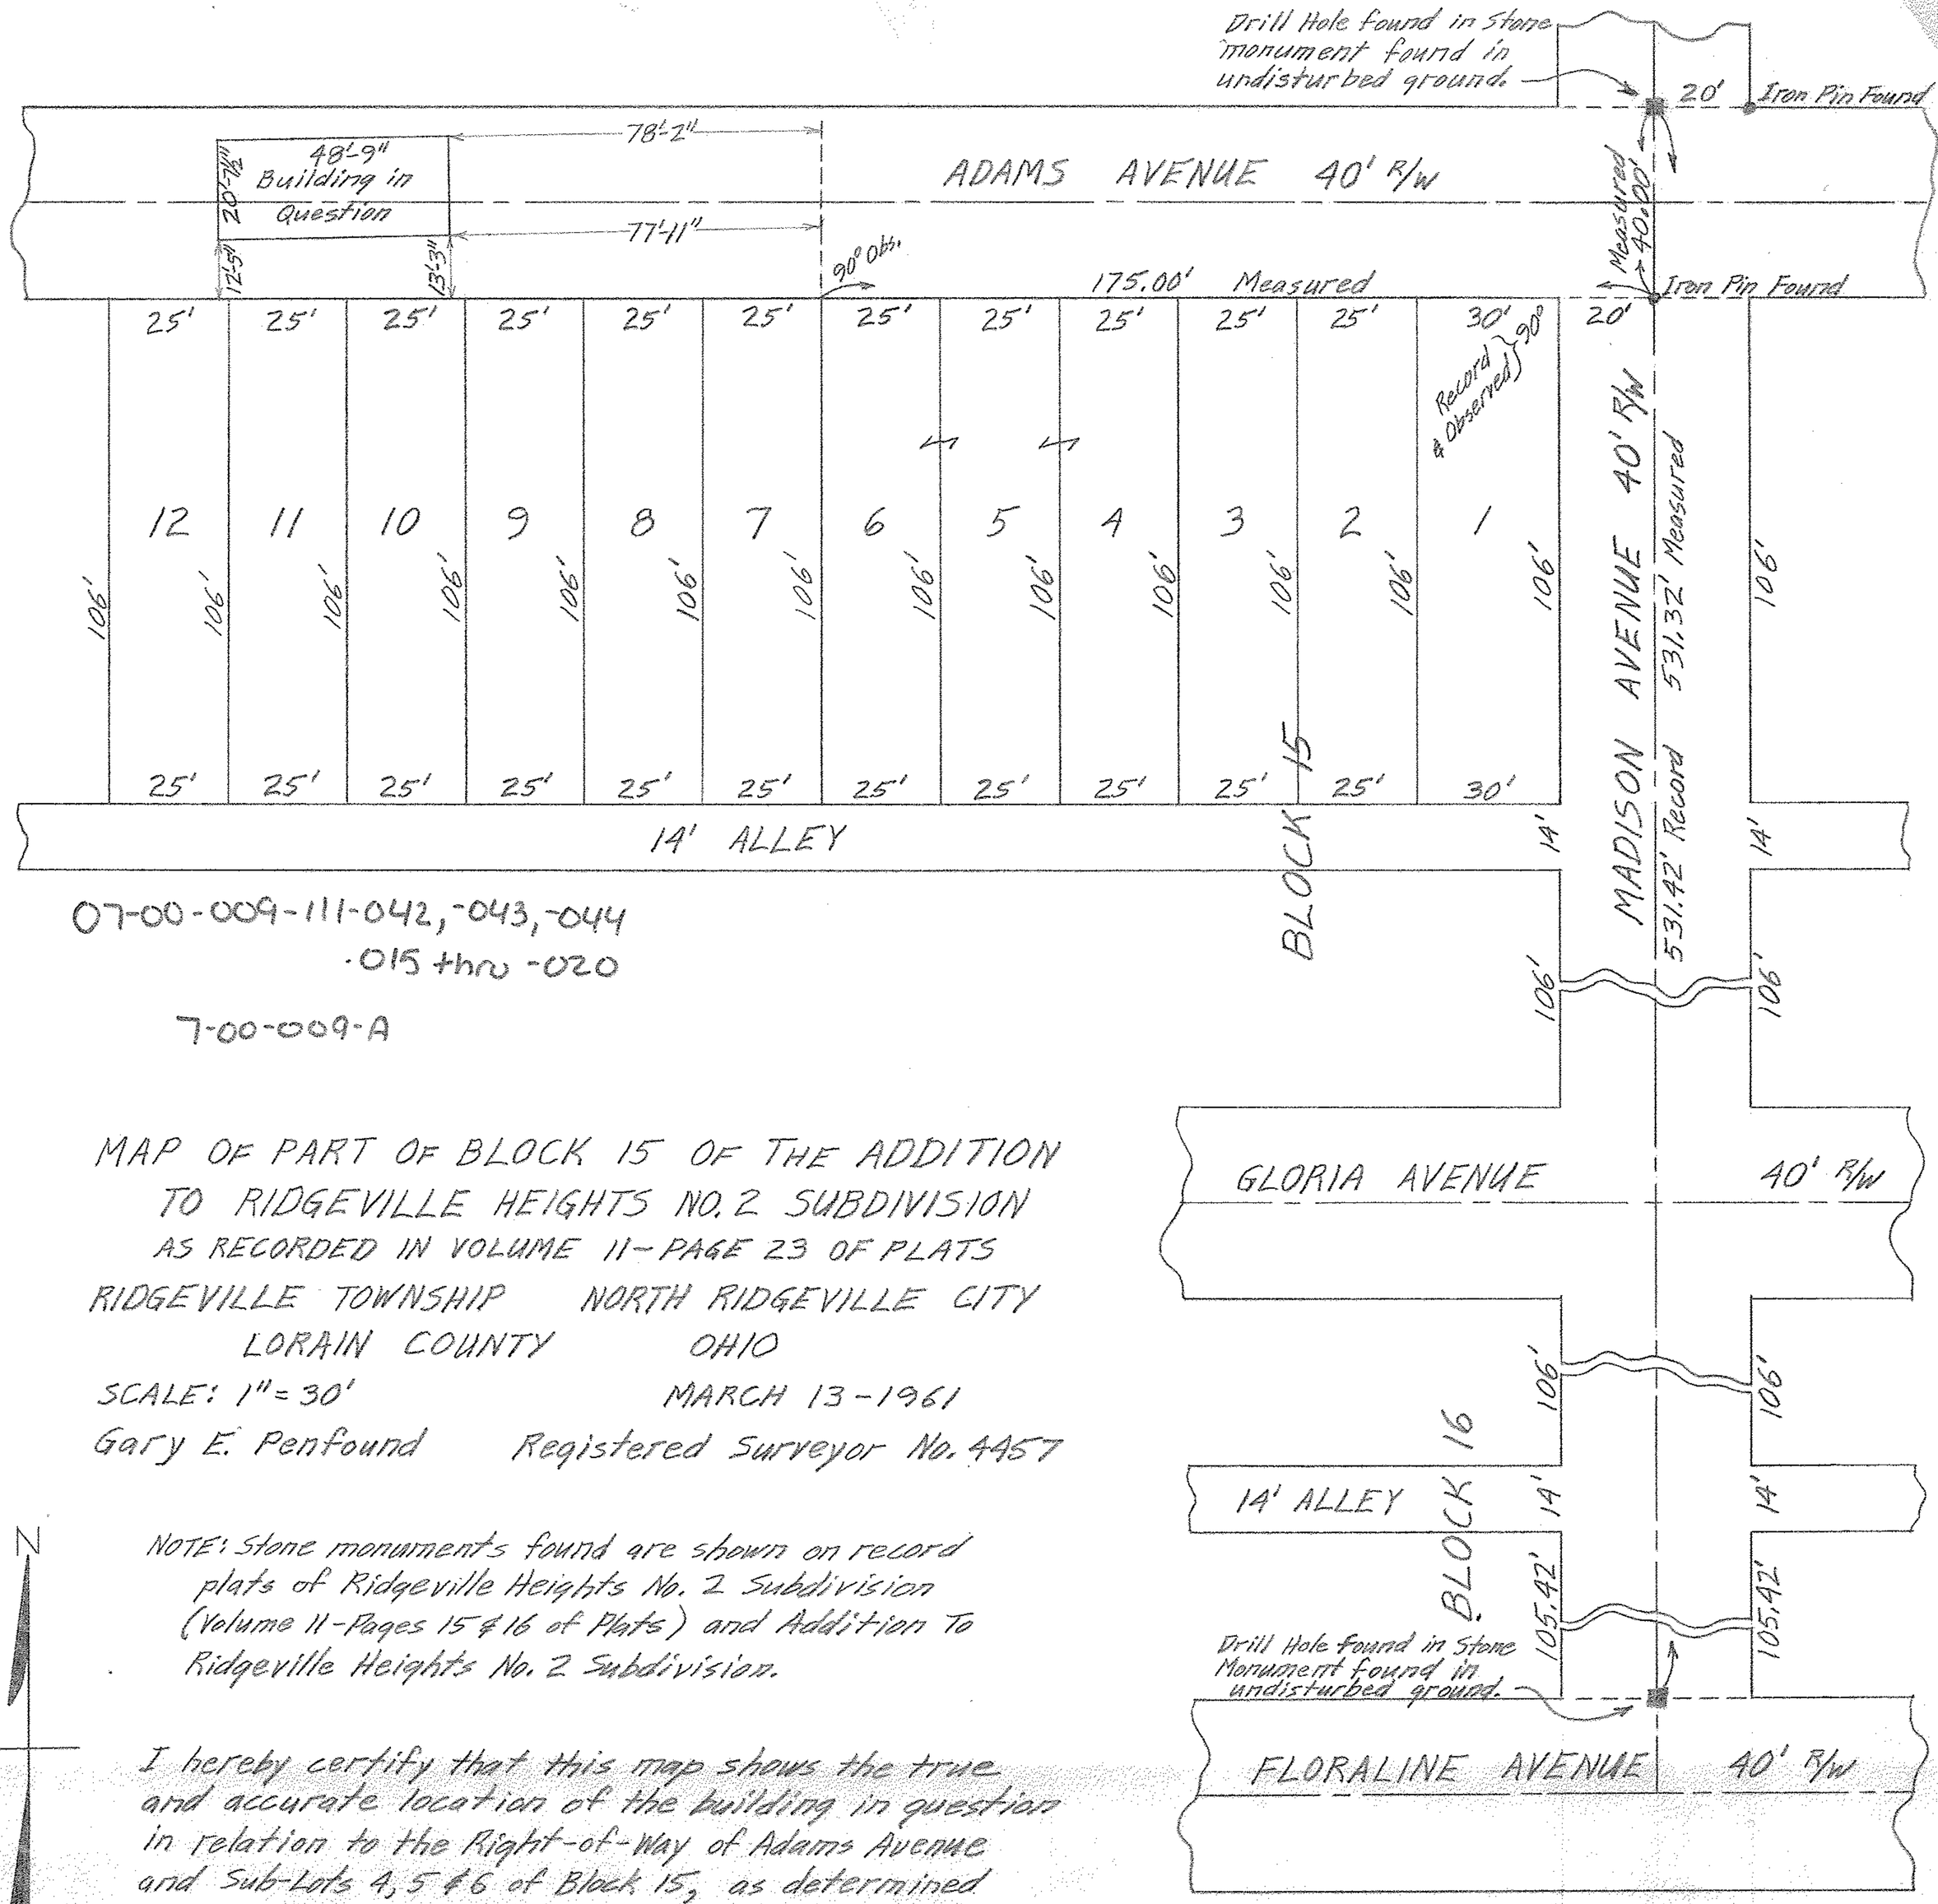

07-00-009-111-042, -043, -044
-015 thru -020

7-00-009-A

MAP OF PART OF BLOCK 15 OF THE ADDITION TO RIDGEVILLE HEIGHTS NO. 2 SUBDIVISION
AS RECORDED IN VOLUME 11 - PAGE 23 OF PLATS
RIDGEVILLE TOWNSHIP NORTH RIDGEVILLE CITY
LORAIN COUNTY OHIO
SCALE: 1" = 30' MARCH 13 - 1961
Gary E. Penfound Registered Surveyor No. 4457

N

NOTE: Stone monuments found are shown on record plats of Ridgeville Heights No. 2 Subdivision (Volume 11 - Pages 15 & 16 of Plats) and Addition To Ridgeville Heights No. 2 Subdivision.

I hereby certify that this map shows the true and accurate location of the building in question in relation to the Right-of-Way of Adams Avenue and Sub-Lots 4, 5 & 6 of Block 15, as determined by actual field survey.

07-00-009