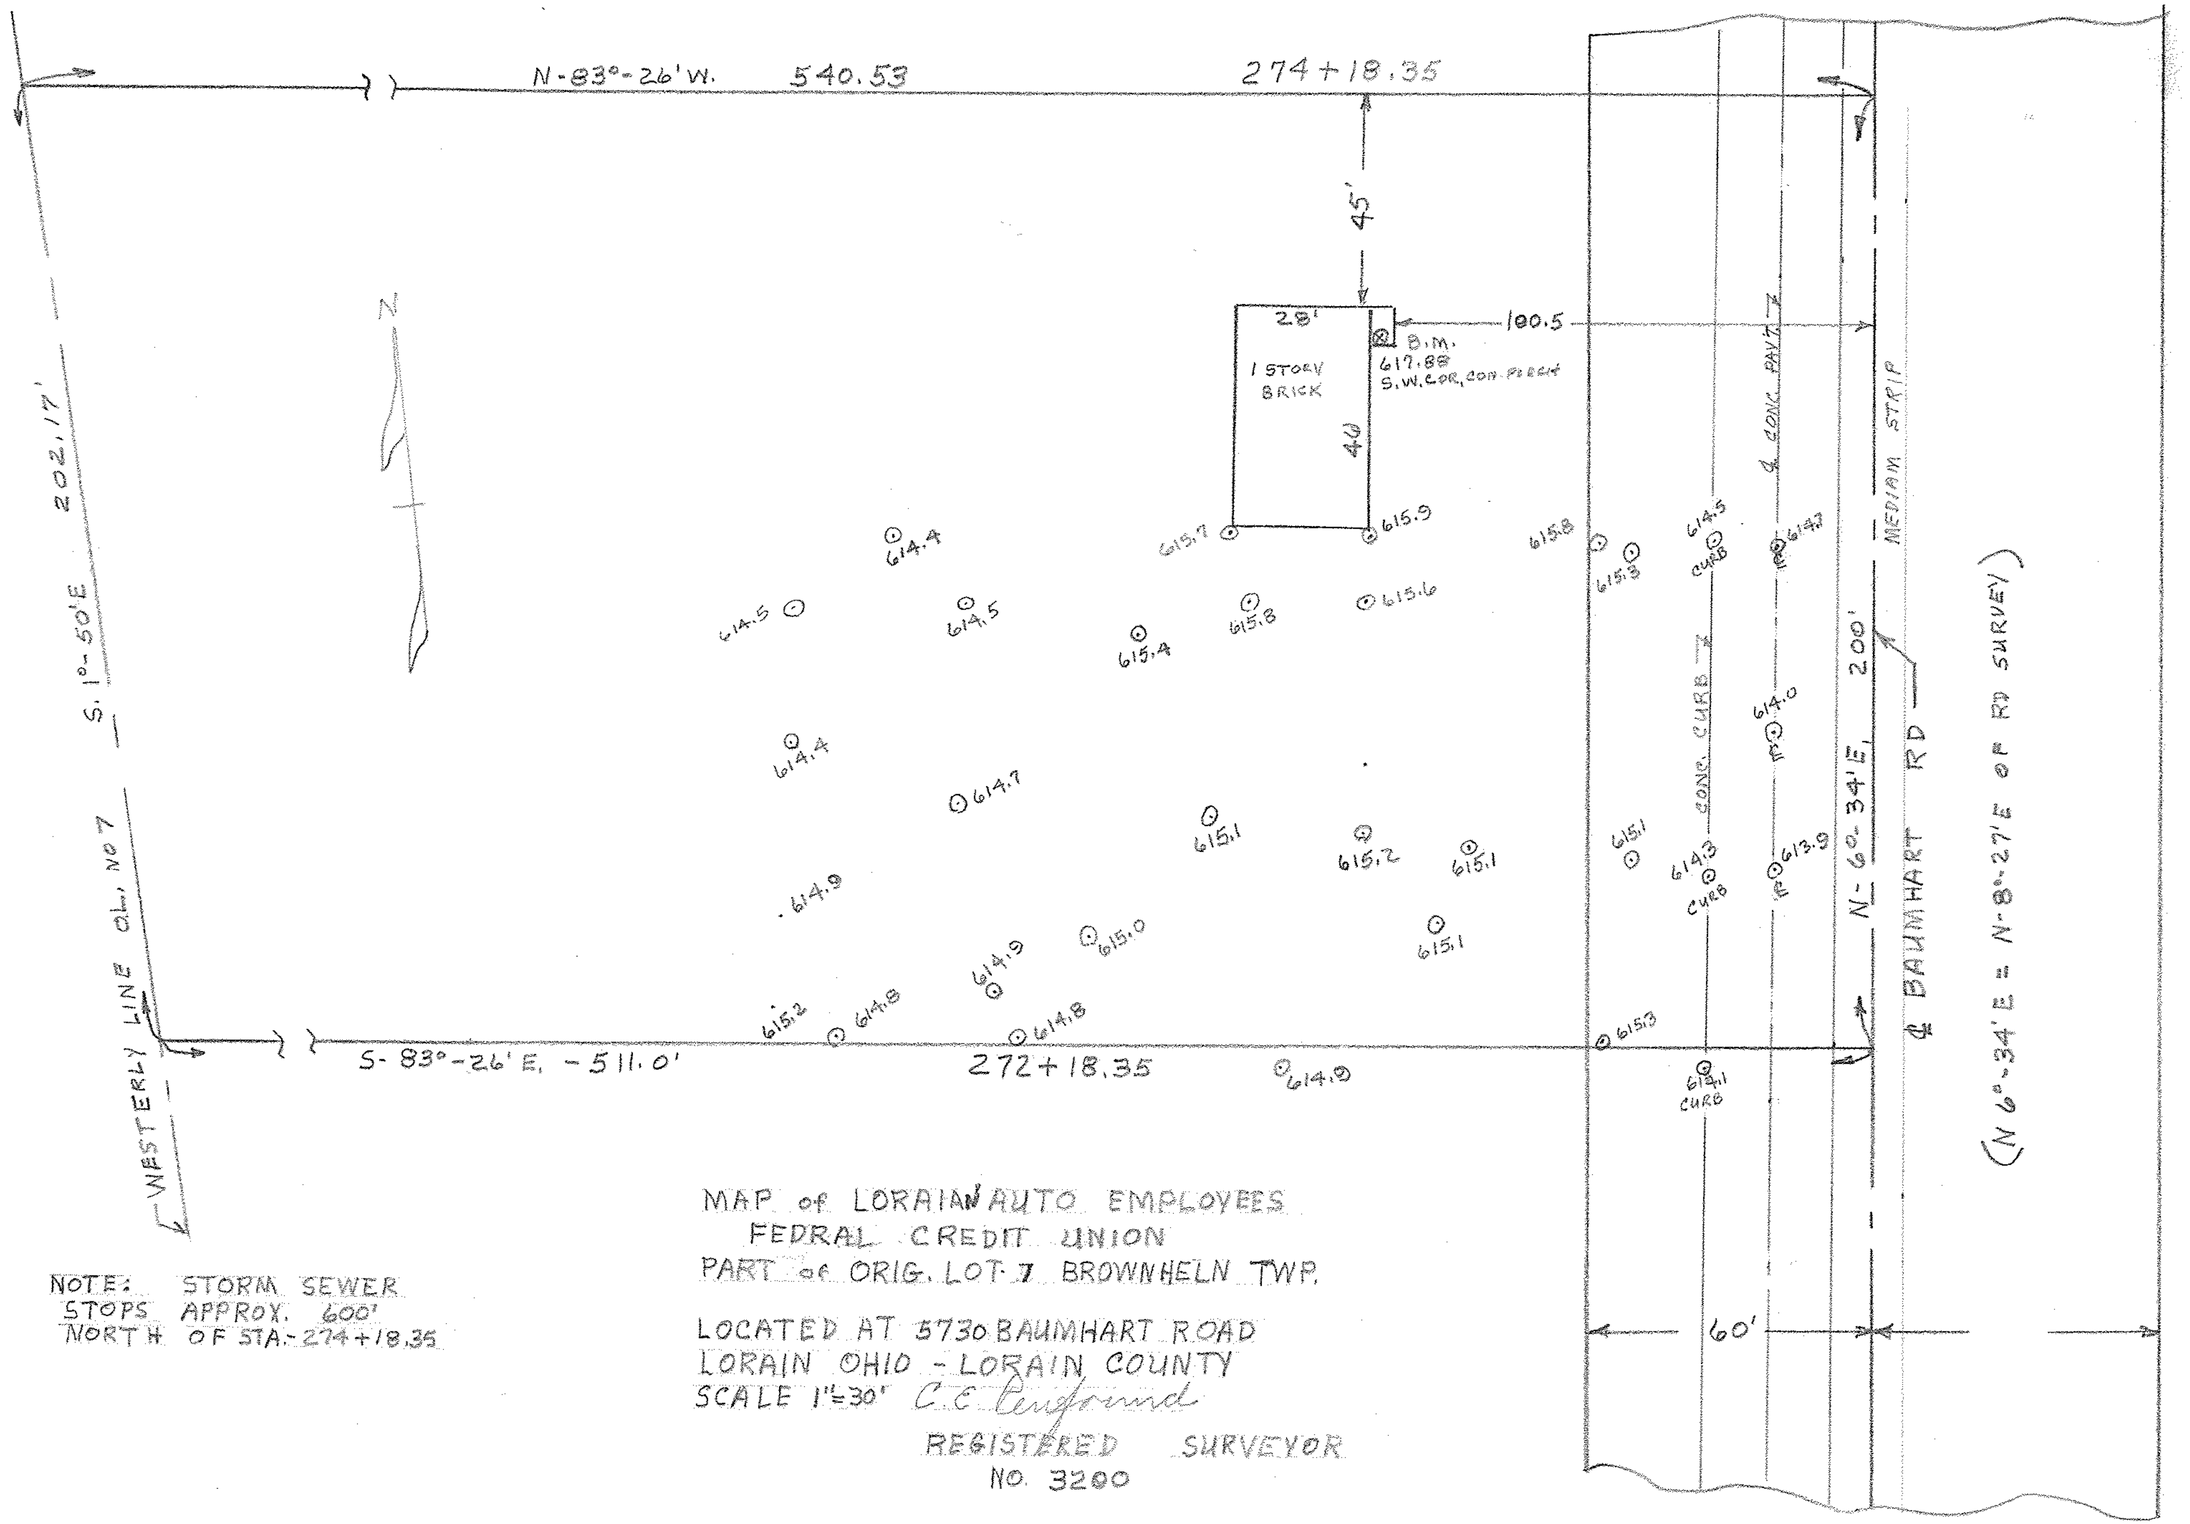

NOTE: STORM SEWER STOPS APPROX. 600' NORTH OF STA.-274+18.35

MAP of LORAIN AUTO EMPLOYEES
FEDRAL CREDIT UNION
PART of ORIG. LOT 7 BROWNHELN TWP.

LOCATED AT 5730 BAUMHART ROAD
LORAIN OHIO - LORAIN COUNTY
SCALE 1"=30' C.E. Penfound
REGISTERED SURVEYOR
NO. 3200

1-D
01-00-007-102-006

01-00-007-102-006