10-00-003-115-041 thru -046
-024, -025
-029 thru -038
-054

10-00-003-C

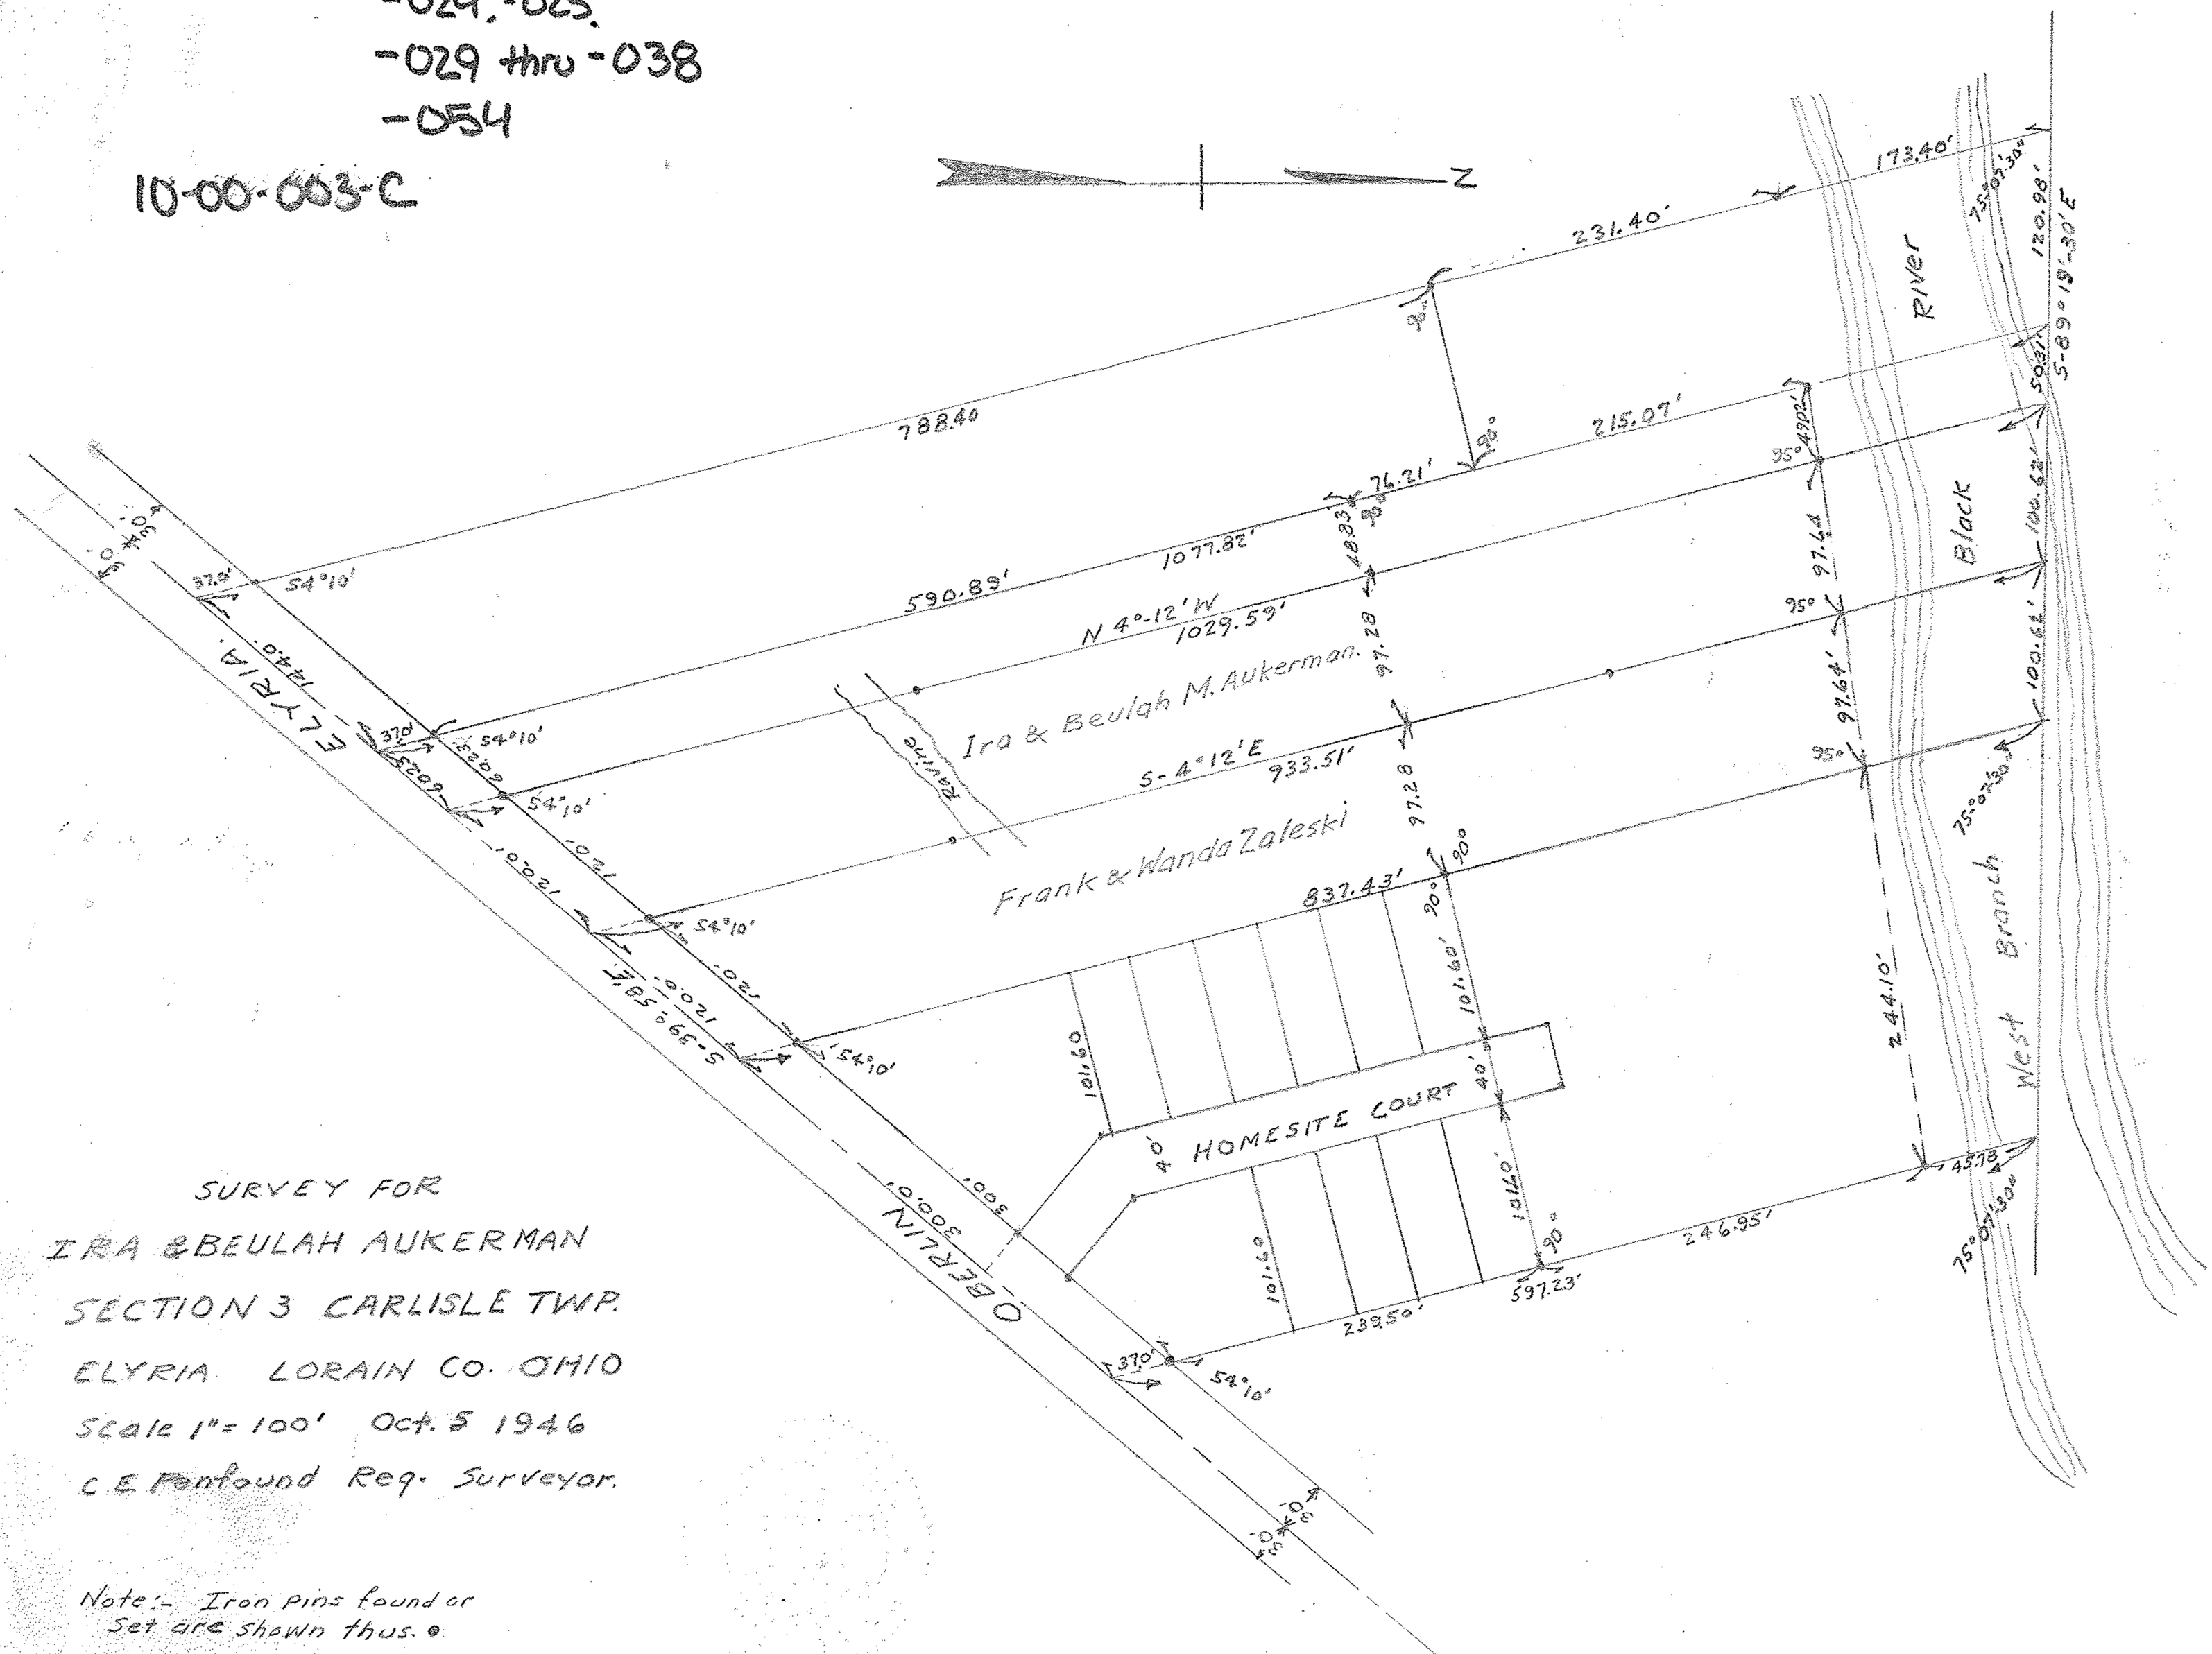

SURVEY FOR
IRA & BEULAH AUKERMAN
SECTION 3 CARLISLE TWP.
ELYRIA LORAIN CO. OHIO
Scale 1"= 100' Oct. 5 1946
C.E. Pontlound Reg. Surveyor.

Note:- Iron pins found or Set are shown thus. ●

10-00-003