ORIGINAL PARCEL 262x200 P.P. No. 04-00-025-000-122

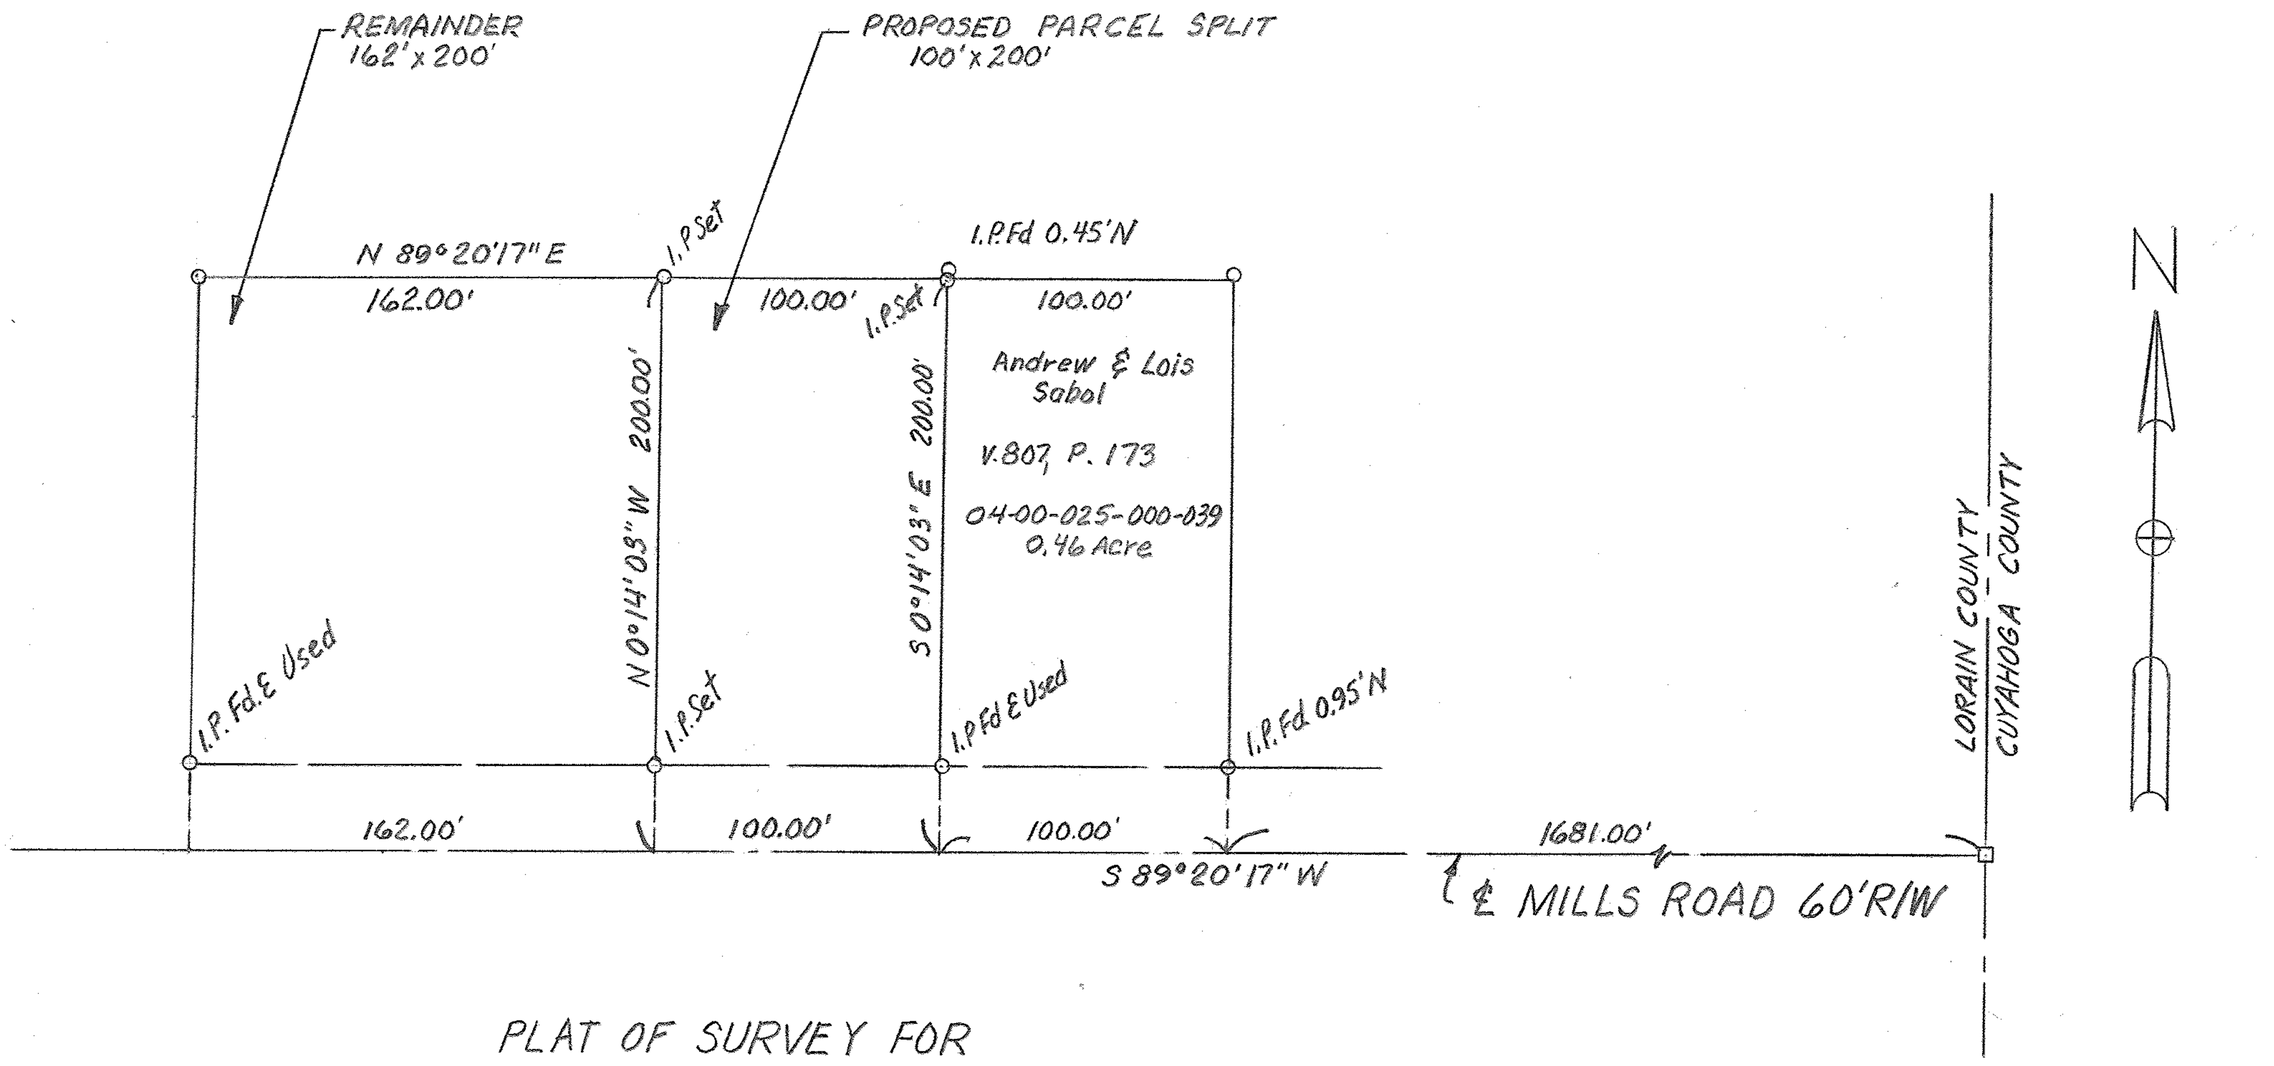

PLAT OF SURVEY FOR
RAYMOND & MARGARET PRICE

PART OF ORIGINAL AVON TOWNSHIP SECTION NO. 25

NOW IN CITY OF AVON, LORAIN COUNTY, OHIO

04-00-025-000-204 & -205
4-00-025-G

McGLINCHY AND ASSOCIATES
PROFESSIONAL ENGINEERS AND SURVEYORS
625 North Woodhill Drive Amherst, Ohio

SCALE: 1" = 50' DRAWN BY: L.V. McGlinchy
DATE: 7/3/91 JOB NO: 91881G