# PLAT OF SURVEYS FOR
# EMERY J. HORVATH

ORIGINAL LOT 90 - LAGRANGE TWP.
LORAIN COUNTY - OHIO
SCALE: 1" = 100' JANUARY - 1980
Gary E. Penfound - Reg. Surveyor No. 4457

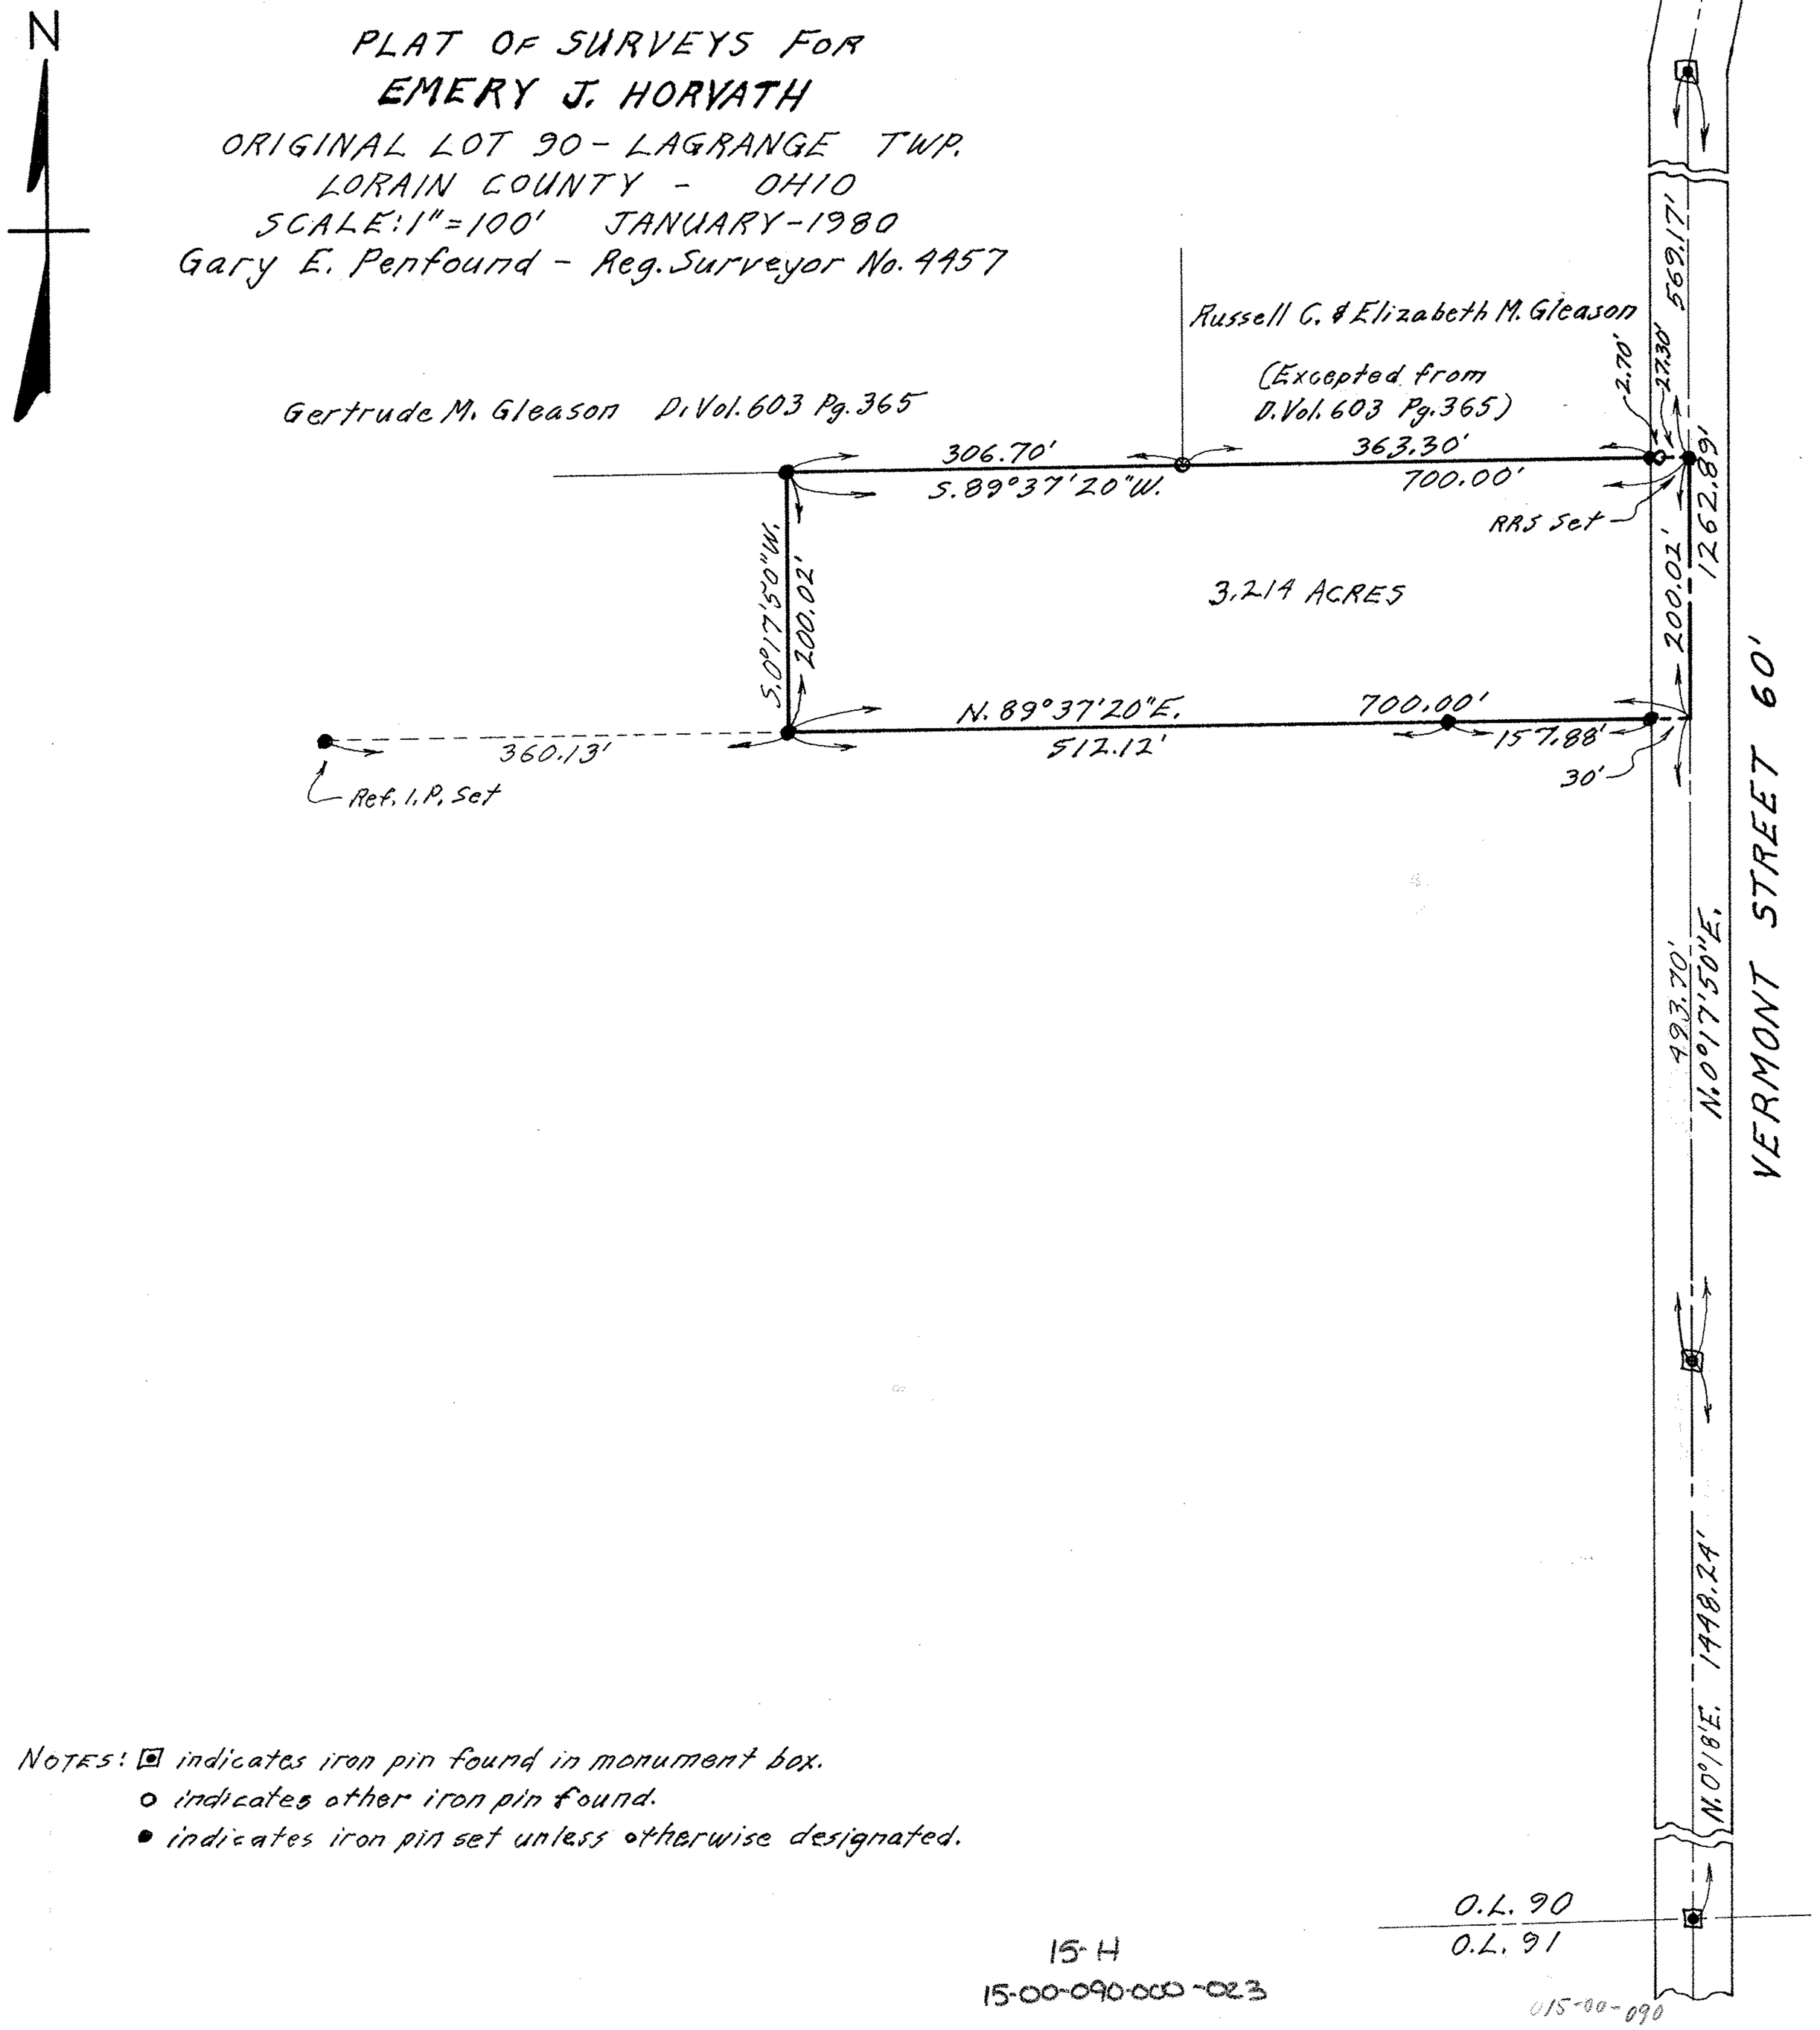


NOTES: ⊡ indicates iron pin found in monument box.
o indicates other iron pin found.
• indicates iron pin set unless otherwise designated.

O.L. 90
O.L. 91

15-H
15-00-090.000-023

015-00-090