

Stone Mon
N Line Erie
St. Fd. & Used

See Letter

Stone Mon Fd
& Used

S 88° 38' 20" W 482.60'

O.L. 42 O.L. 59
O.L. 43 O.L. 58

S 88° 55' 00" W 270.01'

PARCEL "A"
1.706 Acres

PARCEL "C"
1.967 Acres

Norberto R. & Annie J. Marfori
Volume 1248, Page 80
Transferred 10-23-79
P.P. No. 05-00-058-000-215
1.52 Acres

S.L. 301
Hidden
Valley
Subd No. 6
Vol. 34, Pg. 53

N 89° 11' E 499.32'

153.67'
N 0° 32' 54" W 302.75'

N 1° 14' 00" E 275.00'

PARCEL "B"
1.737 Acres

516.06
- 25.15
490.91

S 88° 54' 20" W 189.21'

S.L. 302
Hidden Valley Subd No. 6
Volume 34, Pages 53 & 54

S 5° 31' 30" W 300.00'
150.00'

N 89° 11' E 955.34'

259.70 439.28'


179.58'

DEWEY ROAD 50' R/W
330' ±

O.L. 43
O.L. 58

552.94' ±

N 15° 24' 20" E

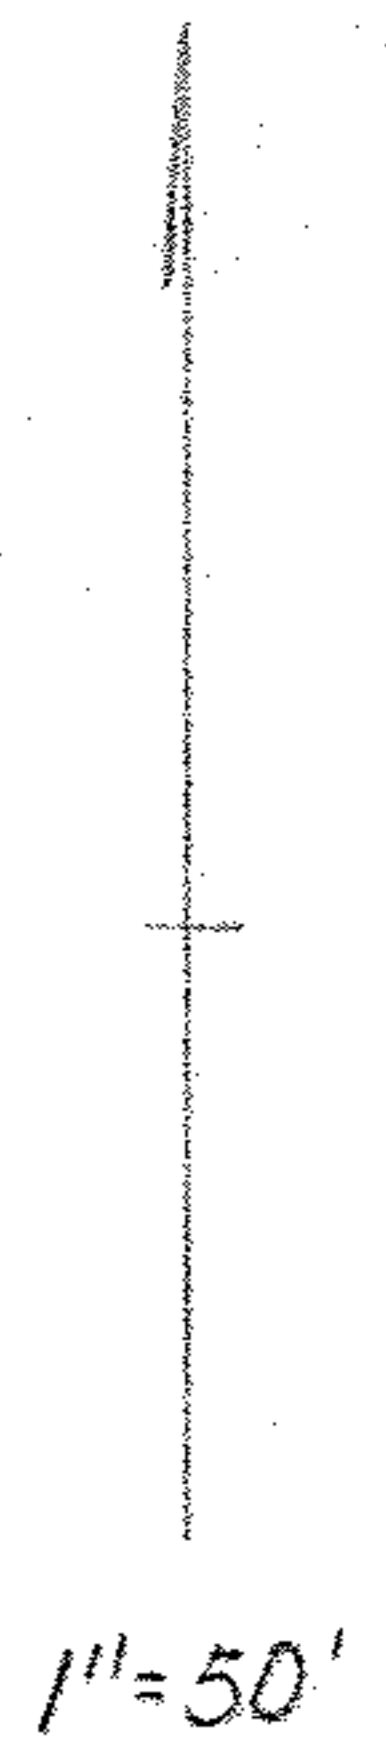

LEGEND


- Iron Pipe Found & Used
- Iron Pipe Set
- Stone Monument Found and Used

Parcel "A" 1.706 Acres
Parcel "B" 1.737 Acres
Parcel "C" 1.967 Acres

Total 5.410 Acres

PLAT OF SURVEY
FOR
RICHARD & NANETTE CORNISH
O.L. 43 & 58 AMHERST TOWNSHIP
LORAIN COUNTY, OHIO

McGLINCHY & ASSOCIATES
Professional Engineer & Surveyor
Amherst, Ohio July 4, 1990
Job No. 908798

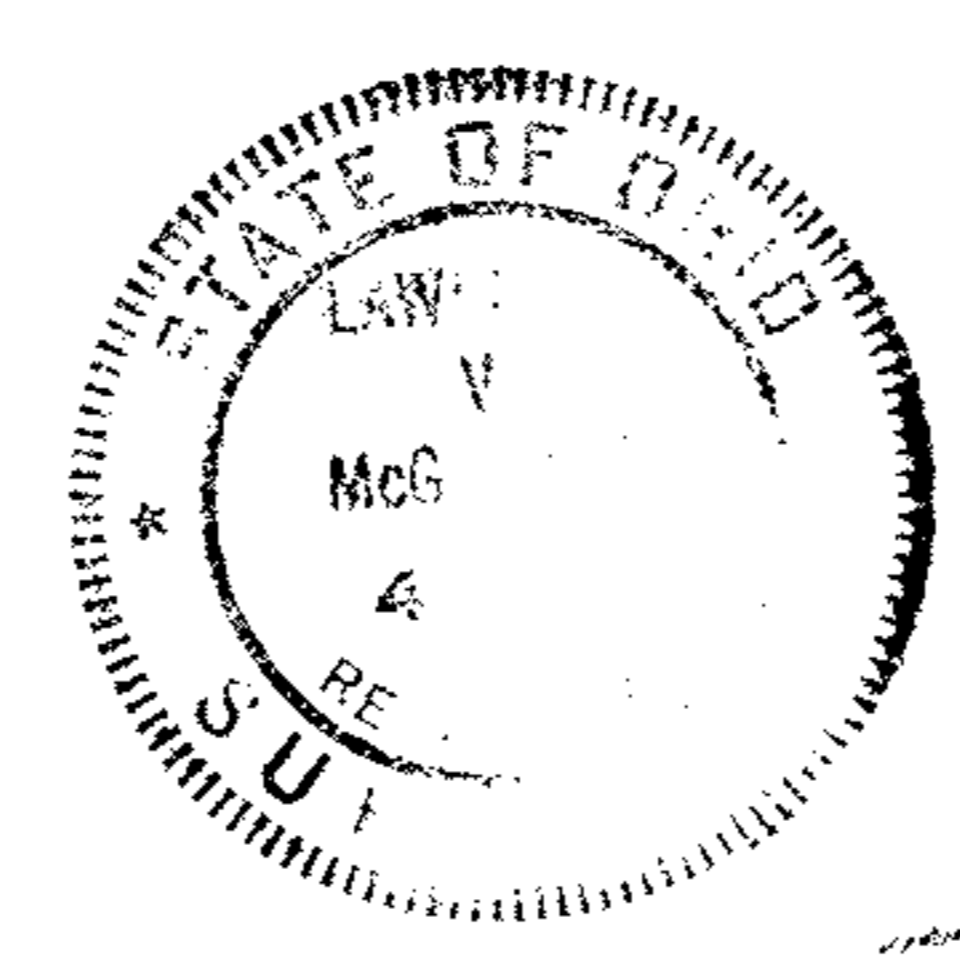

05-00-043-108-020 4-021 5-00-043-B
05-00-058-000-345 5-00-058-A