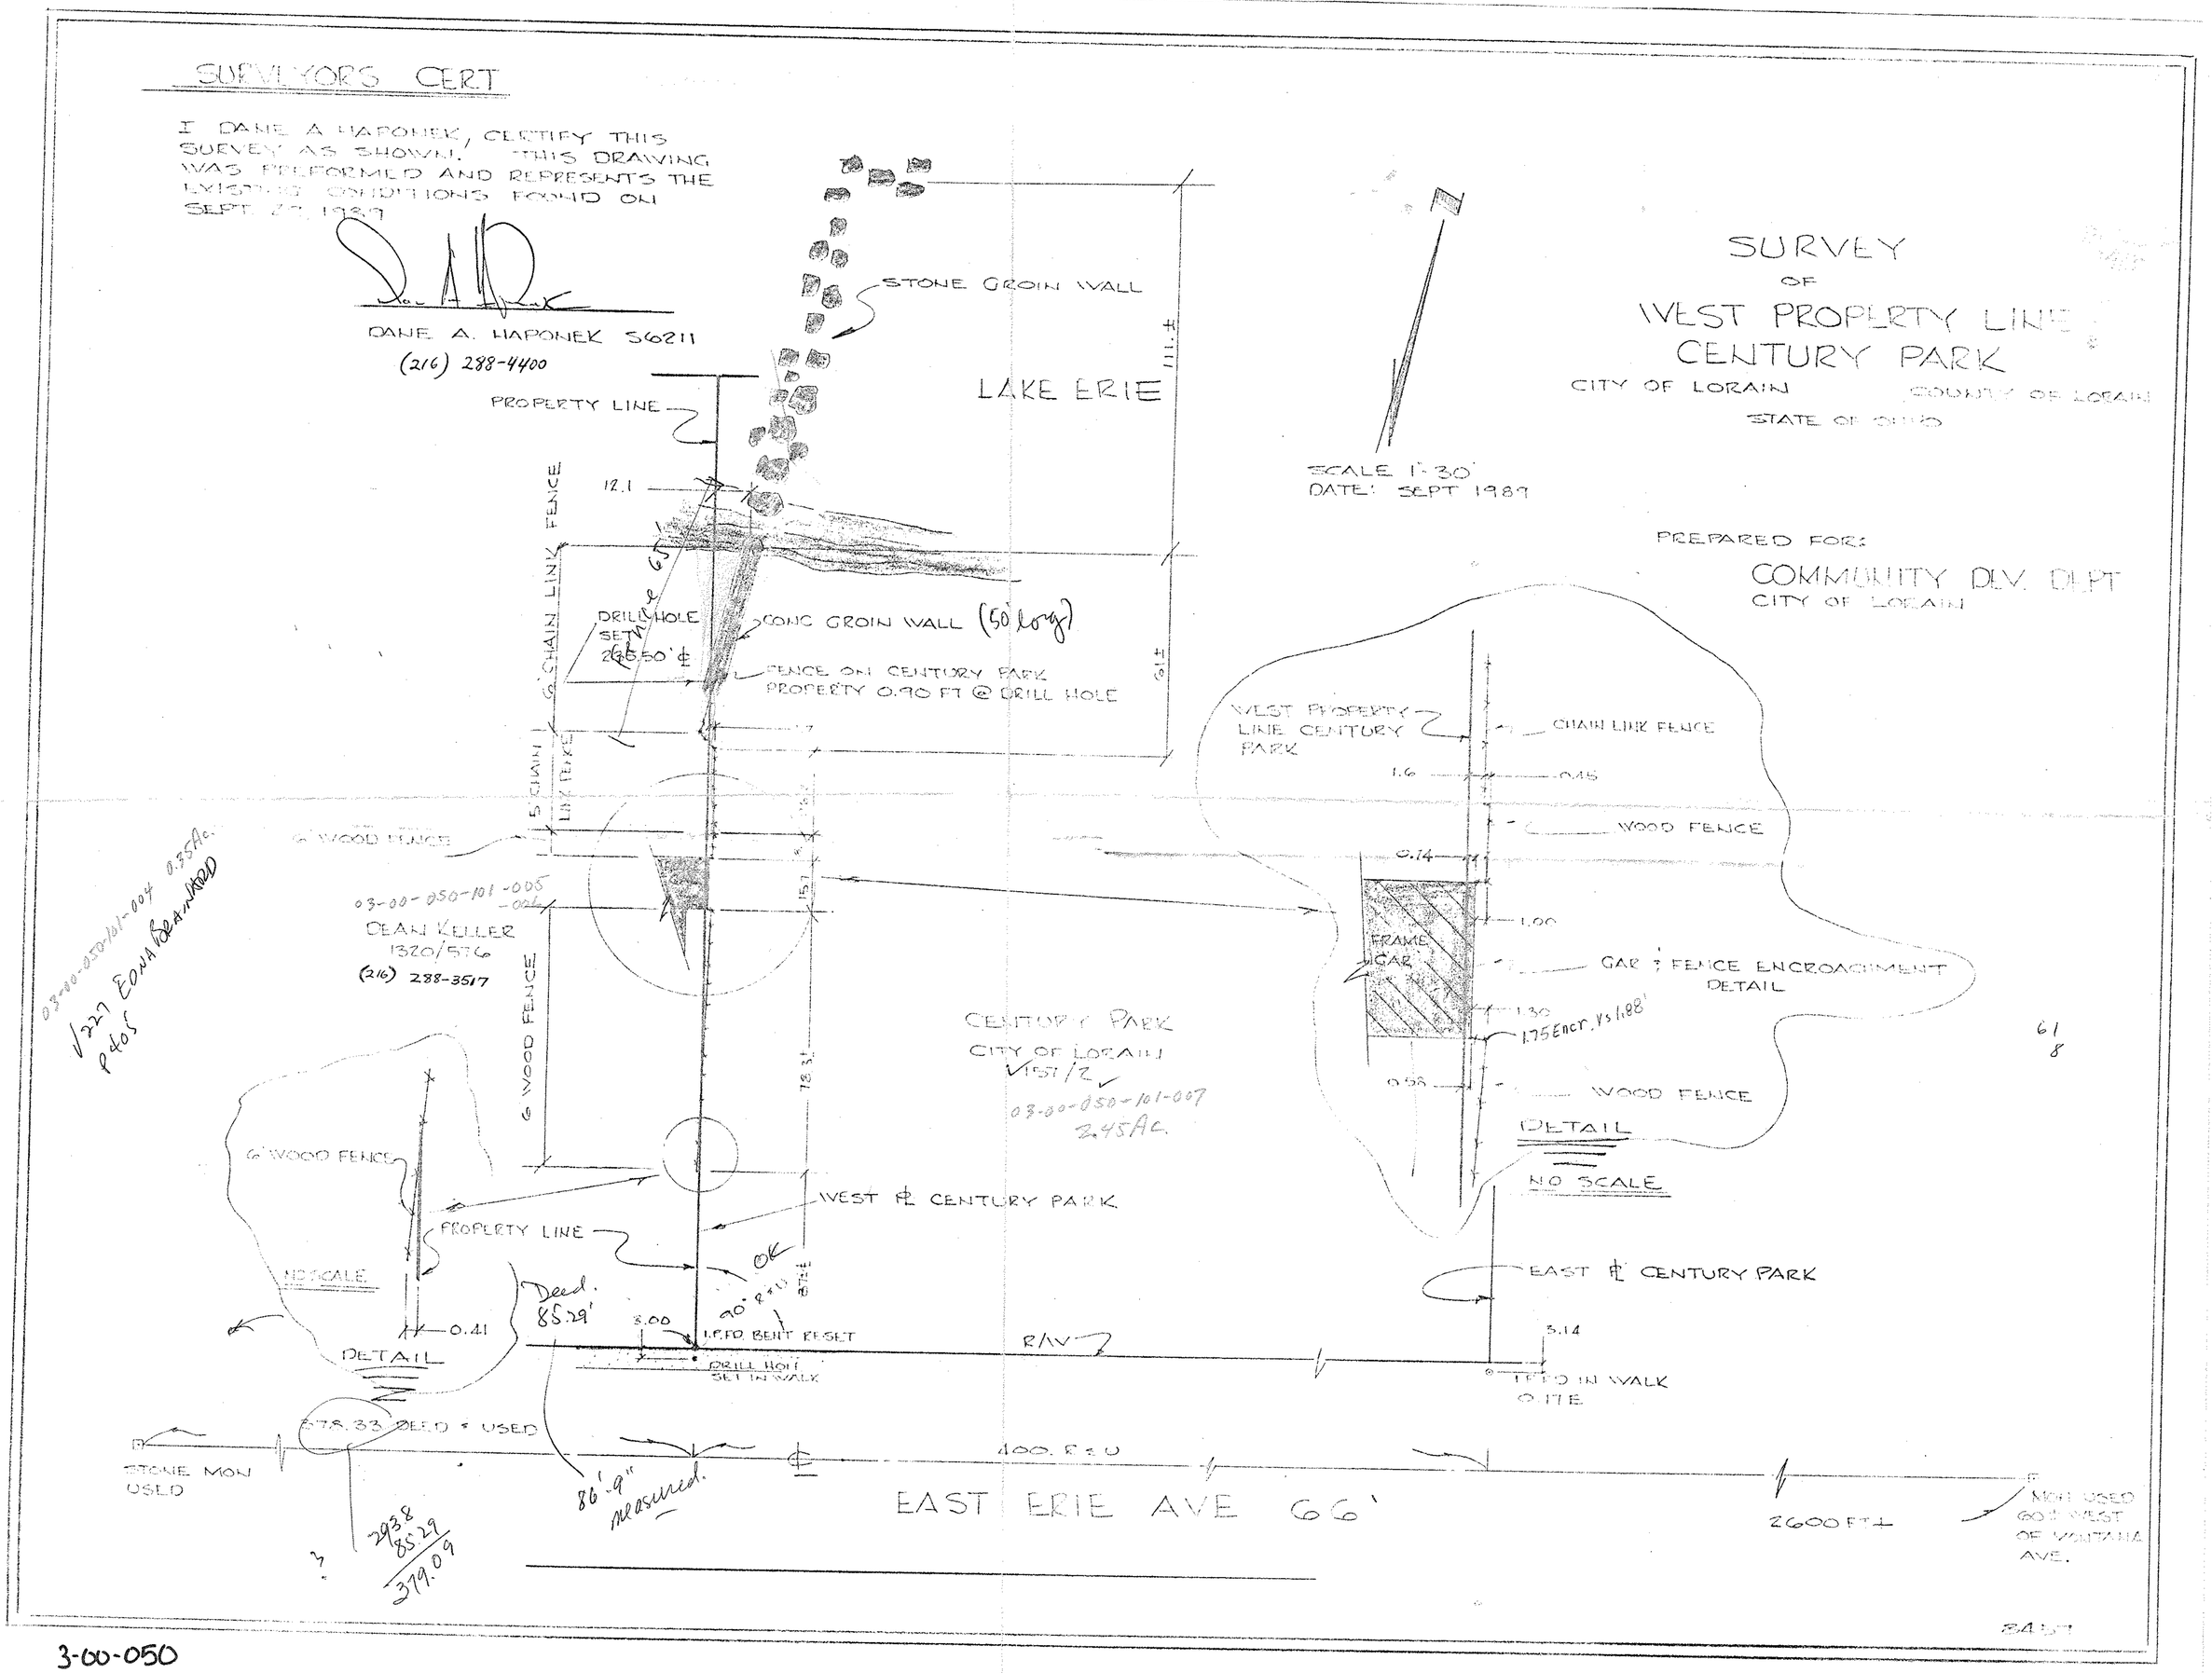
SURVEYORS CERT
I DANE A HAPONEK, CERTIFY THIS SURVEY AS SHOWN. THIS DRAWING WAS PREFORMED AND REPRESENTS THE EXISTING CONDITIONS FOUND ON SEPT. 27, 1989
DANE A. HAPONEK S6211
(216) 288-4400
SURVEY
OF
WEST PROPERTY LINE
CENTURY PARK
CITY OF LORAIN
COUNTY OF LORAIN
STATE OF OHIO
SCALE 1"=30'
DATE: SEPT 1989
PREPARED FOR:
COMMUNITY DEV. DEPT
CITY OF LORAIN
STONE GROIN WALL
LAKE ERIE
PROPERTY LINE
12.1
6' CHAIN LINK FENCE
DRILL HOLE SET
CONC GROIN WALL (50' long)
FENCE ON CENTURY PARK PROPERTY 0.90 FT @ DRILL HOLE
6' WOOD FENCE
03-00-050-101-005
DEAN KELLER
1320/576
(216) 288-3517
03-00-050-101-004 0.35Ac.
V227 EDNA BRANNARD
P405
CENTURY PARK
CITY OF LORAIN
V157/2
03-00-050-101-007
2.45Ac.
WEST PROPERTY LINE CENTURY PARK
CHAIN LINK FENCE
WOOD FENCE
FRAME GAR
GAR & FENCE ENCROACHMENT DETAIL
1.75 Encr. Vs 1.88'
WOOD FENCE
DETAIL
NO SCALE
WEST ℄ CENTURY PARK
EAST ℄ CENTURY PARK
PROPERTY LINE
NO SCALE
DETAIL
Deed. 85.29'
OK
90° R&U
I.P.FD. BENT RESET
DRILL HOLE SET IN WALK
R/W
I.P.FD IN WALK 0.17E
378.33 DEED & USED
STONE MON USED
86'-9" measured.
400. R&U
EAST ERIE AVE 66'
2600 FT±
MON USED 60' WEST OF MONTANA AVE.
293.8
85.29
379.09
61
8

3-00-050