


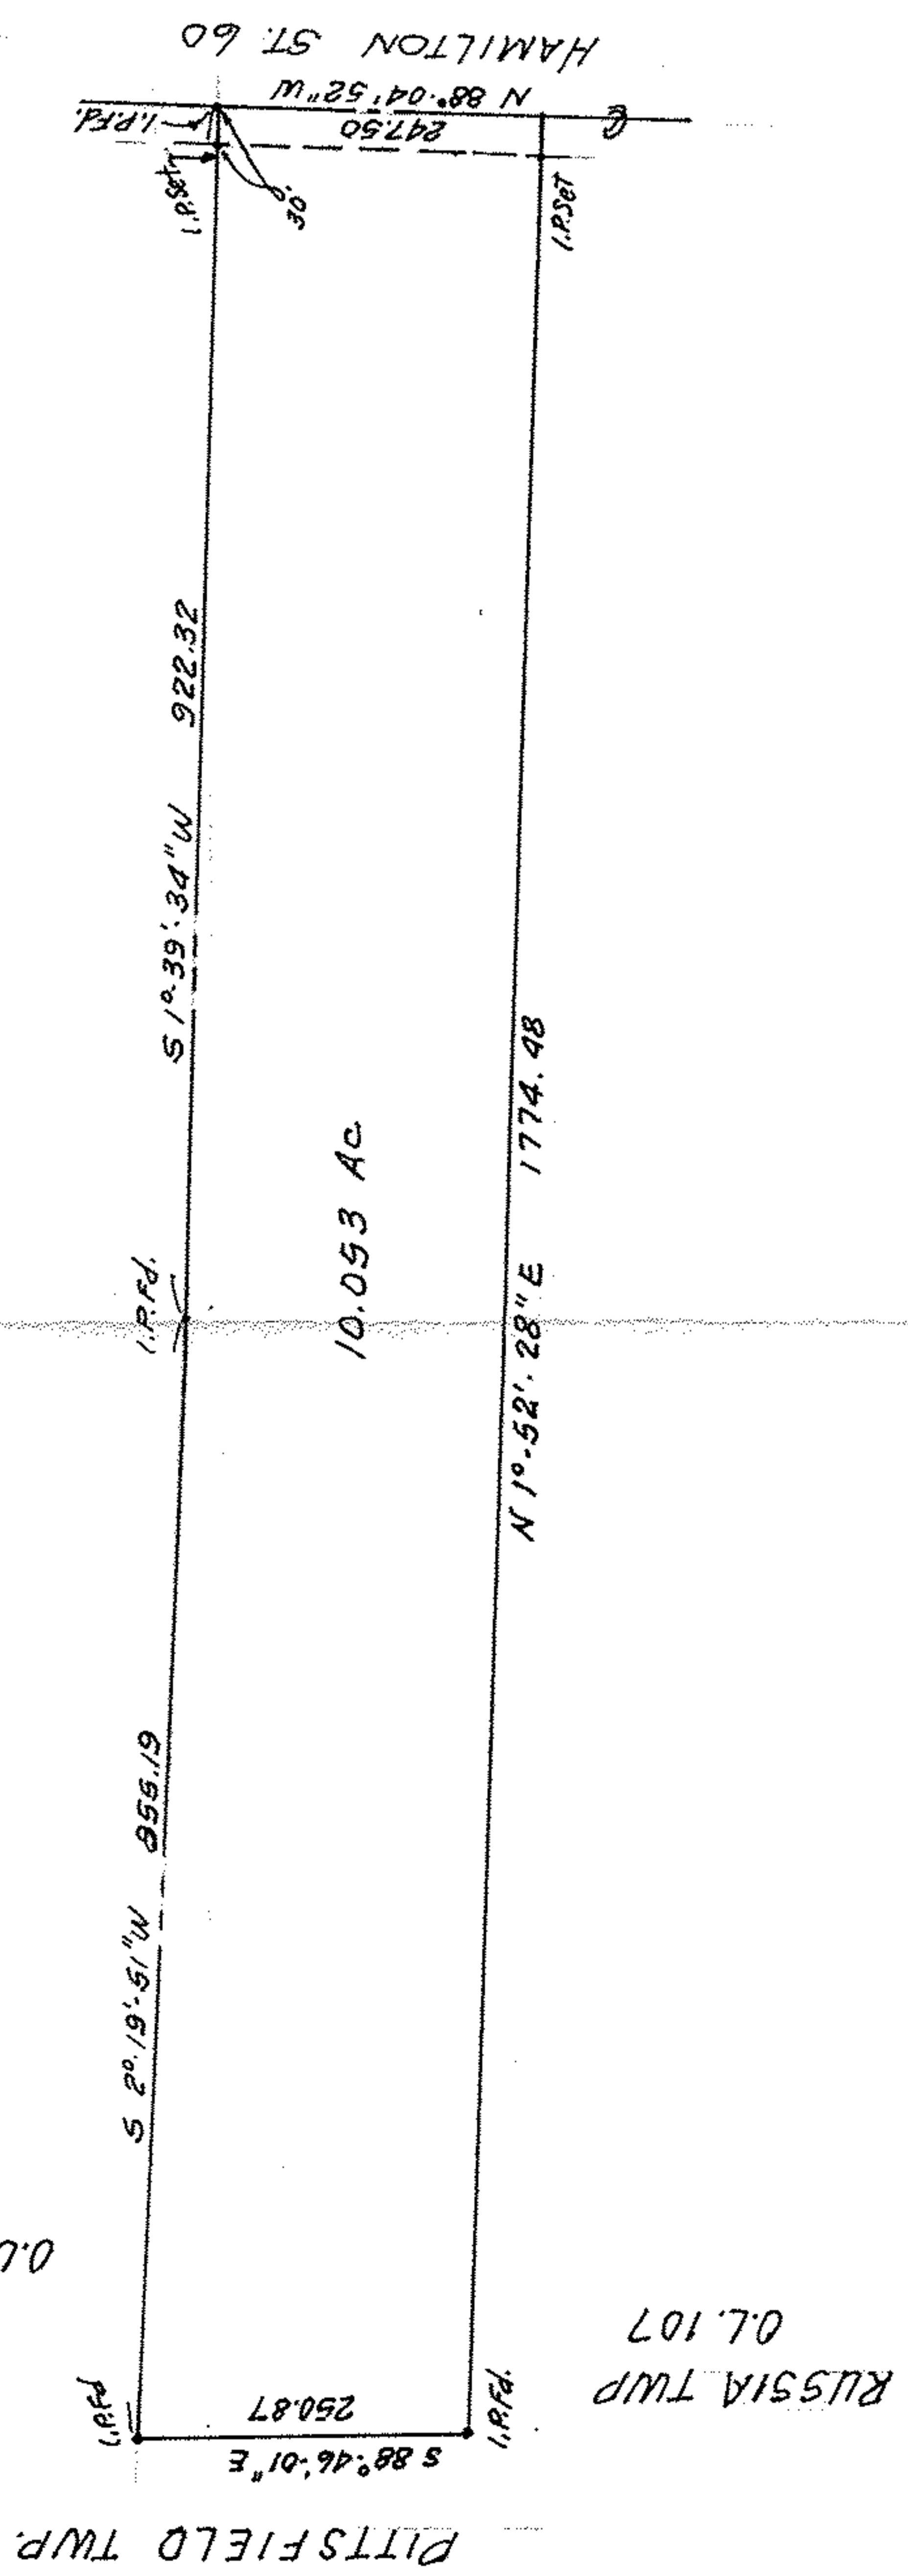

1" = 200'



MAP OF SURVEY for ALLEN & RUBY BAILEY
 P.P. # 09-00-107-000-001 - HARRY & BEULAH PHILLIPS VOL 1273 PG. 241
 PART OF ORIGINAL RUSSIA TWP LOT 107
 LORAIN COUNTY, OHIO

McCLINCHY & ASSOCIATES INC.
 REGISTERED SURVEYORS & ENGINEERS
 MARCH 1983 # 837615

09-00-107-000-001
 9-G