




WOODLAND AVENUE 66 FT.

5-33.00' W

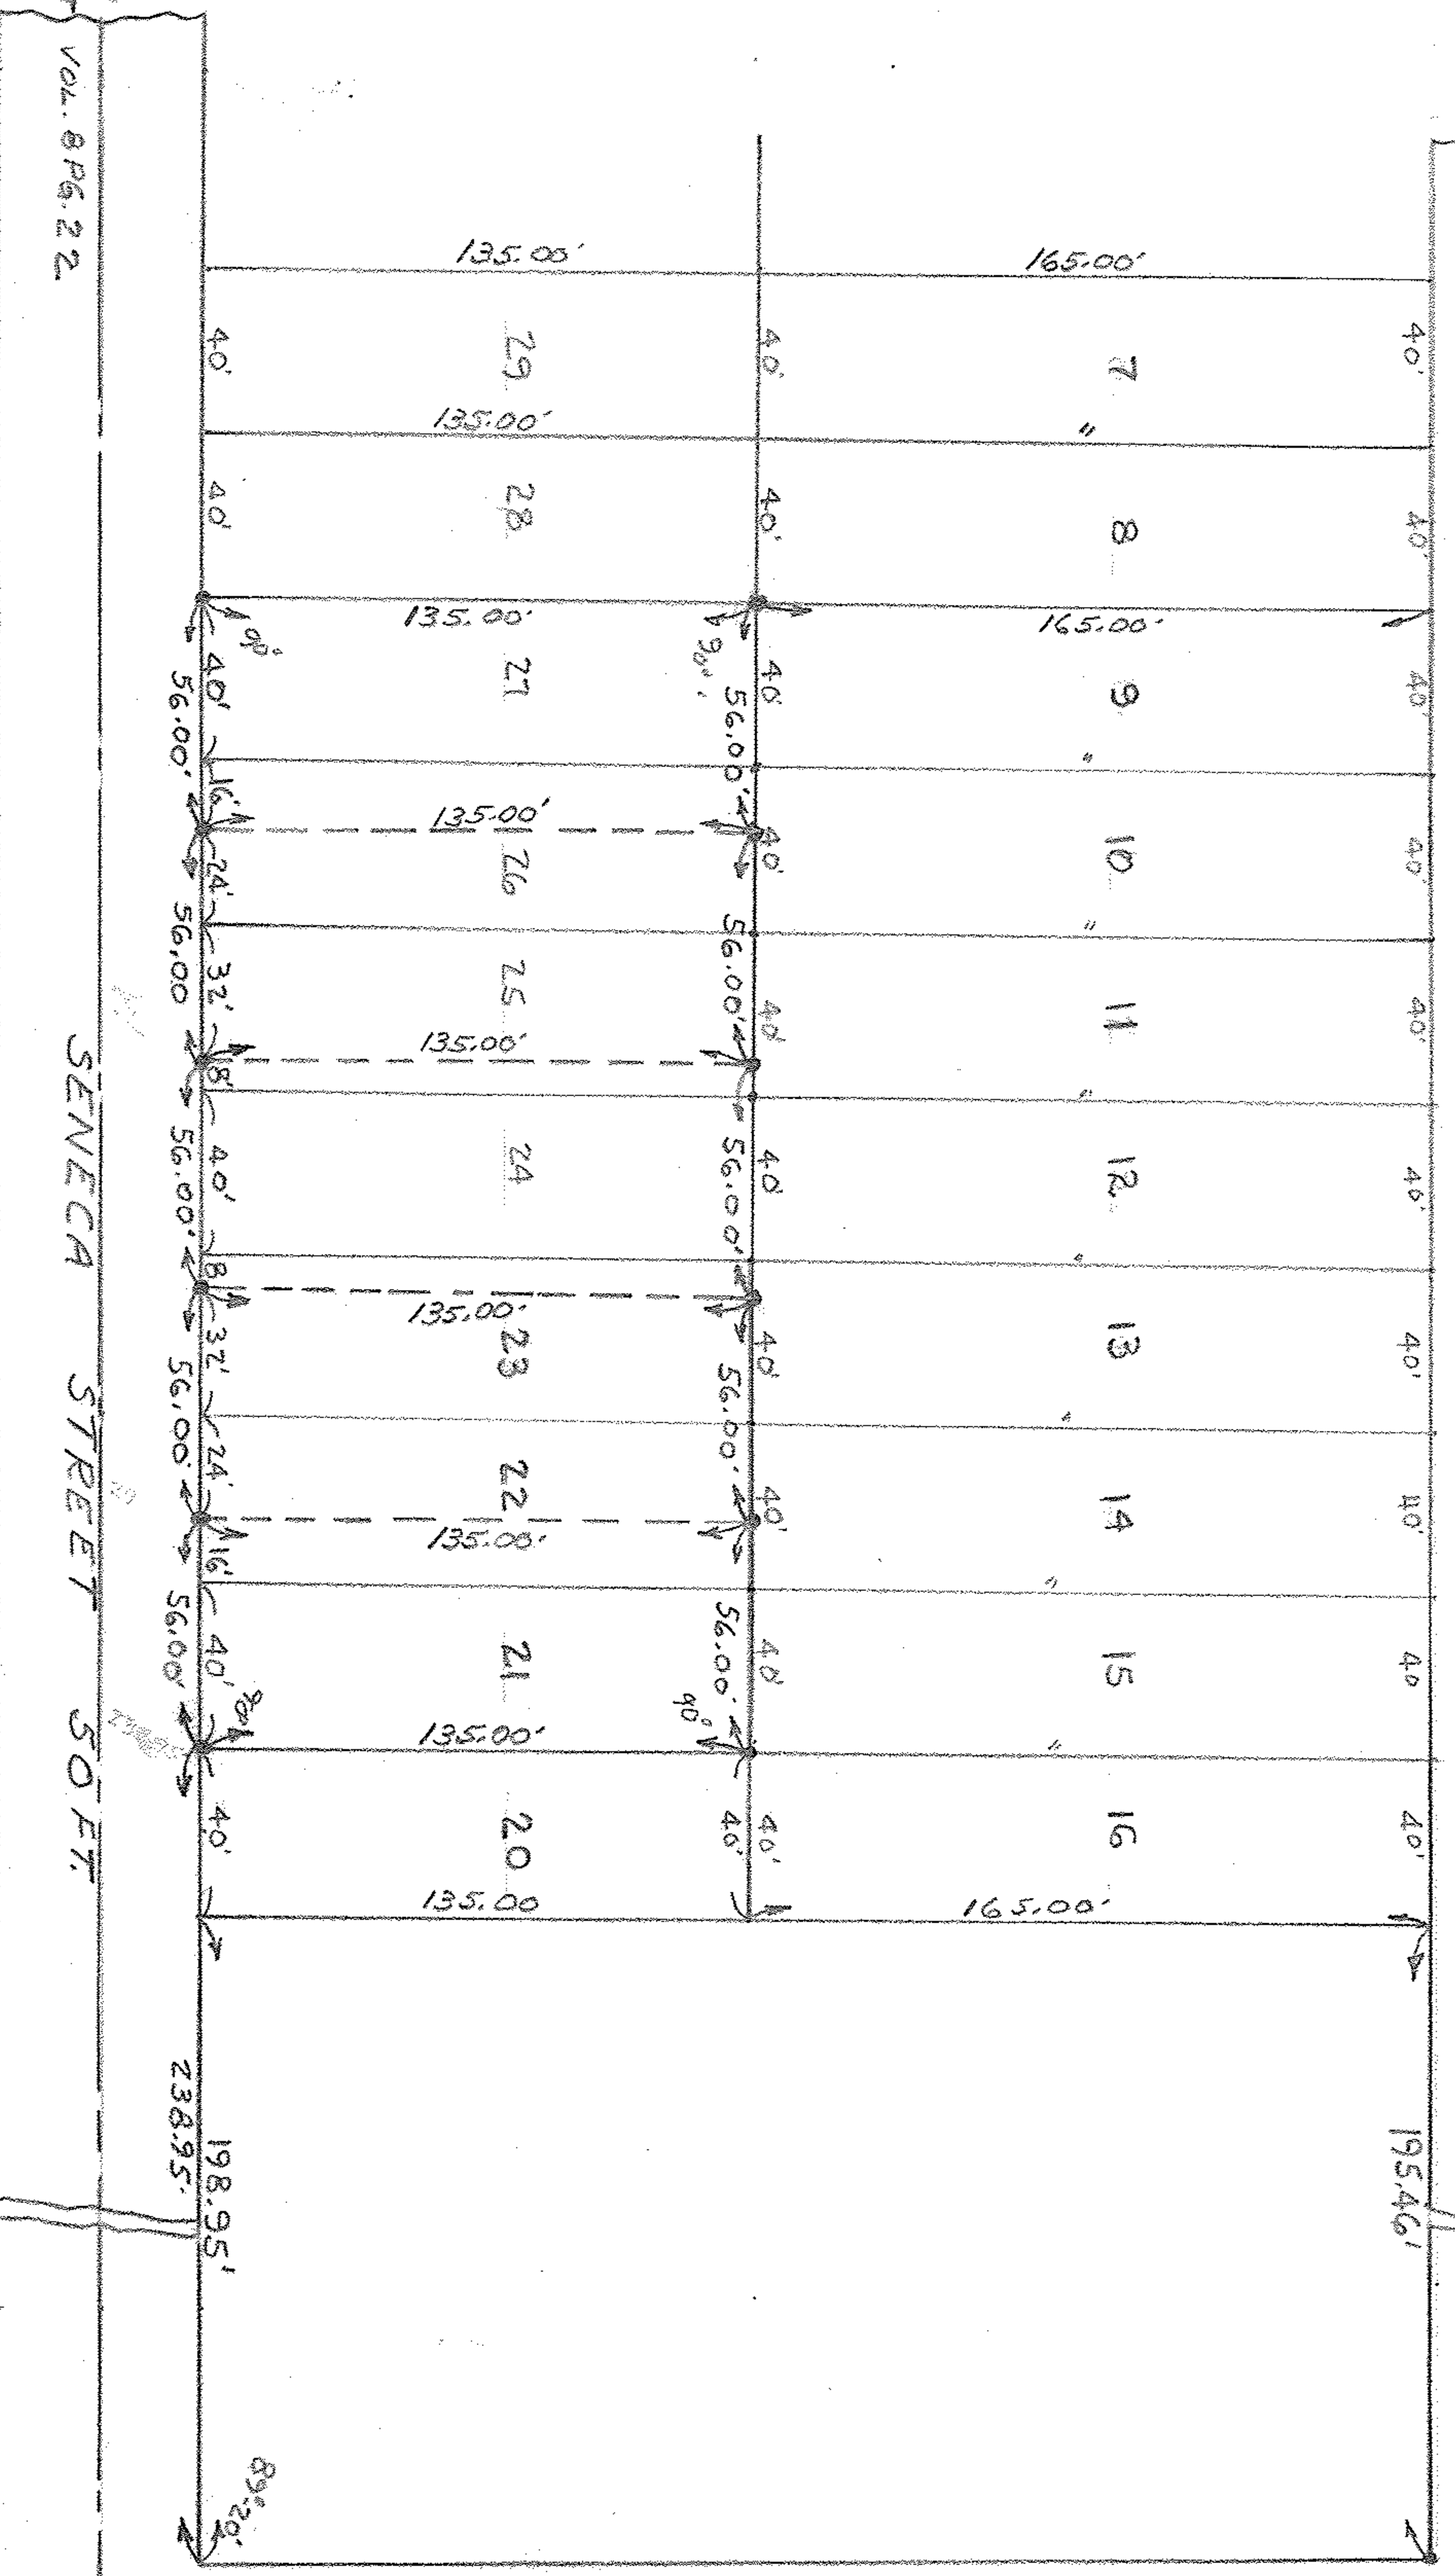

VOL. 8 PG. 22

SENECA STREET 50 FT.

OG-24-026-110-017 thru-021

6-97



OG-24-026